
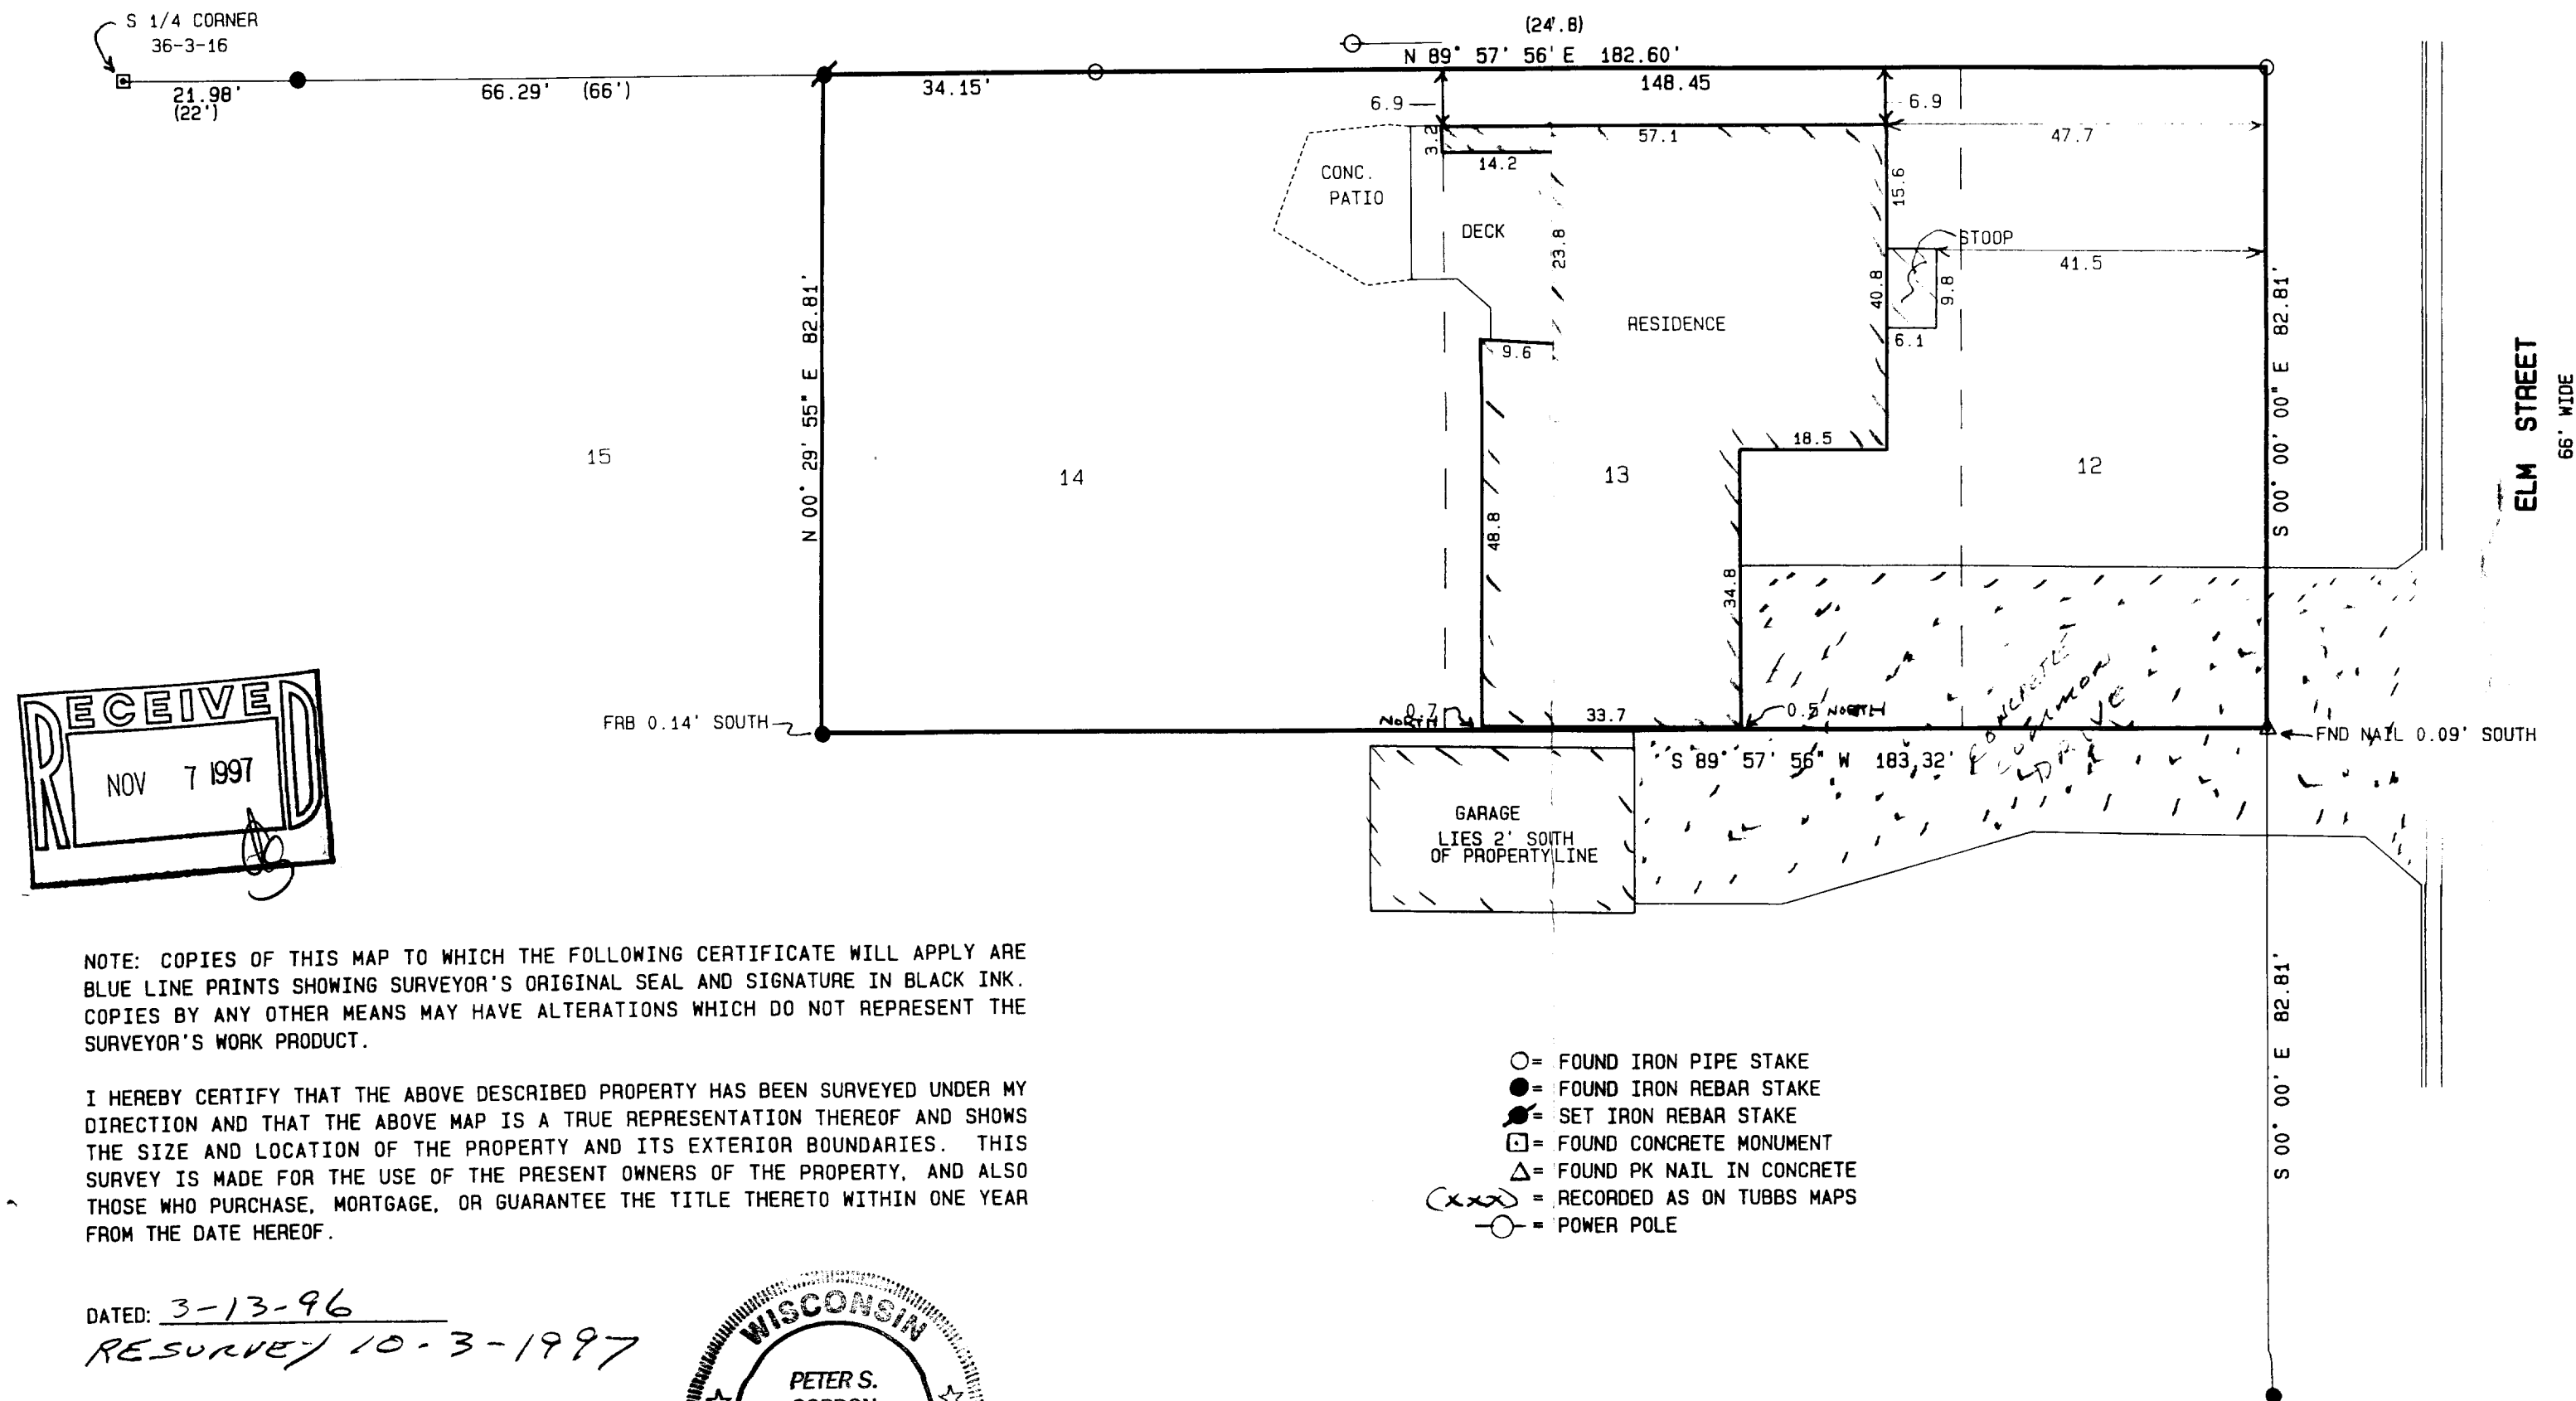


PLAT OF SURVEY
 THE NORTH 1/2 OF LOTS 12, 13, & 14
 BLOCK 1, HODGE'S ADDITION TO THE
 CITY OF ELKHORN
 WALWORTH COUNTY, WISCONSIN
 EXCEPTING THAT PORTION THEREOF OCCUPIED BY THE
 CONTINUANCE OF ELM STREET SOUTH

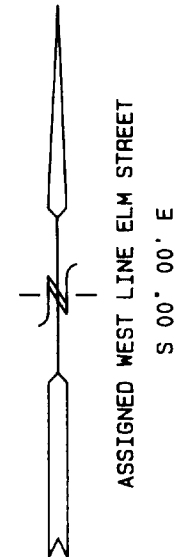

WORK ORDERED BY: MARY GOSTOMSKI
 REALTY CENTER
 32 S. WISCONSIN ST.
 ELKHORN, WISCONSIN 53121

FARRIS, HANSEN & ASSOCIATES, INC.
 Engineering, Architecture, Surveying
 7 Ridgway Court, P.O. Box 437
 ELKHORN, WISCONSIN 53121
 Office: (414) 723-2098
 Fax: (414) 723-5886

REVISIONS

PROJECT NO. 4489
DATE 03/13/96
SHEET NO. 1 OF 1

Y40-10
 064-1073