

# FARRIS, HANSEN, & ASSOCIATES, INC.


ENGINEERING, ARCHITECTURE, SURVEYING  
7 RIDGWAY COURT - P.O. BOX 437, ELKHORN, WISCONSIN, 53121  
PHONE: (414) 723-2098 FAX: (414) 723-5886

## PLAT OF SURVEY

### LOT 24 OF JACKSON CREEK SUBDIVISION




LOCATED IN PART OF THE SW 1/4 OF THE SW 1/4  
OF SECTION 7, TOWN 2 NORTH, RANGE 17 EAST,  
CITY OF ELKHORN, WALWORTH COUNTY, WISCONSIN

- WORK ORDERED BY -  
BROOKSTONE HOMES  
4450 MILTON AVENUE, SUITE 206  
JANESVILLE, WI. 53546

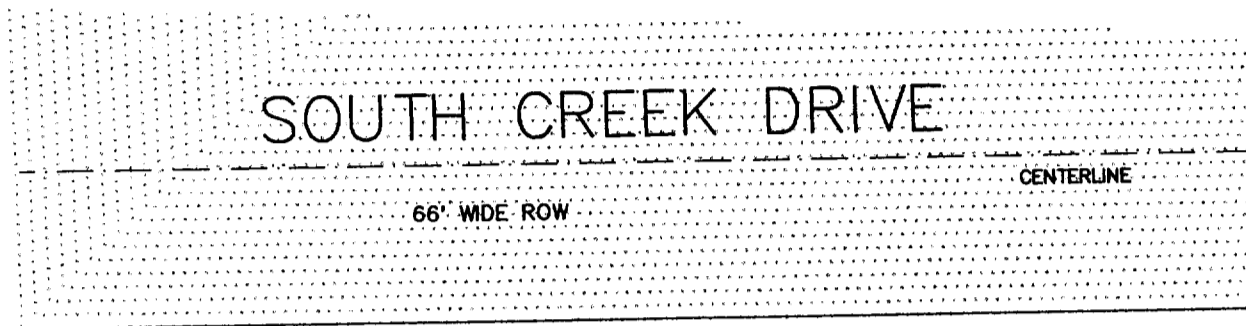

- = FOUND IRON REBAR STAKE
- = SET IRON REBAR STAKE
- = UTILITY CONTROL BOX

NOTE: NO CURB CUTS FOR DRIVEWAY ONTO  
SOUTH CREEK DRIVE ARE PRESENT ON  
DATE OF SURVEY

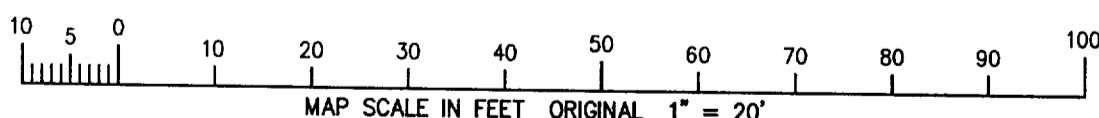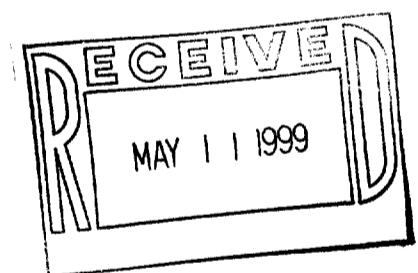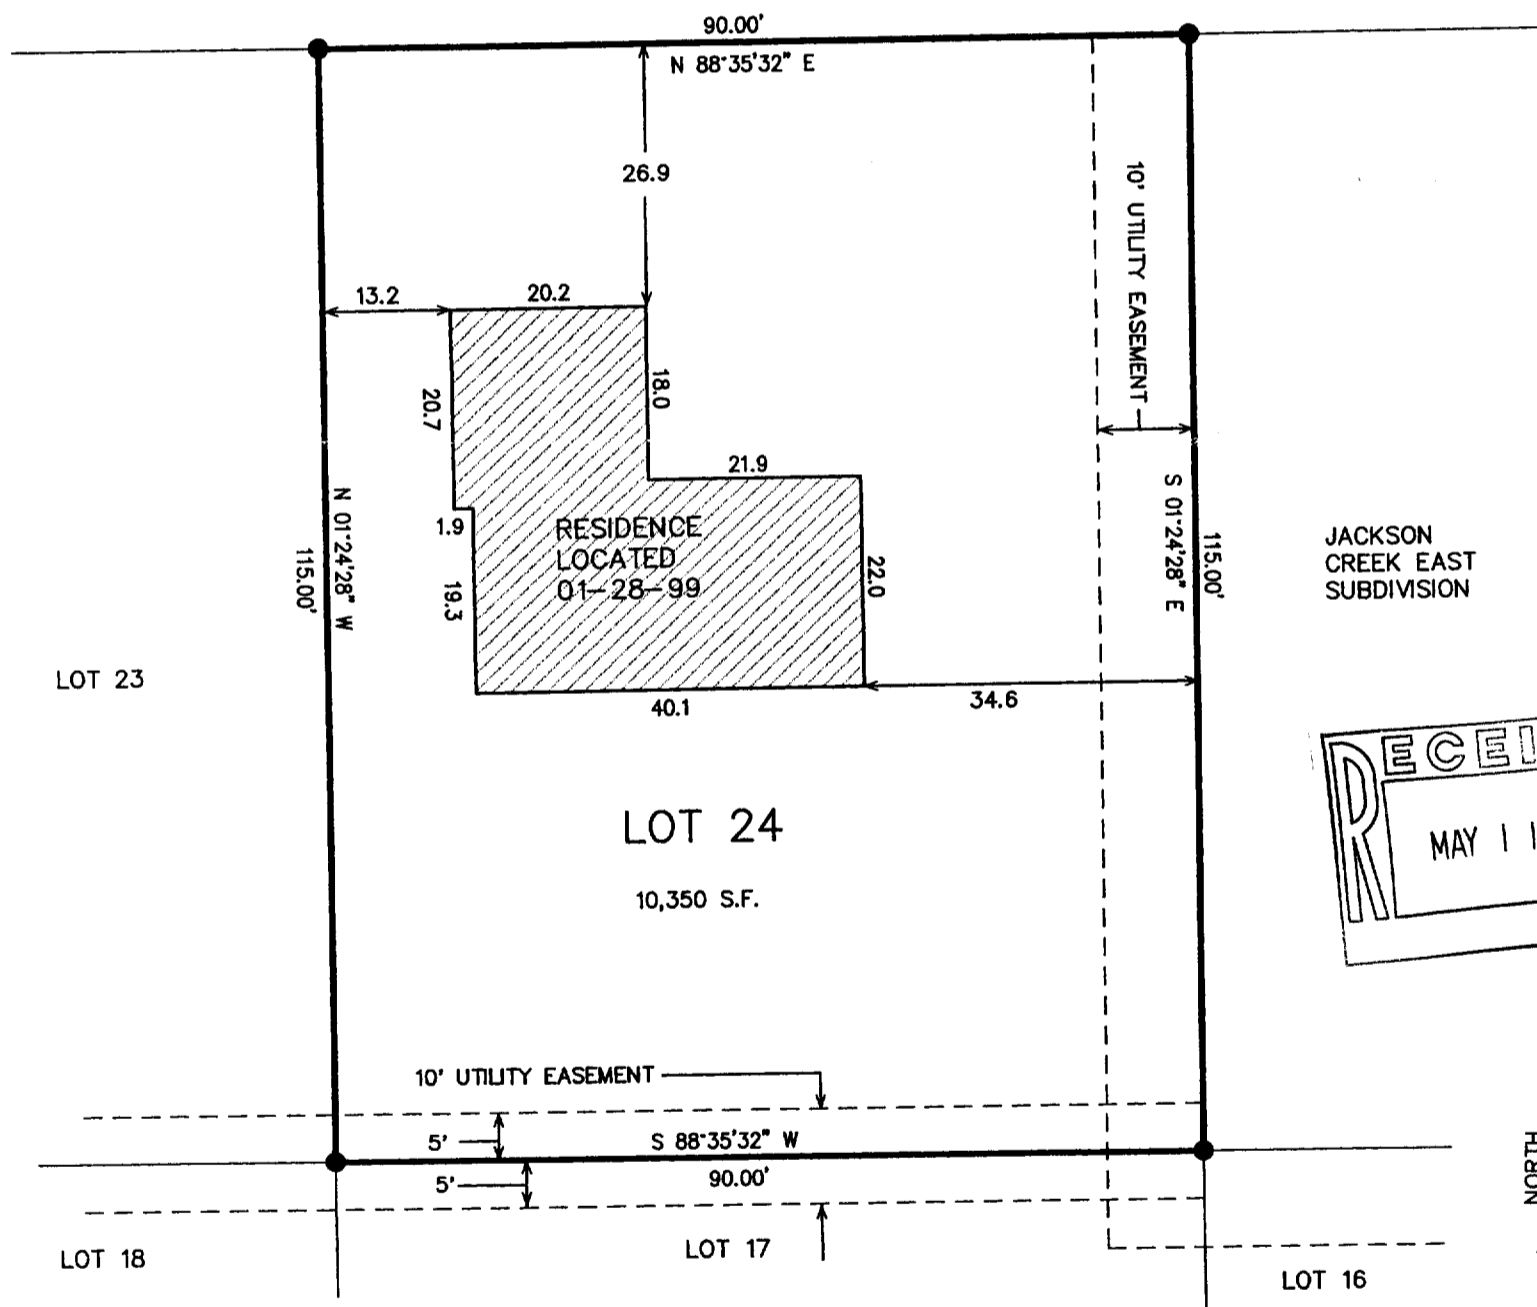


NOTE: COPIES OF THIS MAP TO WHICH THE FOLLOWING CERTIFICATE WILL APPLY SHOW  
SURVEYOR'S ORIGINAL SEAL AND SIGNATURE IN RED INK. COPIES BY ANY OTHER MEANS MAY HAVE ALTERATIONS  
WHICH DO NOT REPRESENT THE SURVEYOR'S WORK PRODUCT.

I HEREBY CERTIFY THAT THE ABOVE DESCRIBED PROPERTY HAS BEEN SURVEYED UNDER MY DIRECTION AND THAT THE  
ABOVE MAP IS A TRUE REPRESENTATION THEREOF AND SHOWS THE SIZE AND LOCATION OF THE PROPERTY AND ITS  
EXTERIOR BOUNDARIES. THIS SURVEY IS MADE FOR THE USE OF THE PRESENT OWNERS OF THE PROPERTY, AND  
ALSO THOSE WHO PURCHASE, MORTGAGE, OR GUARANTEE THE TITLE THERETO WITHIN ONE YEAR FROM THE DATE  
HEREOF.

DATED: 03-22-99

PETER S. GORDON R.L.S. 2101

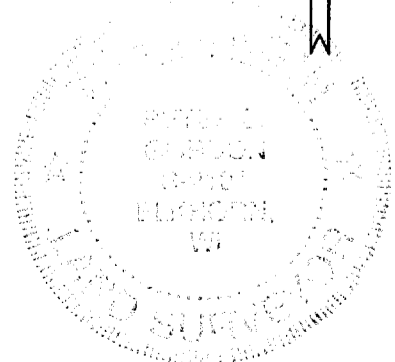

PROJECT 4055.24  
DATE: 01/29/1999  
SHEET 1 OF 1

YJC-24 004-1145