



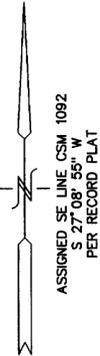


PLAT OF SURVEY

LOT 2 OF CERTIFIED SURVEY MAP NO. 1092
REC. IN VOL. 5 ON PG. 94
LOCATED IN THE NW 1/4 SEC. 6
TOWN 2 NORTH, RANGE 17 EAST
CITY OF ELKHORN
WALWORTH COUNTY, WISCONSIN

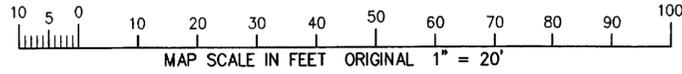


ASSIGNED SE LINE CSM 1092
S 27°08'56\"/>

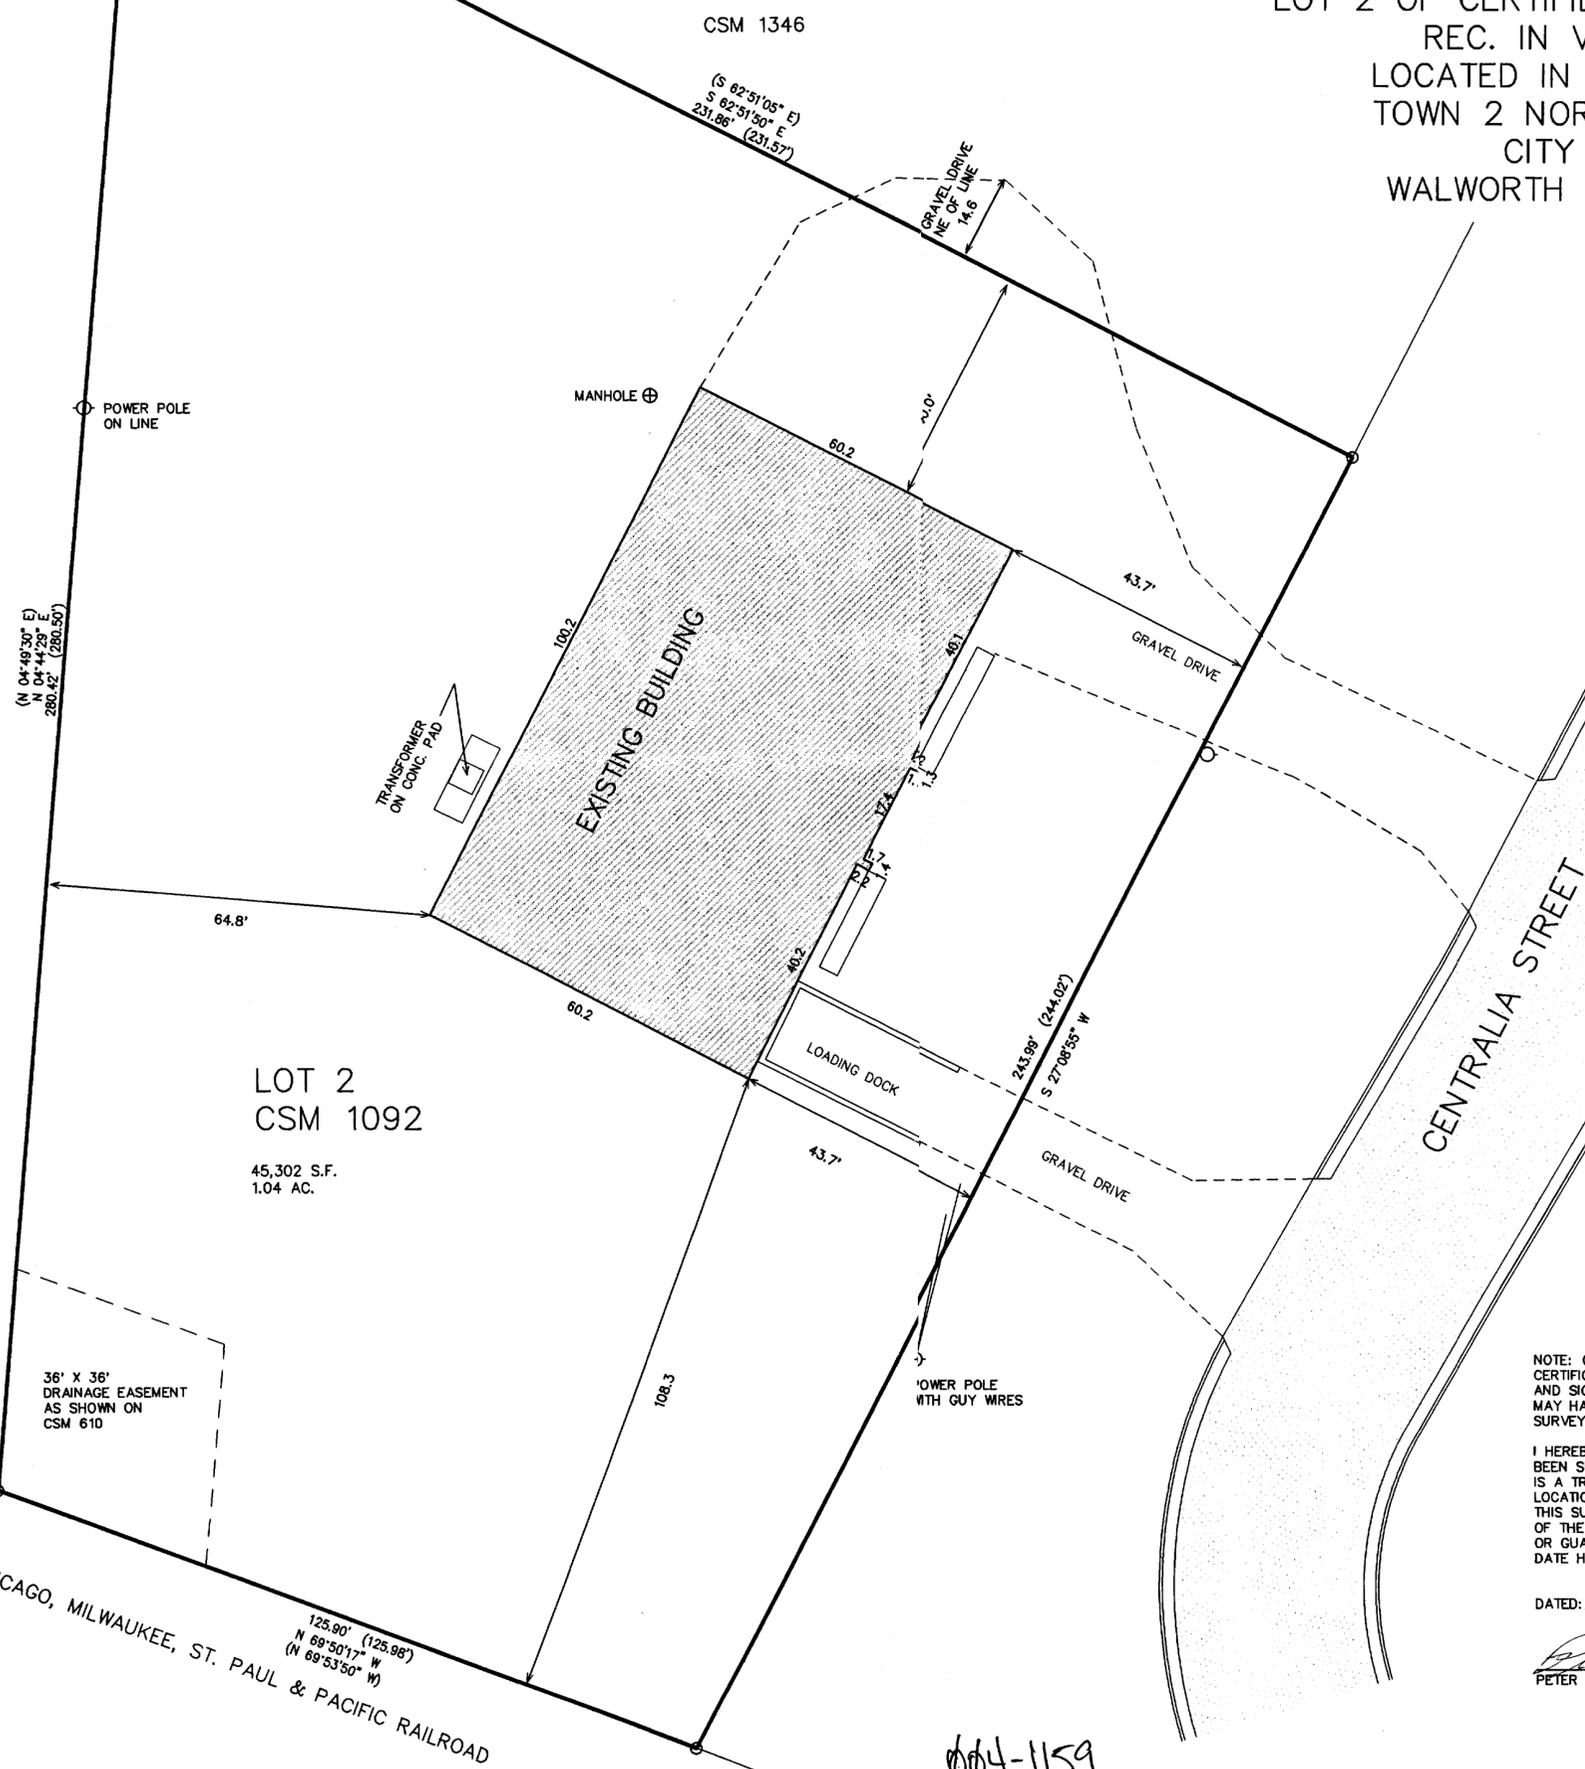

LOT 2
CSM 1092
45,302 S.F.
1.04 AC.

36' X 36'
DRAINAGE EASEMENT
AS SHOWN ON
CSM 610


CHICAGO, MILWAUKEE, ST. PAUL & PACIFIC RAILROAD
125.90' (125.98')
N 69°50'17\"/>

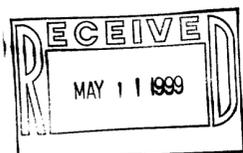

NOTE: COPIES OF THIS MAP TO WHICH THE FOLLOWING
CERTIFICATE WILL APPLY SHOW SURVEYOR'S ORIGINAL SEAL
AND SIGNATURE IN RED INK. COPIES BY ANY OTHER MEANS
MAY HAVE ALTERATIONS WHICH DO NOT REPRESENT THE
SURVEYOR'S WORK PRODUCT.

I HEREBY CERTIFY THAT THE ABOVE DESCRIBED PROPERTY HAS
BEEN SURVEYED UNDER MY DIRECTION AND THAT THE ABOVE MAP
IS A TRUE REPRESENTATION THEREOF AND SHOWS THE SIZE AND
LOCATION OF THE PROPERTY AND ITS EXTERIOR BOUNDARIES.
THIS SURVEY IS MADE FOR THE USE OF THE PRESENT OWNERS
OF THE PROPERTY, AND ALSO THOSE WHO PURCHASE, MORTGAGE,
OR GUARANTEE THE TITLE THERETO WITHIN ONE YEAR FROM THE
DATE HEREOF.

DATED: 3/26/99
Peter S. Gordon
PETER S. GORDON R.L.S. 2101

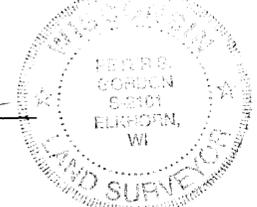

WORK ORDERED BY:
WILLIAM SEYMOUR
PO BOX 470
ELKHORN, WI. 53121

FARRIS, HANSEN & ASSOCIATES, INC
Engineering, Architecture, Surveying
7 Ridgway Court P.O. Box 437
ELKHORN, WISCONSIN 53121
Office: (414) 723-2098
Fax: (414) 723-5886

REVISIONS	

PROJECT NO.	5250
DATE:	03-26-99
SHEET NO.	1 OF 1

MAR 26 1999

YA-1092-2

004-1159