


1140 SEQUOIA STREET • DELAVAN, WISCONSIN 53115
262-728-6737

SAILOR	33 FEET WIDE	STREET
	140.80'	(132') [133.5']

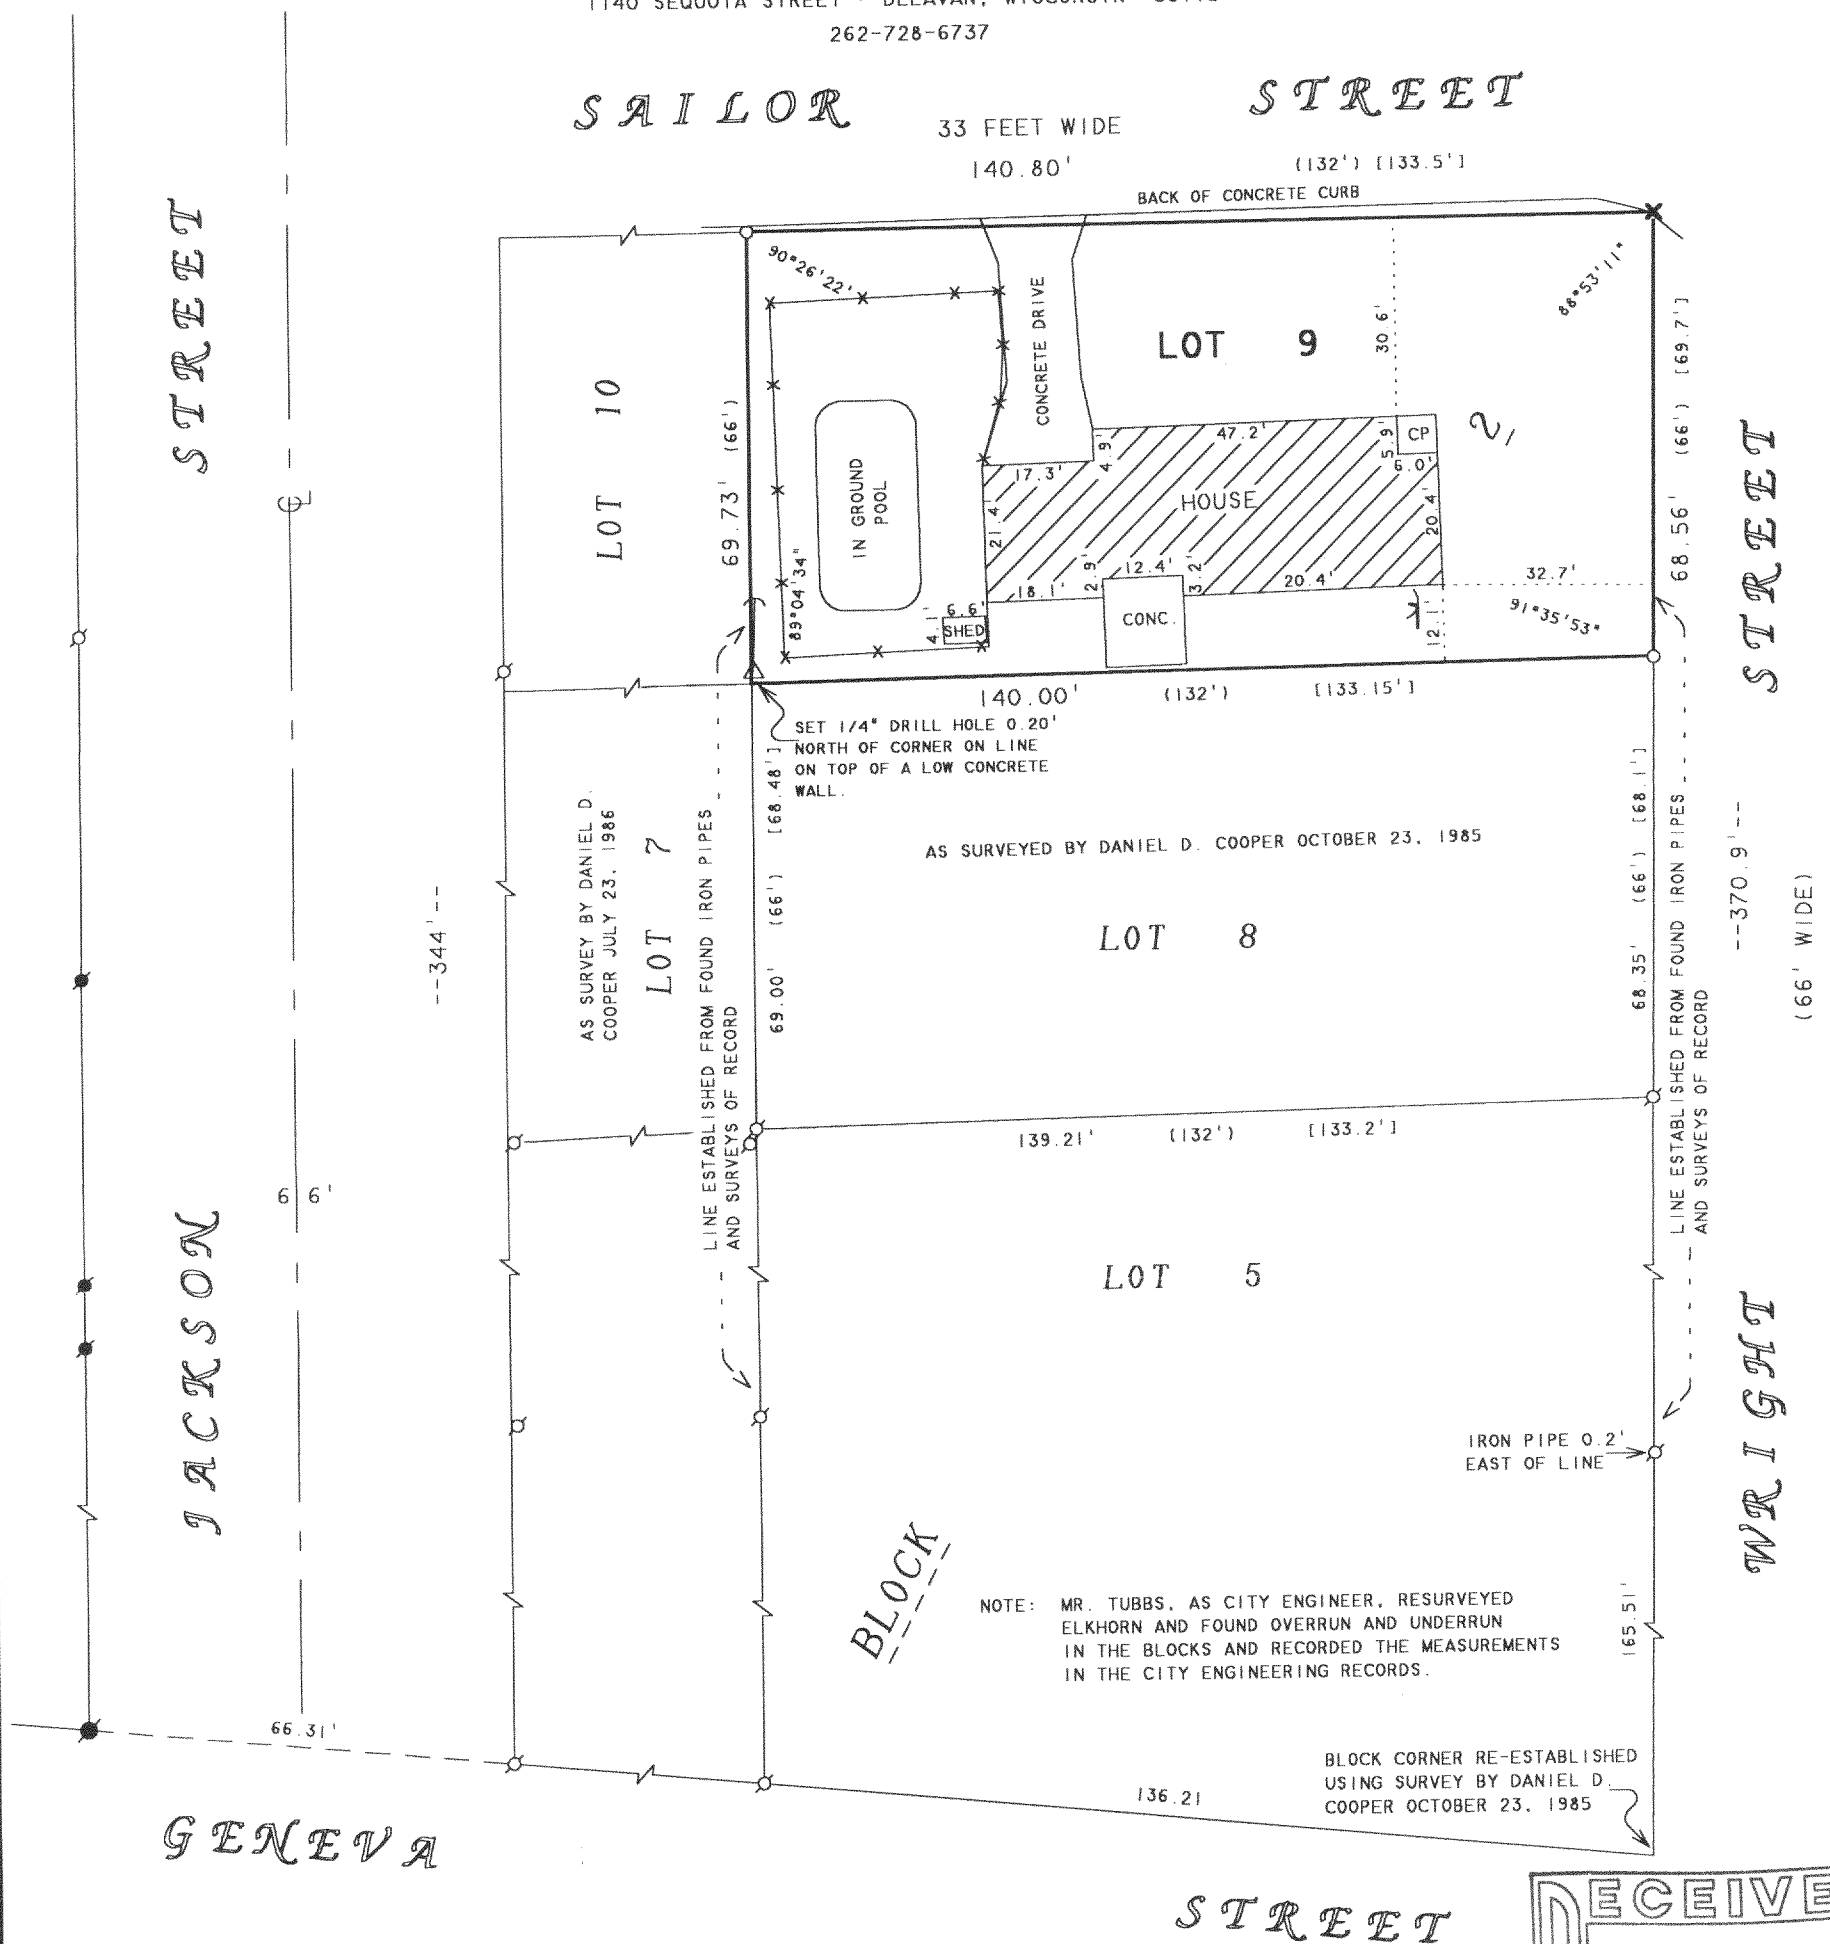

ORDERED BY: RE/MAX-LAKES AREA REALTORS
1815 N. SHORE DRIVE
DELAVER, WI. 53115

PLAT OF SURVEY OF

LOT 9, BLOCK 2, ARNOLD'S ADDITION TO THE
CITY OF ELKHORN, WALWORTH COUNTY, WISCONSIN.

I HEREBY CERTIFY THAT I HAVE SURVEYED THE ABOVE DESCRIBED PROPERTY AND THAT THE ABOVE MAP IS A TRUE REPRESENTATION THEREOF AND SHOWS THE SIZE AND LOCATION OF THE PROPERTY, ITS EXTERIOR BOUNDARIES, THE LOCATION OF ALL VISIBLE STRUCTURES AND DIMENSIONS OF ALL PRINCIPAL BUILDINGS THEREON, BOUNDARY FENCES, APPARENT EASEMENTS, ROADWAYS AND VISIBLE ENCROACHMENTS, IF ANY, TO THE BEST OF MY KNOWLEDGE AND BELIEF.

THIS SURVEY IS MADE FOR THE USE OF THE PRESENT OWNERS OF THE PROPERTY, AND ALSO THOSE WHO PURCHASE, MORTGAGE, OR GUARANTEE THE TITLE THERETO WITHIN ONE (1) YEAR FROM DATE HEREON.

DAVID F. ABELL
WISCONSIN REGISTERED LAND SURVEYOR. S-1596

April 26, 2000

DATE _____ JOB NUMBER - 00047
NOTE: THIS IS NOT A CERTIFIED COPY UNLESS SEALED.

SCALE 1" = 30'

LEGEND

-  -IRON PIPE FOUND
 -IRON ROD FOUND
 -IRON BAR FOUND
 -1" DIA. IRON PIPE SET
 -CROSS CUT ON CONCRETE SIDEWALK SET
 -WOOD FENCE
 -CONCRETE PORCH
 -UTILITY POLE
 -GIY WIRE
 -TV SATELLITE ANTENNA

{ }-RECORDED AS
[]-AS SHOWN IN CITY ENGINEERING RECORDS

YAB-15A

004-1238