


46-17

10421

57

N. LINCOLN

66'

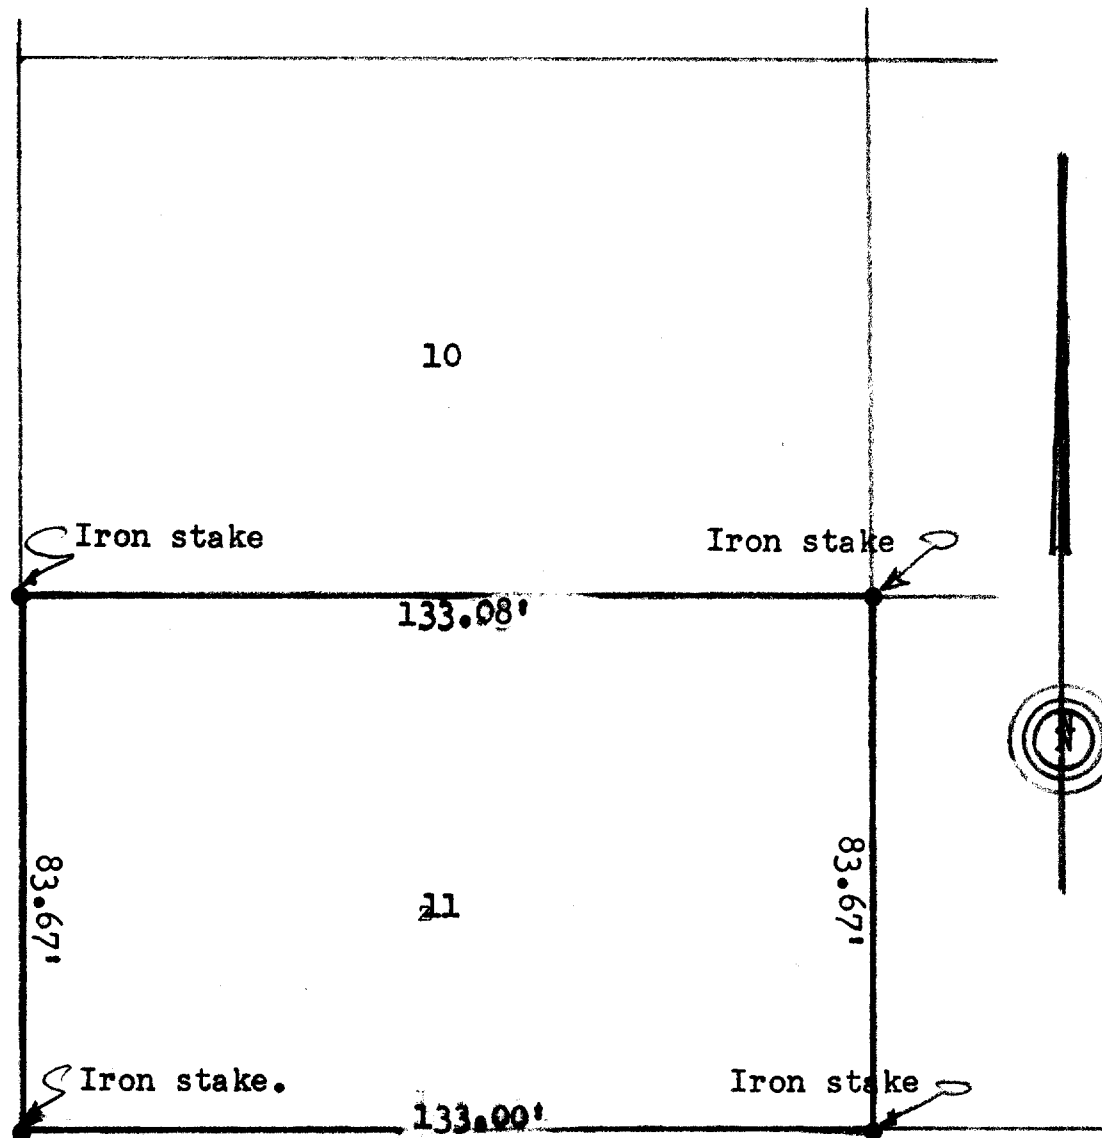

E.

JEFFERSON

ST

Description: Lot 11 Block 12, Original Plat of the City of Elkhorn, Walworth County, Wisconsin.

Certificate: I, hereby certify that I have on this the 10th day of August 1946. surveyed the above described property.  
SIGNED AND SEALED THIS 12TH DAY OF AUGUST 1946.

*Joseph M. Biagi*  
Joseph M. Biagi  
Professional Engineer.  
Elkhorn Wisconsin.