


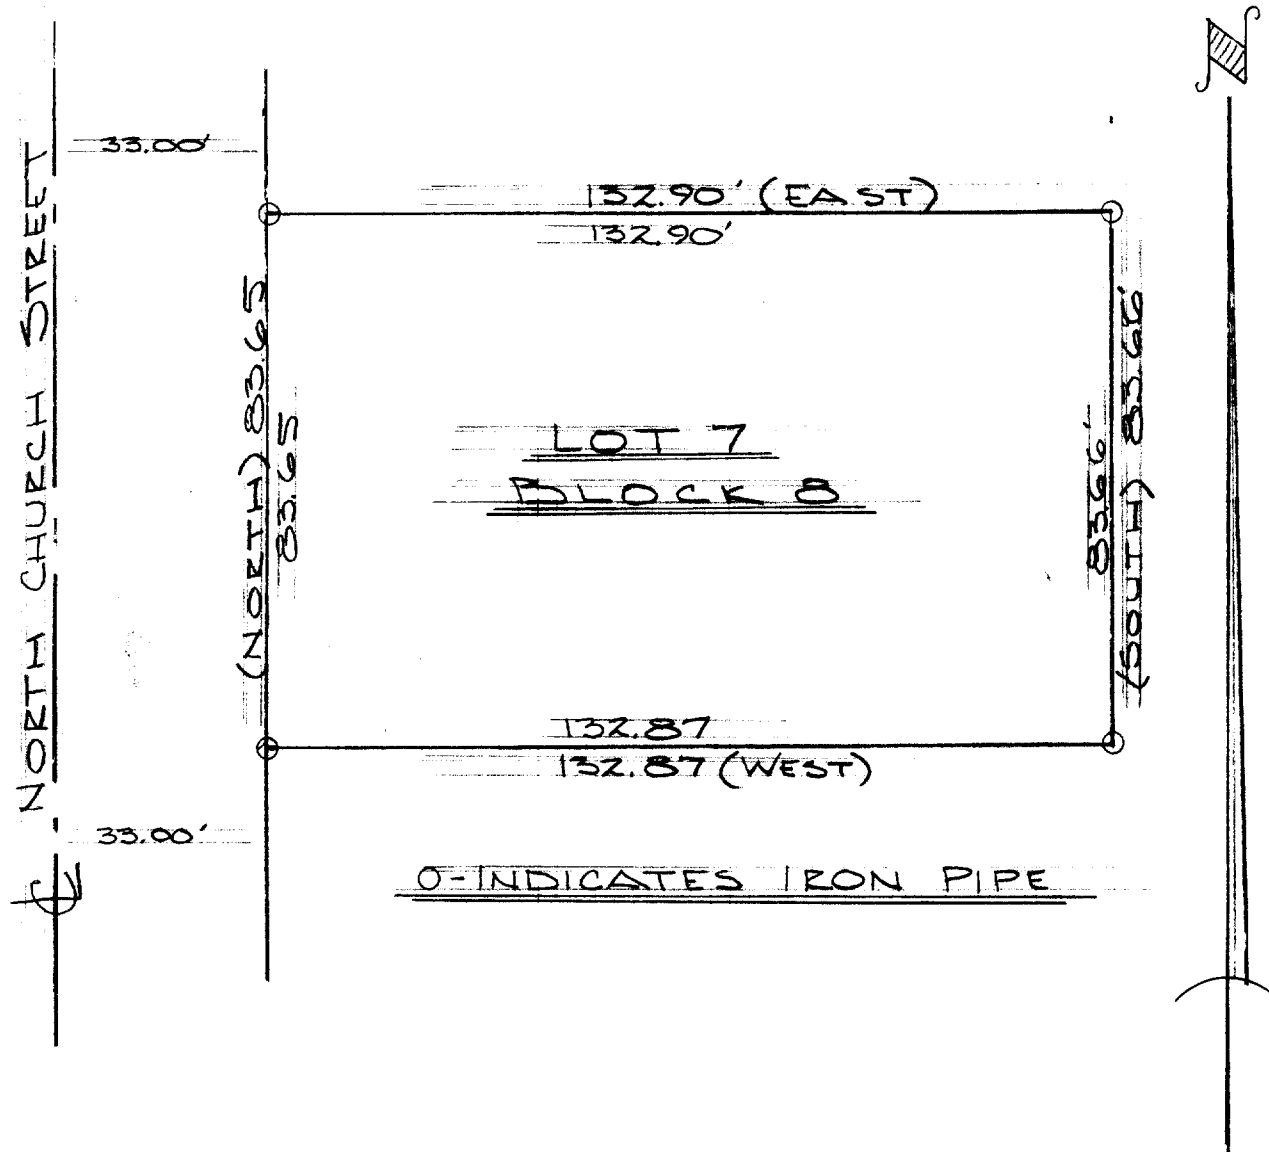

DESCRIPTION: Lot 7 of Block 8 of the Original Plat of the City of Elkhorn, Walworth County, Wisconsin.

CERTIFICATE: I, James F. Biagi, surveyor, do hereby certify that I have surveyed the property hereon described.

January 25, 1967.

James F. Biagi RLS 272

