
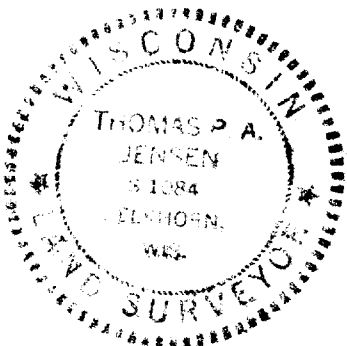


PLAT OF SURVEY

OF

LOT 5 BIV A FAIRLANE SUB. ADDN 40.1
 MAP OF CH. 31, TEN RITE, CITY OF
 ELKHORN, WIS. CO. WIS.

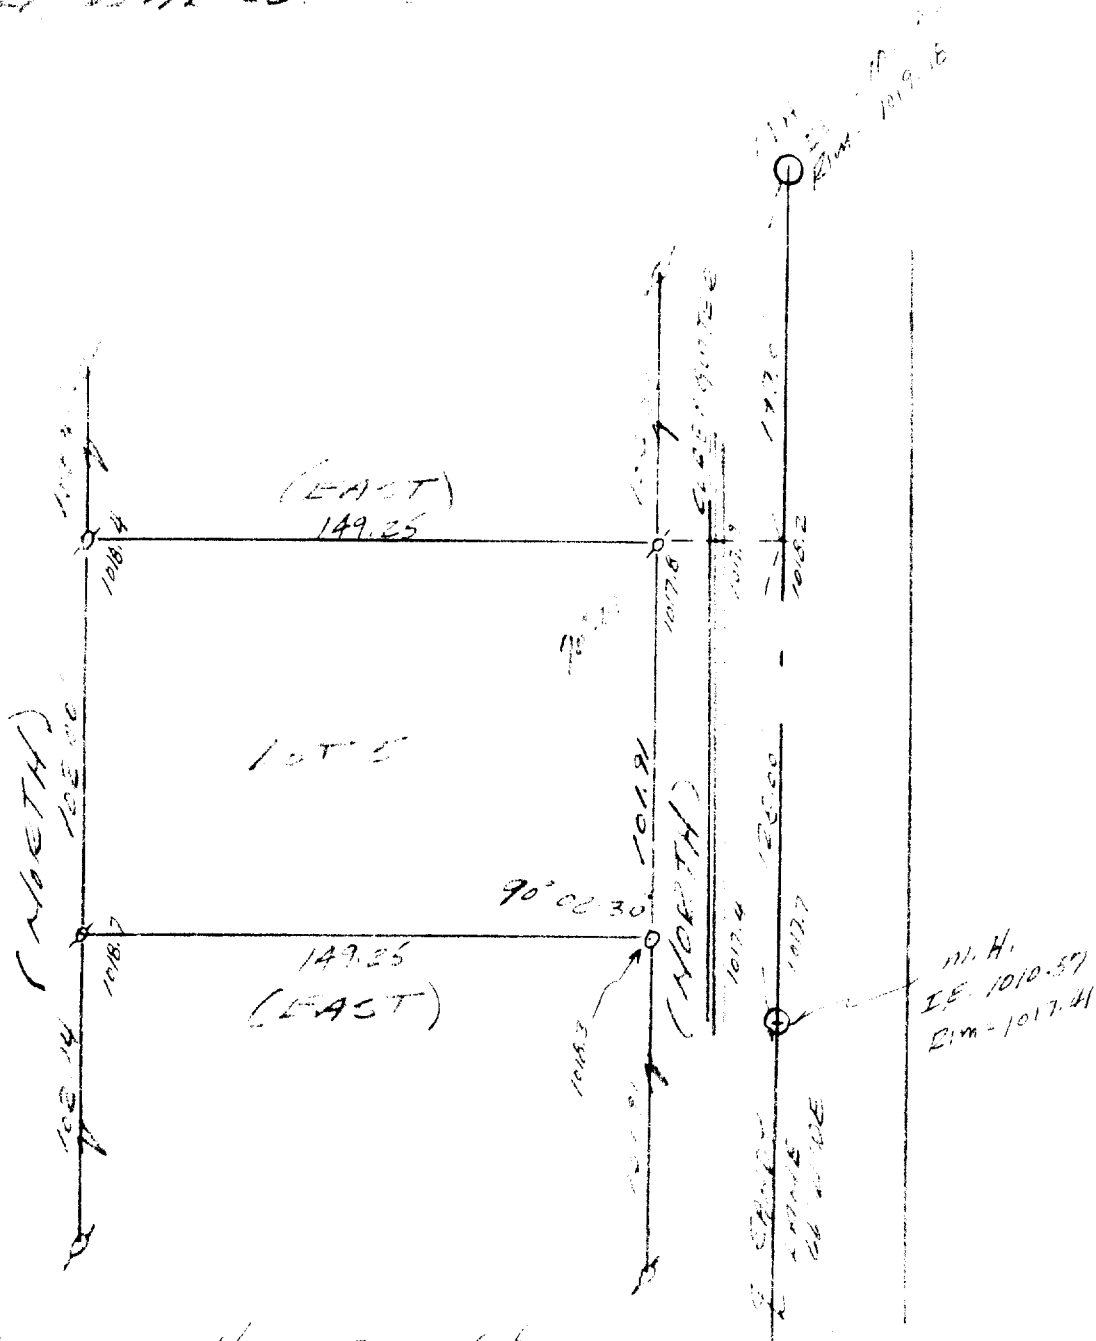

HOUSE 2ND LOT
 SOUTH OF LOT 5
 FLOOR = 1021.20

SURVEY AND PLAT BY

JENSEN & JOHNSON, INC.

CIVIL ENGINEERS AND SURVEYORS

Elkhorn, Wisconsin

LEGEND

- — Iron Pipe
- — Concrete Monument

Scale 1" = 40.0'

WE CERTIFY: That we have surveyed the above described property and that the plat shown hereon is an accurate survey and a true representation thereof and correctly shows the exterior boundary lines and all divisions of said property.

Date APR 4, 1975 Thomas P. A. Jensen

Wisconsin Registered Land Surveyor, No. S-1084

YFLA-13