


#147-65

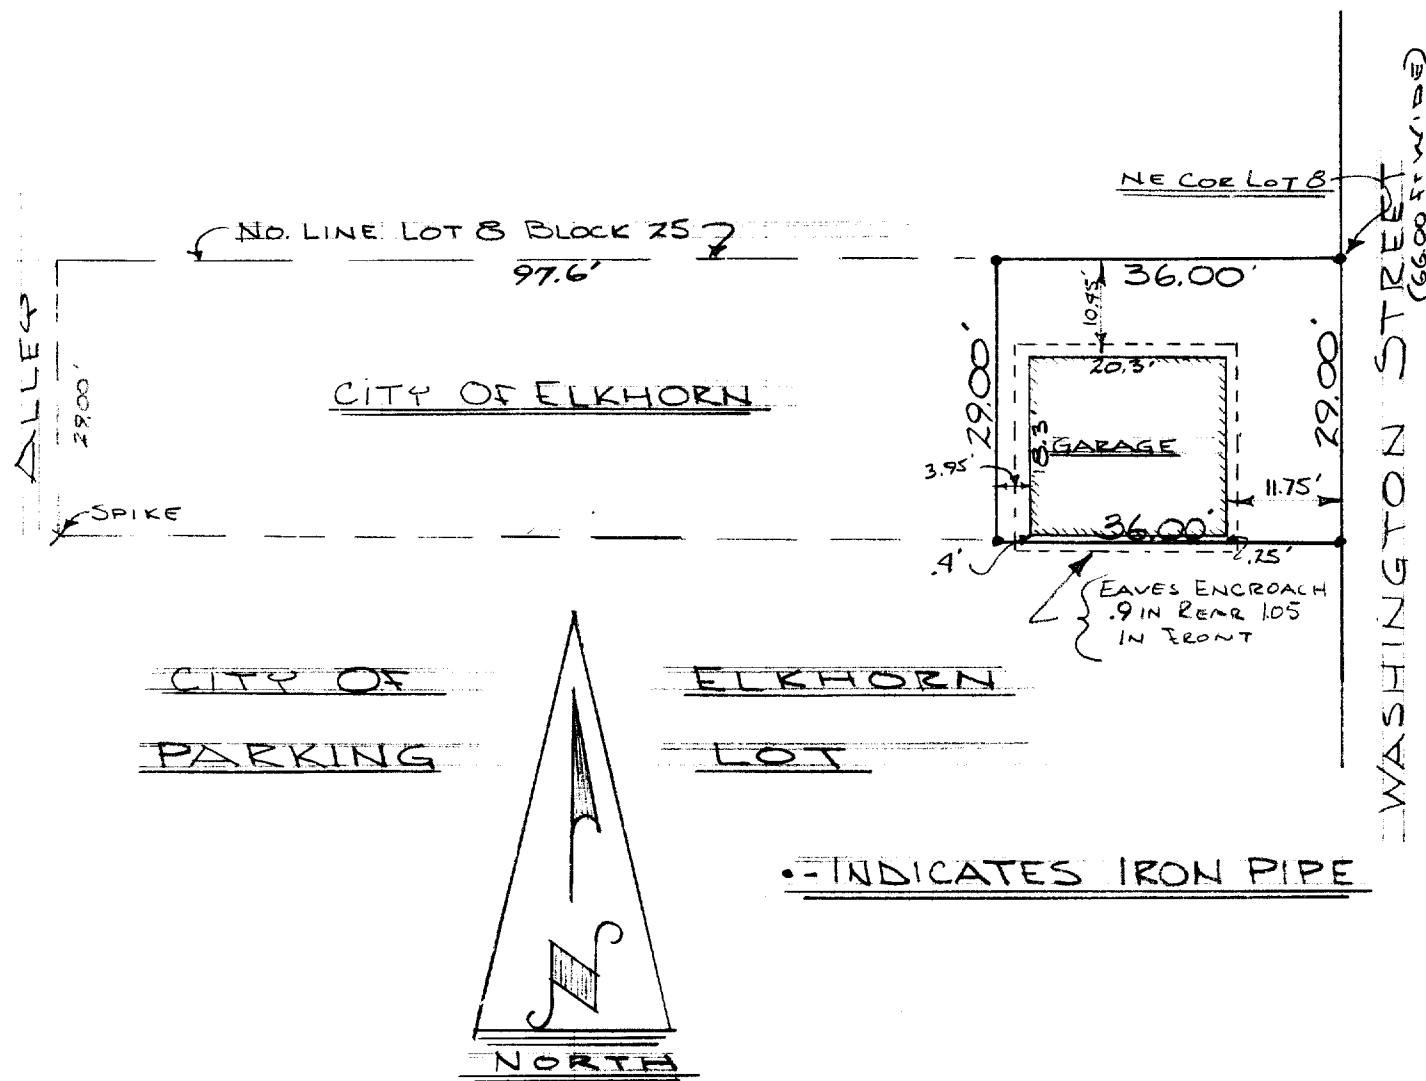

DESCRIPTION:

The north 29.00 feet of the East 36.00 feet of Lot 8 Block 25 of the Original Plat of the City of Elkhorn, Walworth County, Wisconsin.

CERTIFICATE: I, James F. Biagi. Surveyor do hereby certify that I have surveyed the property hereon described.

May 4th 1965.

James F. Biagi RLS 272
Elkhorn, Wisconsin.



OP-196

4-128B