



PLAT OF SURVEY OF

the West Half of the South Half of the following described property: Beginning at a point in the southerly line of Plank Road (now known as Walworth Street) at the northeast corner of what was formerly known as Lot 3, Block 7 of Devendorf, Mallory and Spencer's Addition to the Village (now city) of Elkhorn, Walworth County, Wisconsin, (said plat being vacated by decree of Circuit Court of Walworth County recorded in the office of the Register of Deeds in Volume 31 of Mortgages, page 102); thence southwesterly along the southerly line of said Walworth Street 162.85 feet to an iron stake, thence south parallel with the east line of Devendorf Street in said city 278.25 feet to an iron stake in the north line of South Street (now known as West Geneva Street) in said city; thence east along the north line of said West Geneva Street, 159.05 feet to an iron stake; thence north parallel with the east line of said Devendorf Street 309.2 feet to the point of beginning.

Legal description from Volume 653 deeds, pages 5161-5165, Document Number 378153

NOTE: This property is located in the Southeast Quarter of the Southwest Quarter of Section 36, Township 3 North, Range 19 East of the Third Principal Meridian, City of Elkhorn, Wisconsin.

NOTE:
Westerly line of description was not parallel with the easterly line of Devendorf Street as found monumented

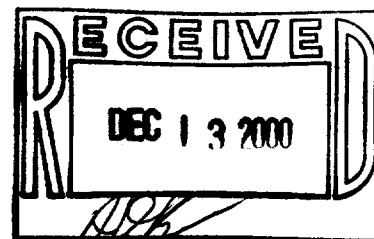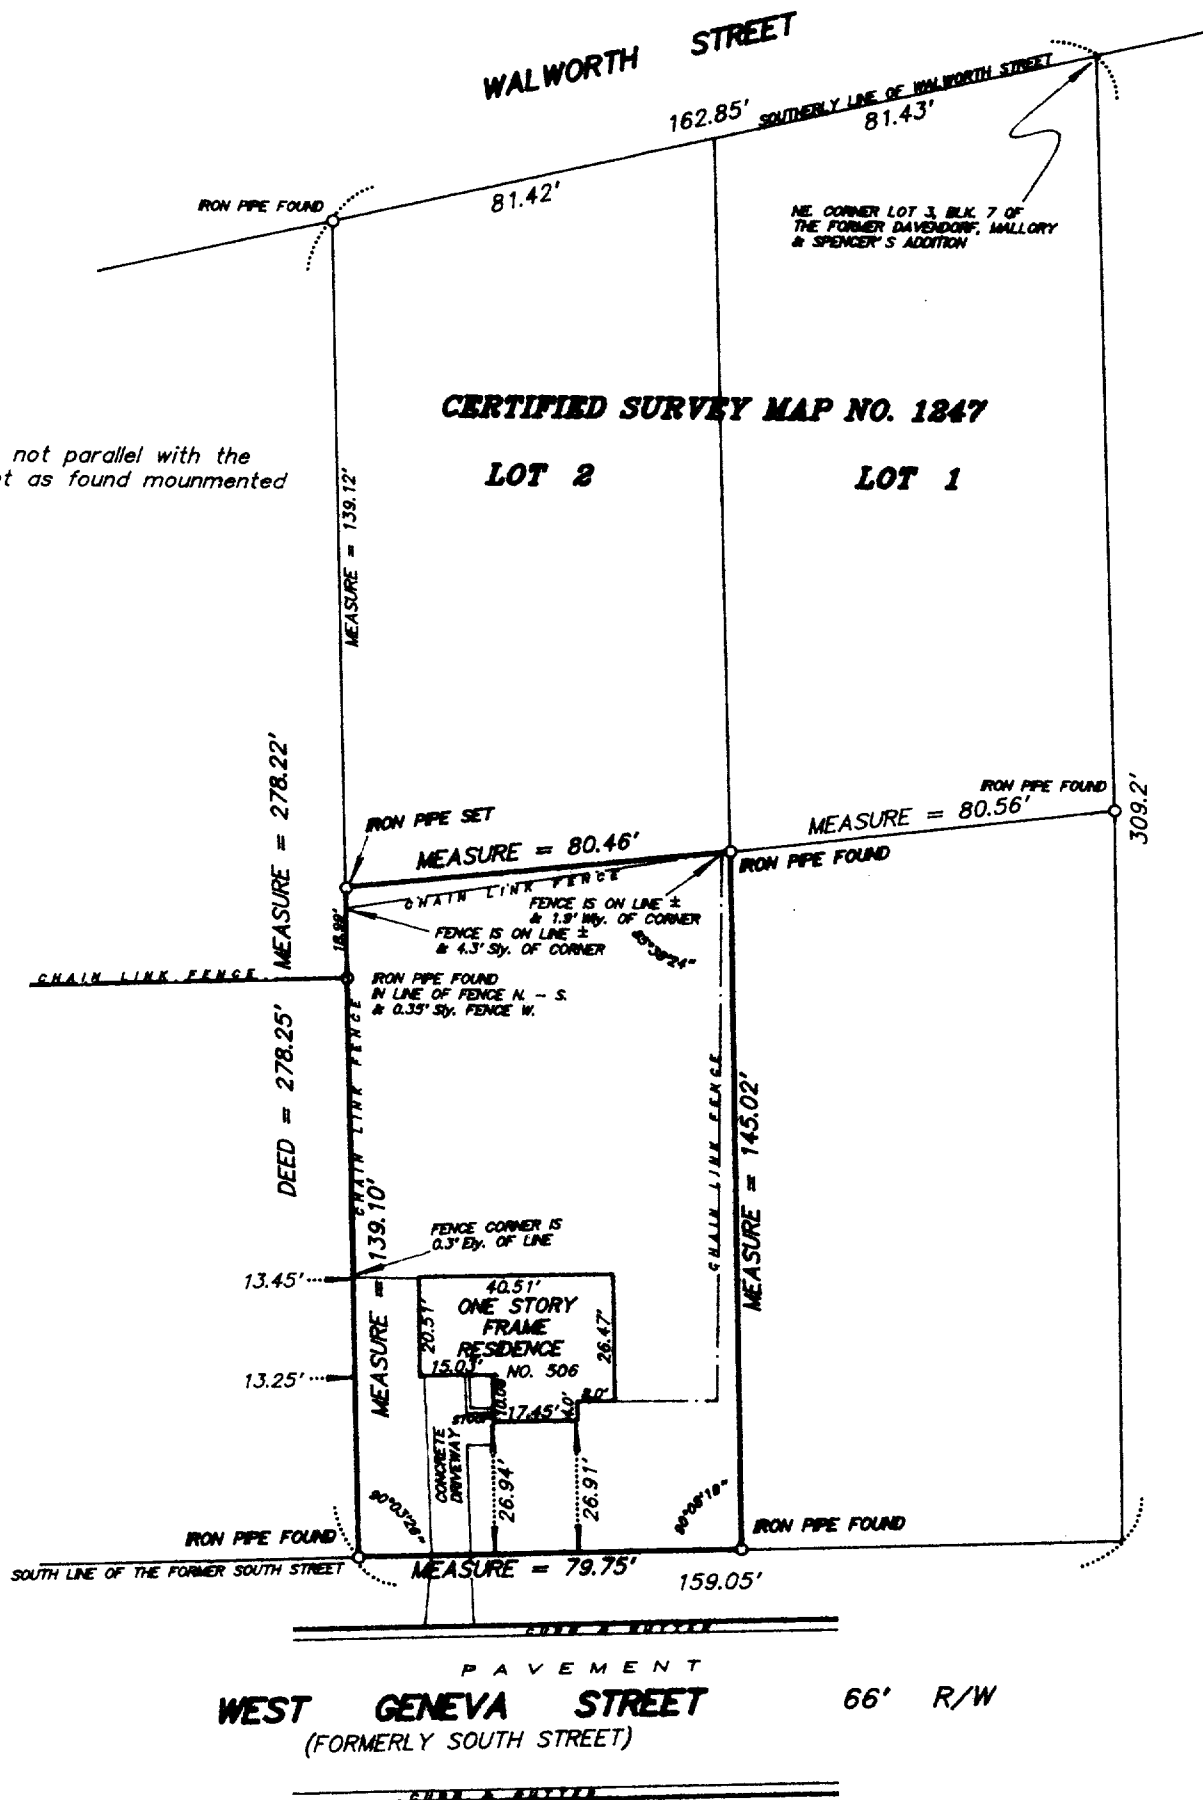

SCALE 1 inch = 40 feet

ORDERED BY M. Mathison / Coldwell Banker - Geneva Lakes Area Realty

JOB NO. 00207

I hereby certify that I have surveyed the above described property and the above plat is a true representation thereof and shows the size and location of the property, its exterior boundaries, the location and dimensions of all visible structures thereon, boundary fences, apparent easements and roadways and visible encroachments, if any.

This survey is made for the exclusive use of the present owners of the property, and also those who purchase, mortgage, or guarantee the title thereto within one year from the date hereof.

Dated at Bassett, Wisconsin this _____ day of _____ 2000.

Mark A. Bolender
Wisconsin Registered Land Surveyor S - 1784

004-1314

yu nw - 222