


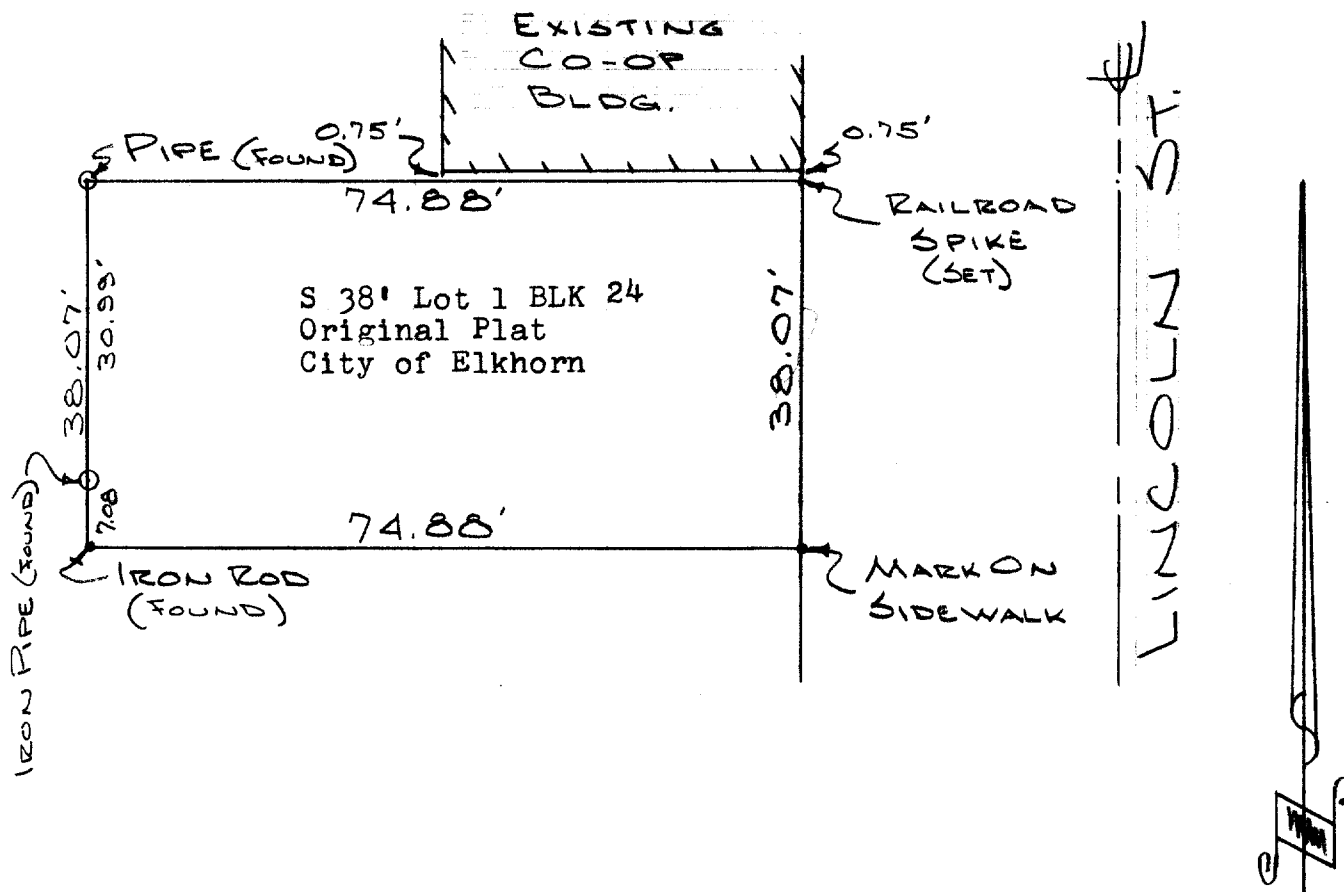

DESCRIPTION:


The South 38 feet of Lot 1, Block 24, Original Plat,
City of Elkhorn, Walworth County, Wisconsin.

CERTIFICATE:

I, James F. Biagi, surveyor, do hereby certify that
I have surveyed the lands hereon described.

DATE:

November 5, 1970

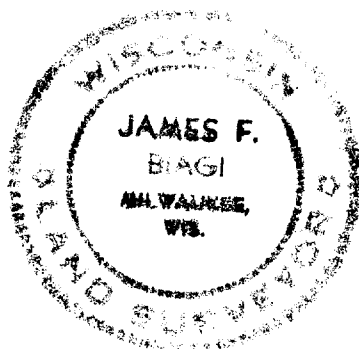

James F. Biagi
James F. Biagi R.L.S. 272