


#25-72

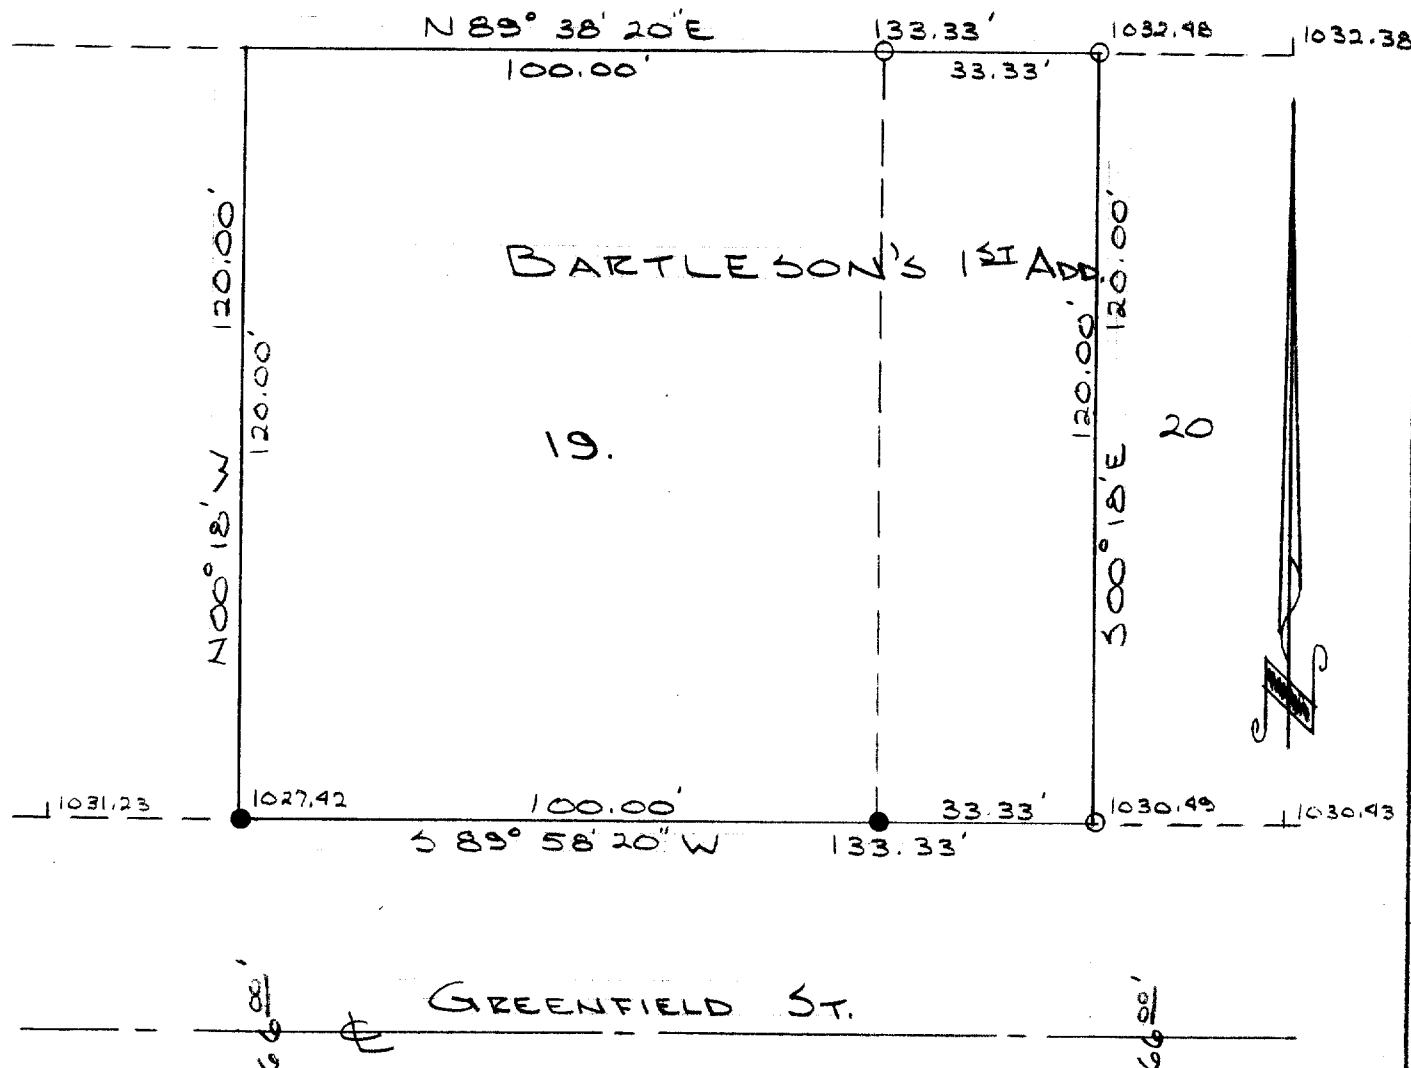


DESCRIPTION:

Lot 19 and the West 33.33 feet of Lot 20 of Bartelsson's First Addition Subdivision, located in the City of Elkhorn, Walworth County, Wisconsin.

CERTIFICATE:

I, James F. Biagi, surveyor, do hereby certify that I have surveyed the property hereon described.

May 1, 1972.

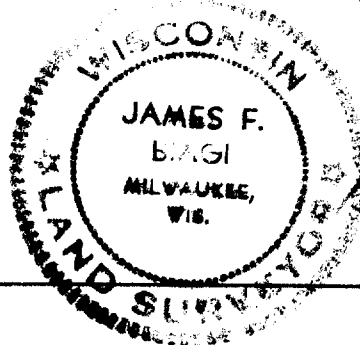

James F. Biagi, R.L.S. 272

YBA-4

4-13B