

# PLAT OF SURVEY

LOT 42, HARVEST POINTE, being a part of Lot 4 of Certified Survey Map No. 2083, and a part of the Northeast 1/4, Northwest 1/4, Southeast 1/4 and the Southwest 1/4 of the Southwest 1/4 of Section 30, Town 3 North, Range 17 East, City of Elkhorn, Walworth County, Wisconsin.  
 Surveyed for: Bielinski Brothers Builders/John Lysaght and Andrea Bohman

PATRICIA STREET

66' WIDE

CONCRETE CURB AND GUTTER

N07°14'13"W

68.08'

34.41'

S88°45'47"W

26.0'

8.0'

6.2'

17.5'

9.8'

23.5'

22.0'

26.0'


5.0'

EXISTING FOUNDATION

26.0'

44.0'

131.11'

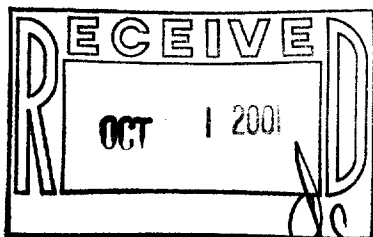

S07°14'13"E

91.00'

20' WIDE DRAINAGE AND UTILITY EASEMENT

20' WIDE DRAINAGE AND UTILITY EASEMENT

S86°09'05"E

128.60'

- FOUND 1" IRON PIPE
- FOUND 2" IRON PIPE

RADIUS	LENGTH	CHORD	BEARING	DELTA
767.00'	68.07'	68.05'	N07°14'13"E	05°05'06"

SCALE 1"=20'


"I hereby certify that I have surveyed the above described property and that the above map is a true representation thereof and shows the size and location of the property, its exterior boundaries, the location of all visible structures and dimension of all principal buildings thereon, boundary fences, apparent easements, roadways and encroachments if any."

"This survey is made for the use of the present owners of the property, and also those who purchase, mortgage or guarantee the title thereto within one year from date hereof."

7/19/01

TEP/DW

KETTLE MORaine SURVEYING  
 W356 S9050 Godfrey Lane  
 Eagle Wisconsin 53119  
 P.O. Box 357  
 (262) 594-3484  
 Terrance E. Pisarek R.L.S.

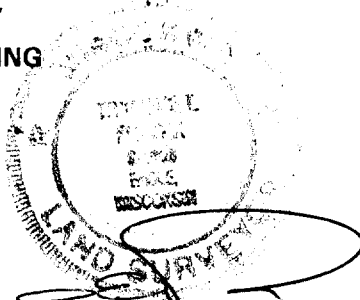

THIS IS NOT AN ORIGINAL SURVEY UNLESS THE SEAL IS RED.  
 TEP 01134

DATE

FIELD WORK BY

DRAWN BY

JOB NUMBER

YHP-42

004-1413