


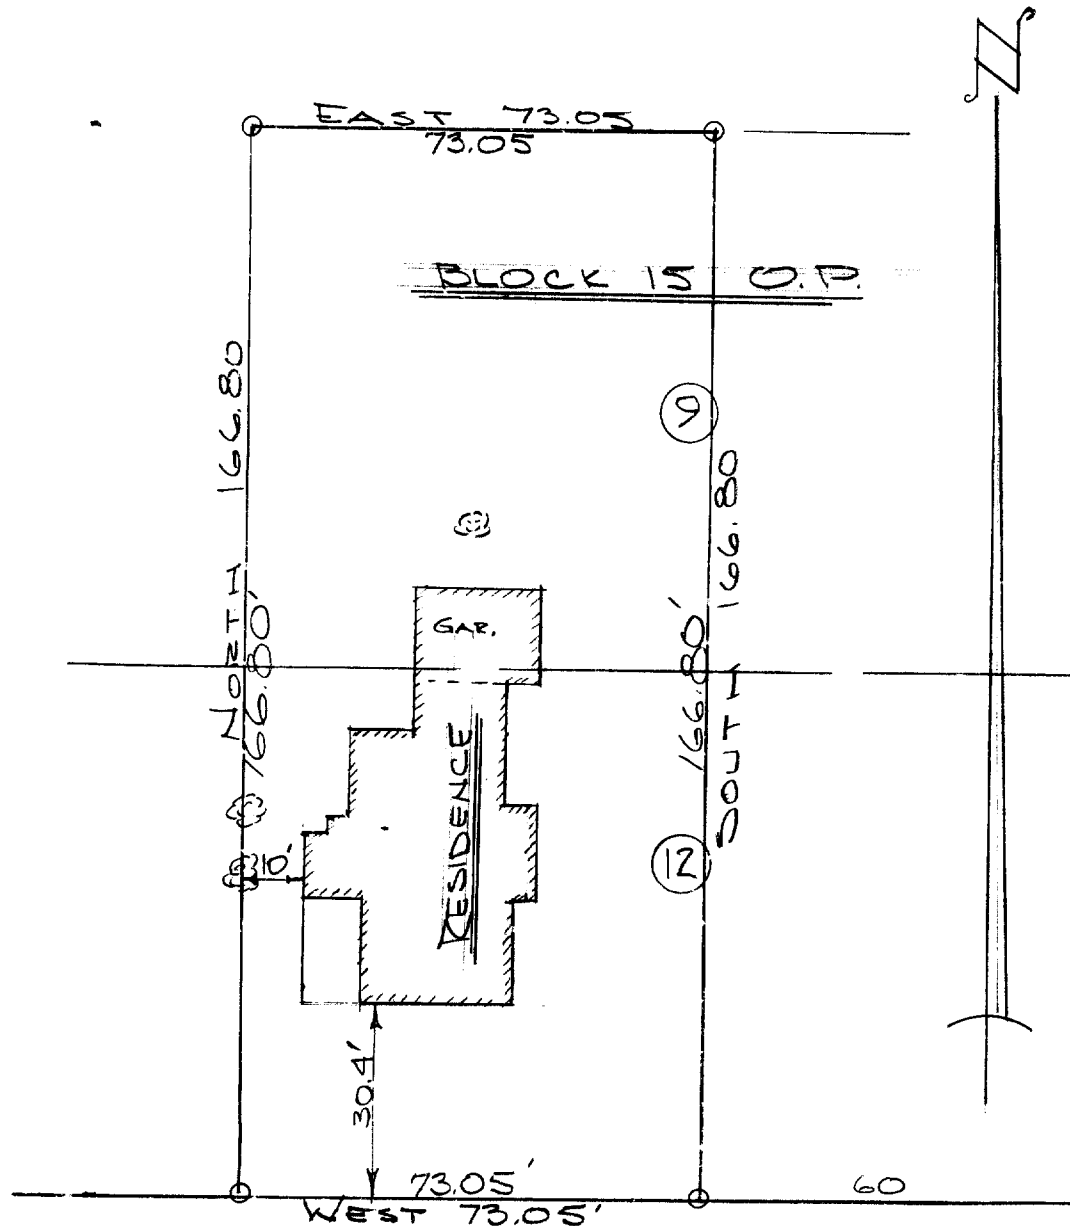

DESCRIPTION: Lots 9 and 12, except the East 60.00 feet thereof, of Block 15 of the Original Plat, of the City of Elkhorn, Walworth County, Wisconsin.

CERTIFICATE: I, James F. Biagi, surveyor, do hereby certify that I have surveyed the property hereon described,

June 6, 1967.

James F. Biagi, RLS 272

