


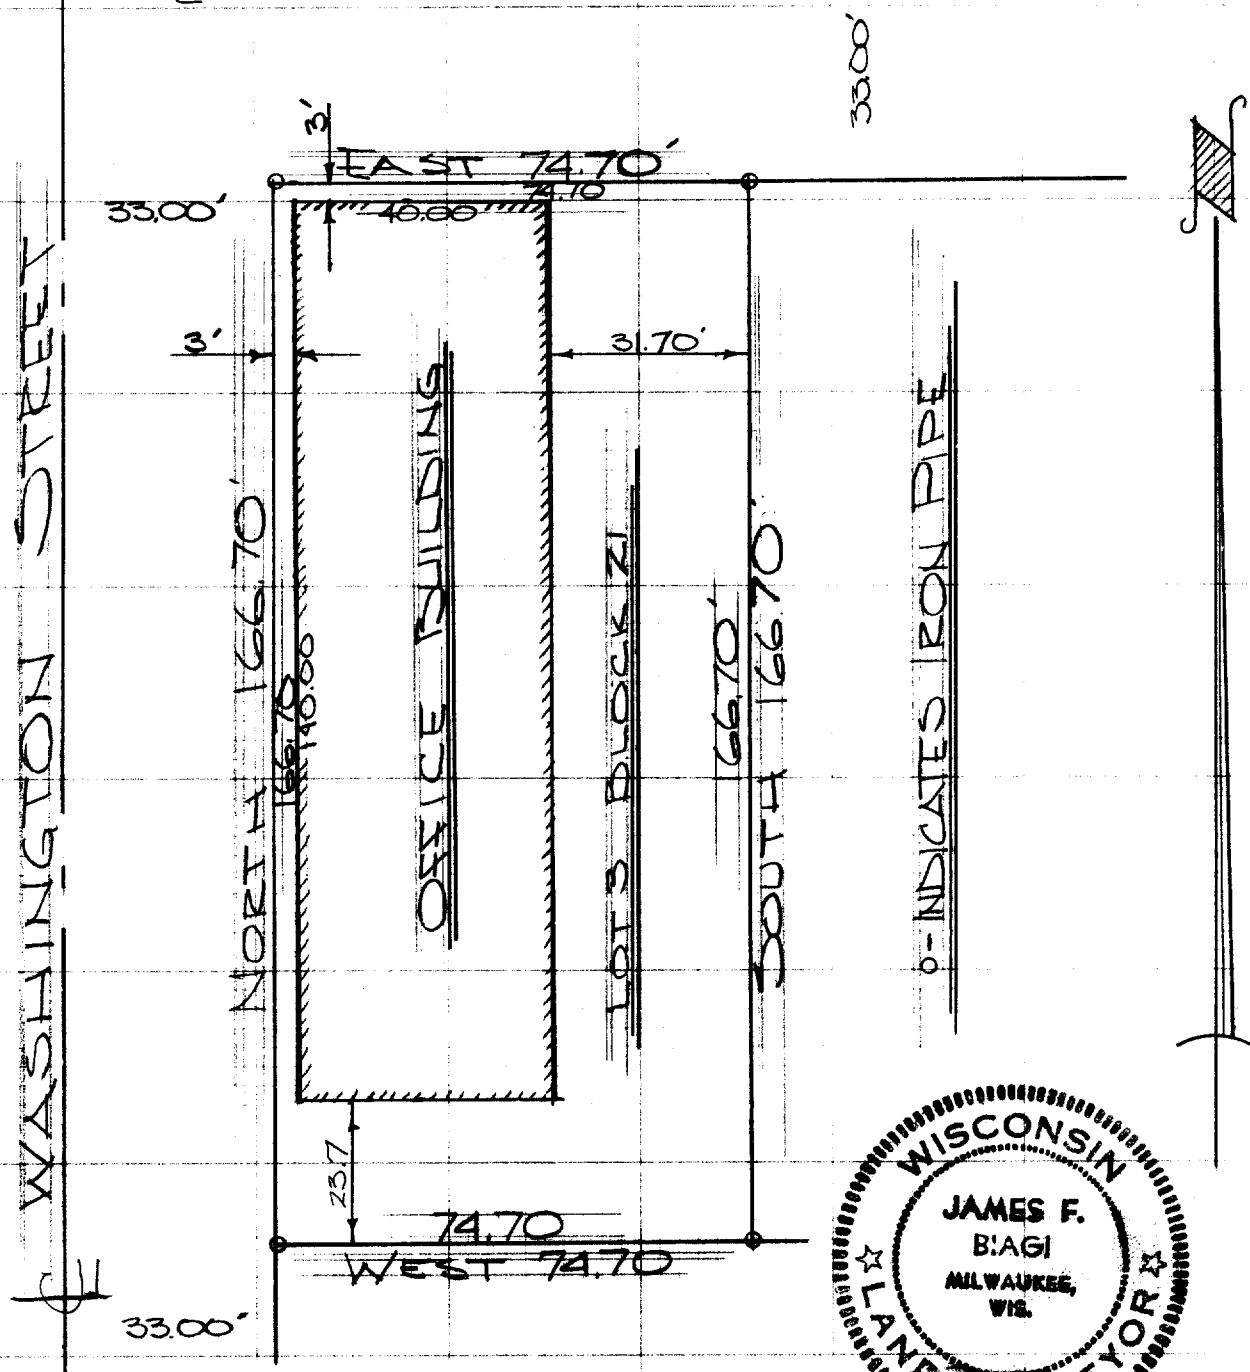

CERTIFICATE: I, James F. Biagi, surveyor, do hereby certify
that I have surveyed the property herein described.

June 24, 1967.

~~James F. Biagi, RLS 272~~