


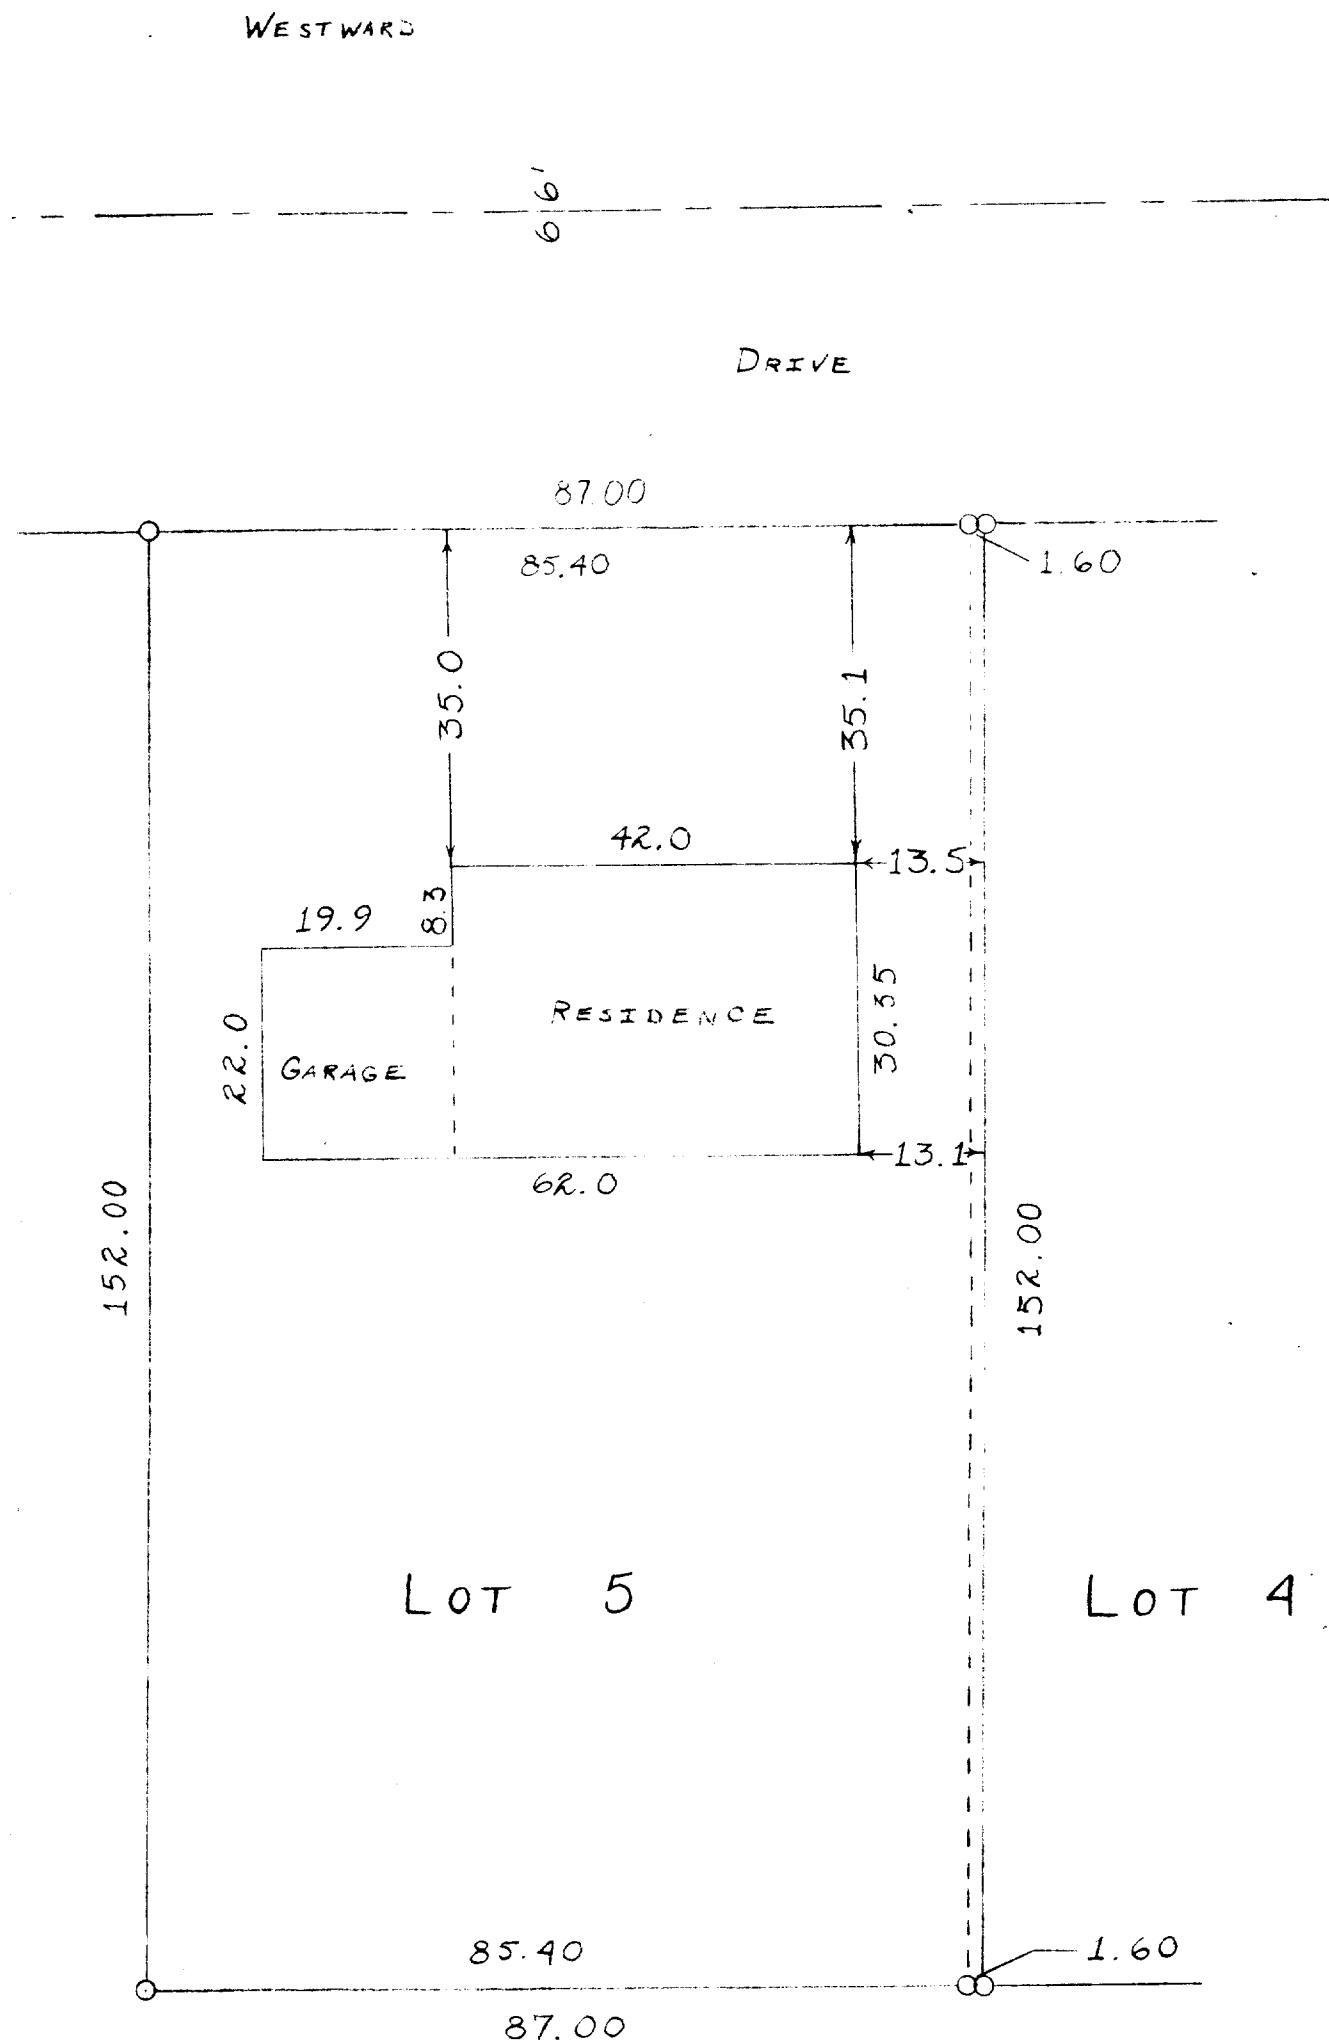

SCALE ~ 1" = 20'
 O = IRON PIPE

STATE OF WISCONSIN) SS
 WALWORTH COUNTY)

I, GEORGE T. DUNHAM, DO HEREBY CERTIFY THAT I HAVE SURVEYED THE
 PROPERTY DESCRIBED AS FOLLOWS:

LOT 5 AND THE WEST 1.60 FEET OF LOT 4, BLOCK 2, JAMES JONES SECOND
 ADDITION TO THE CITY OF ELKHORN, WALWORTH COUNTY, WISCONSIN
 AND THAT THE ADJACENT PLAT IS A CORRECT REPRESENTATION OF THE PROPERTY
 LINES AND IMPROVEMENTS LOCATED THEREON.

JULY 13, 1959

George T. Dunham
 GEORGE T. DUNHAM, SURVEYOR
 DELAVAN, WISCONSIN

4-15

YJA2-20