


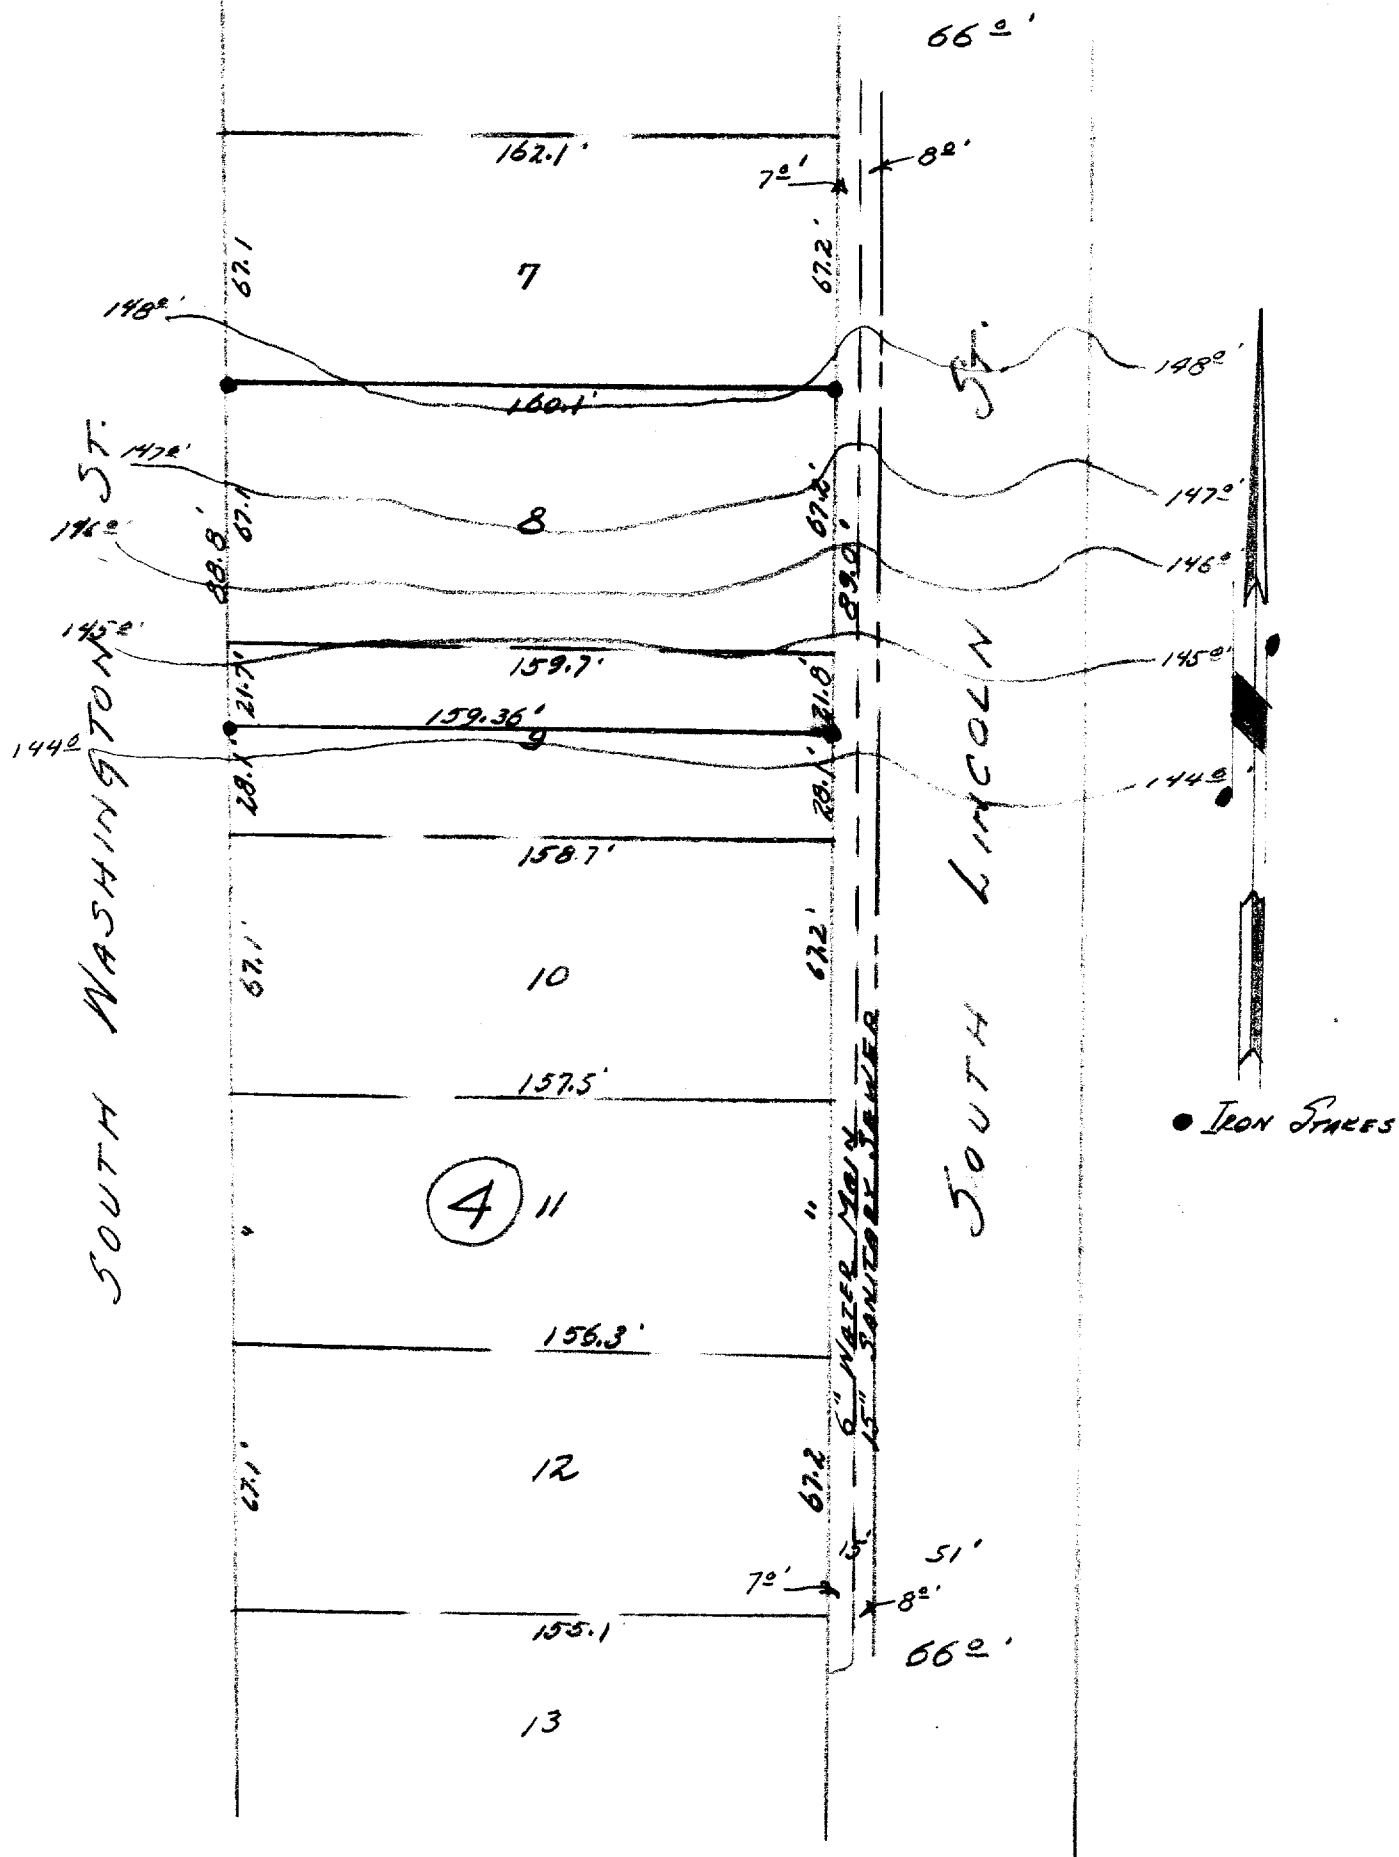

4-121

DESCRIPTION: Lot 8 and Lot 9 except the South 21.8 feet thereof; Block 4 Preston's Addition to the City of Elkhorn Walworth County, Wisconsin.

CERTIFICATE: I, hereby certify that I have on this the 2nd Day of April 1956, surveyed the above described property according to the official records on file in the office of the Recorder of Deeds in and for Walworth County, Wisconsin and find that the measurements and bearings of the boundary lines of said property as taken at the site on this day, substantially agree with those in said official record and that no encroachments exist.

SIGNED AND SEALED ON THIS THE 3RD DAY OF APRIL 1956.

James F. Biagi
James F. Biagi Registered Surveyor
Milwaukee Wisconsin.

4-151

YP-24

4-121

4-121