
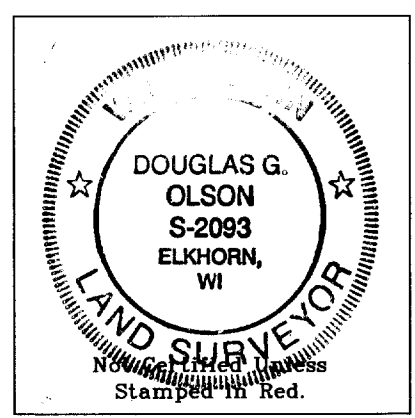
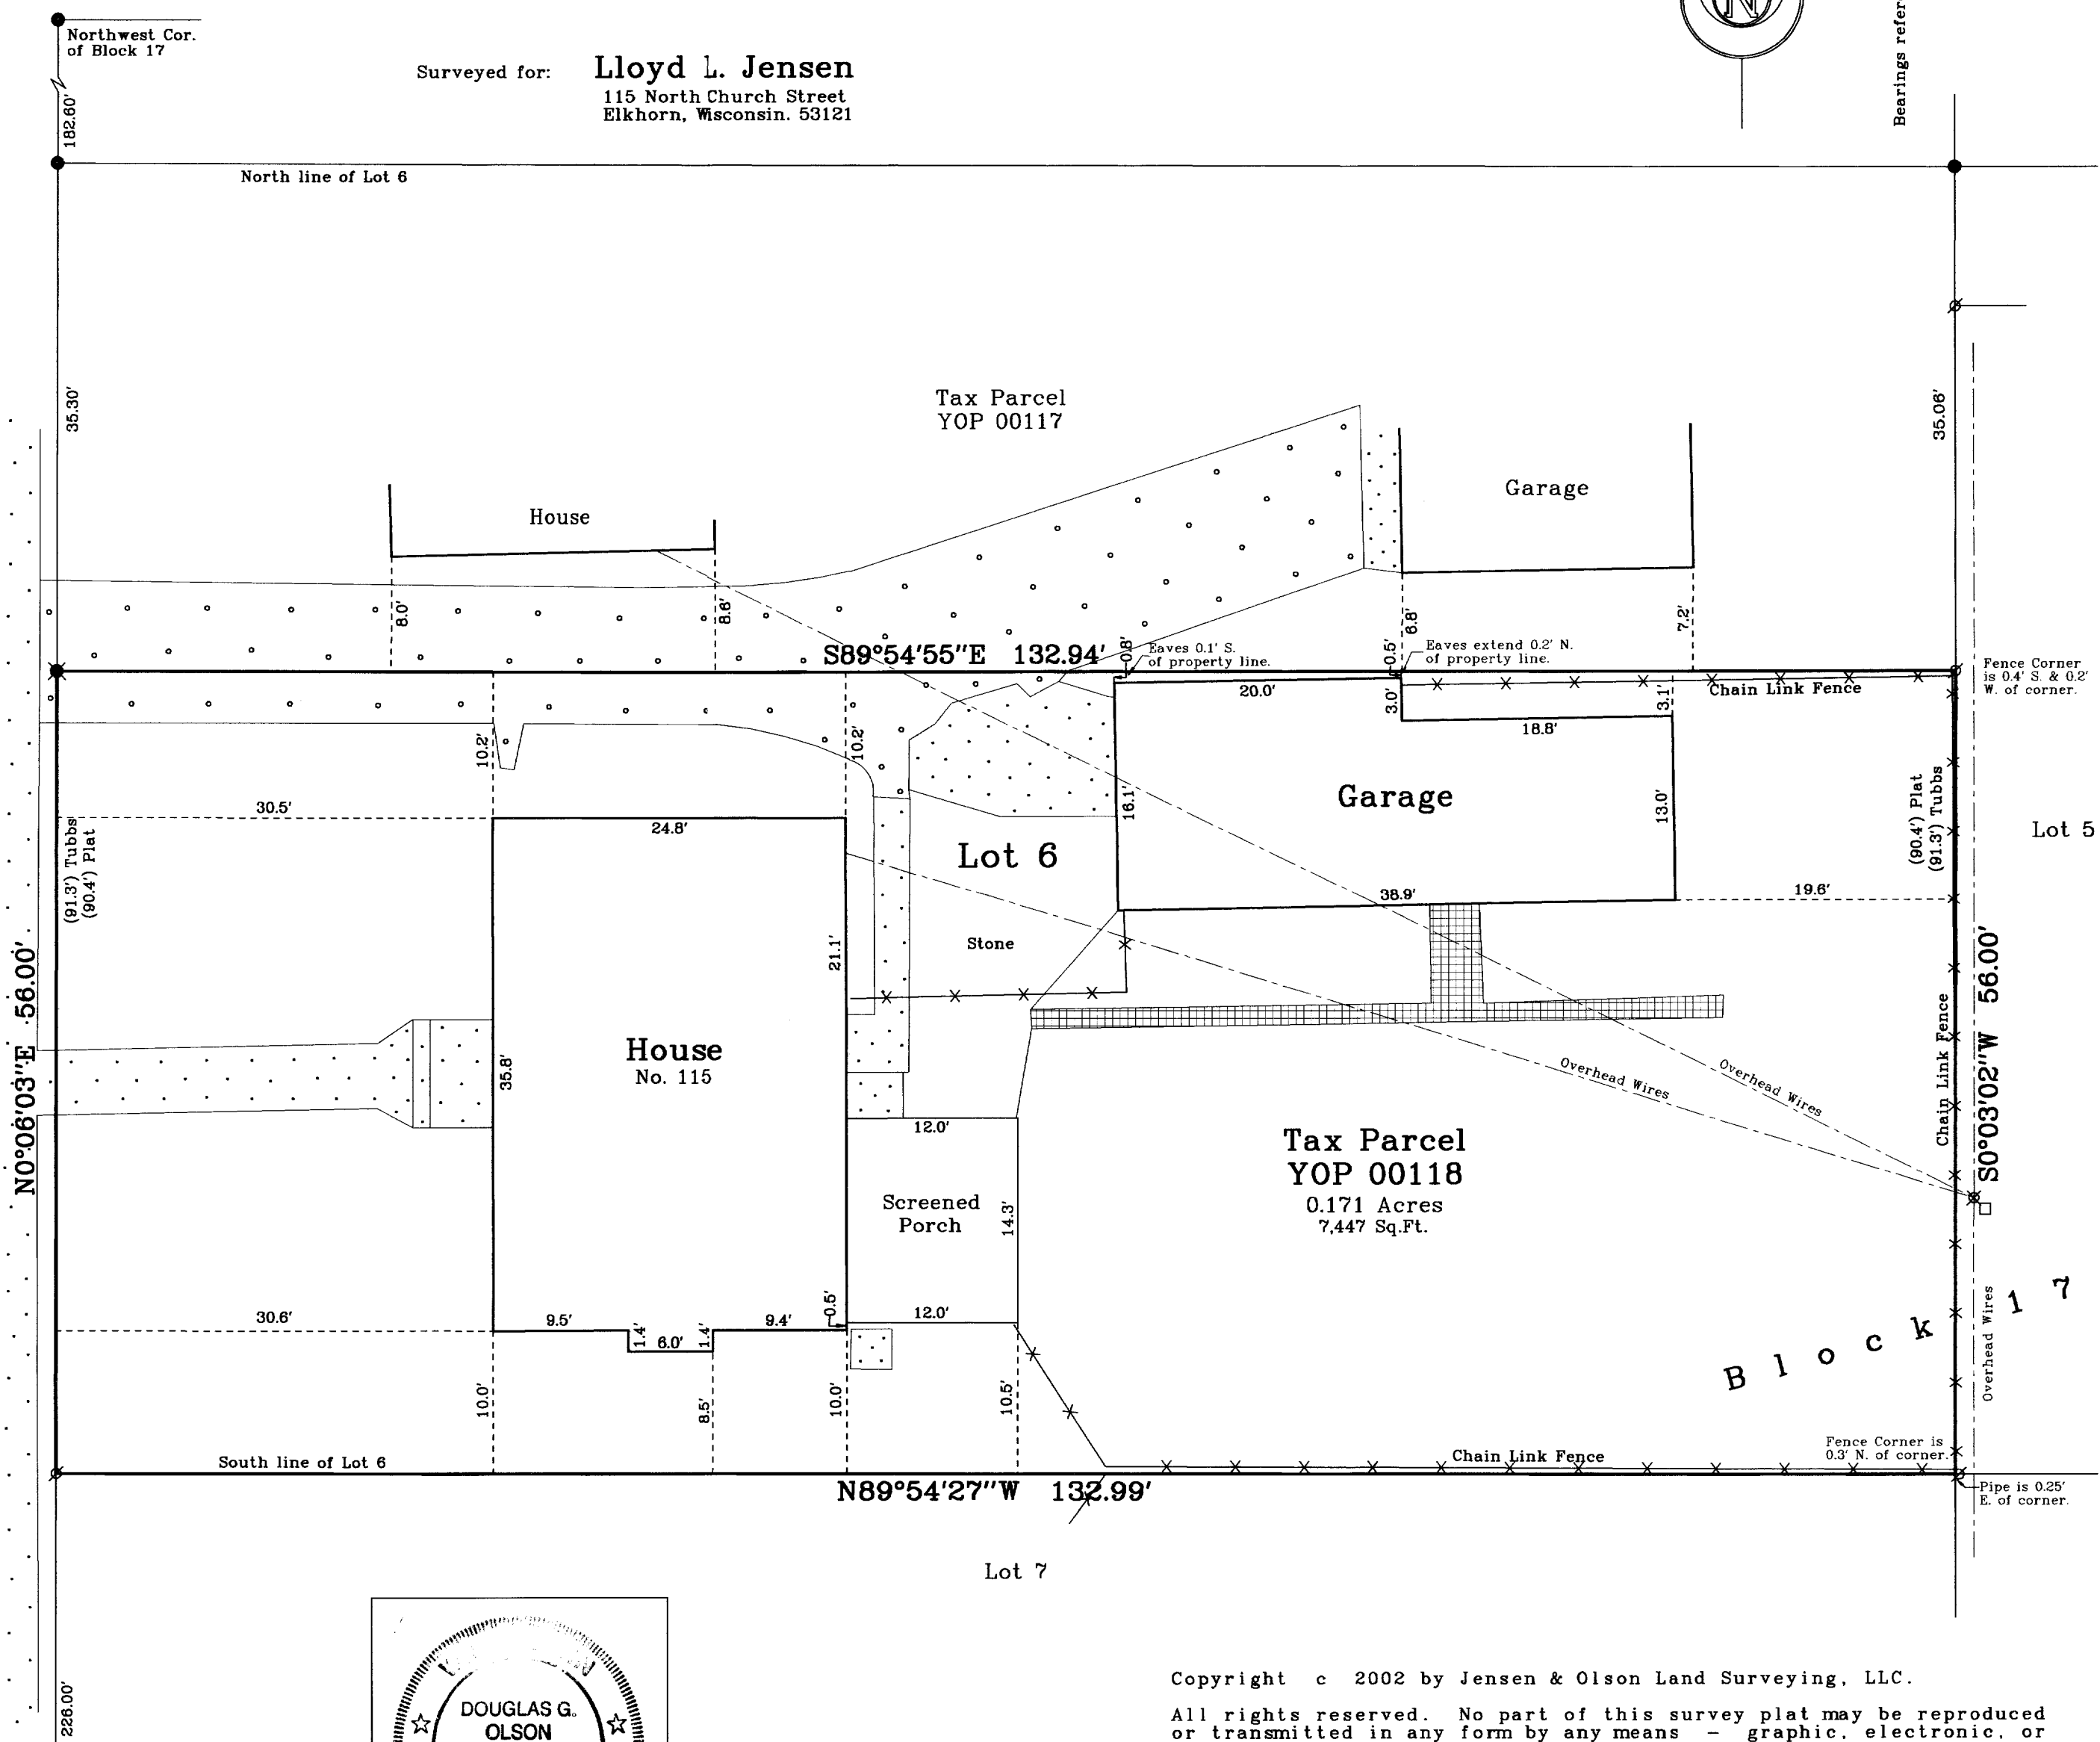
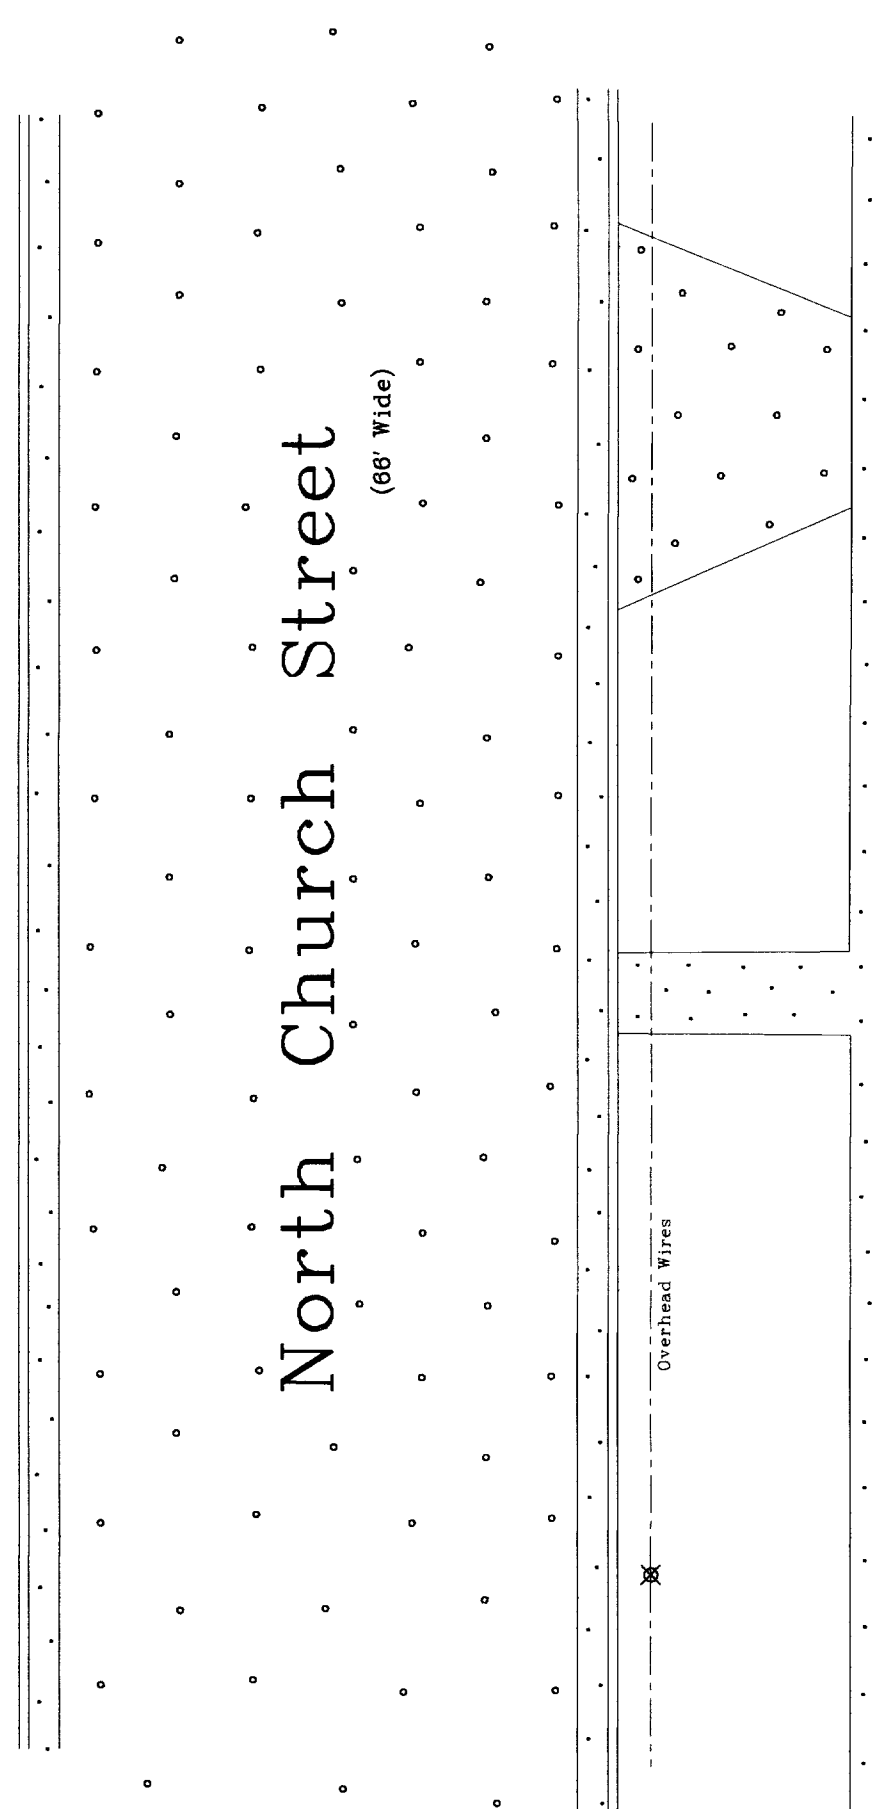


YOP-118


Plat of Survey

of
The South 56 feet of Lot 6 of Block 17 of the Original
Plat of the Village (now City) of Elkhorn,
located in the Southeast 1/4 of Section 36, Town 3 North, Range
16 East, City of Elkhorn, Walworth County, Wisconsin.

Surveyed for: **Lloyd L. Jensen**
115 North Church Street
Elkhorn, Wisconsin. 53121

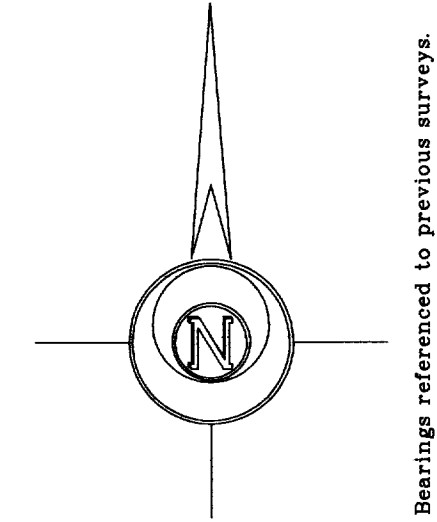

- Notes: 1) This survey plat is not certified unless signed and sealed in red ink.
2) This survey is subject to Wisconsin lien laws. This Plat of Survey is the notice of intent to file lien. Lien waiver required.

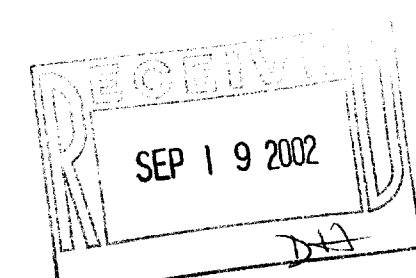


Copyright © 2002 by Jensen & Olson Land Surveying, LLC.

All rights reserved. No part of this survey plat may be reproduced or transmitted in any form by any means - graphic, electronic, or mechanical, including photocopying, tracing, or information storage and retrieval systems - without permission in writing from Douglas G. Olson, Jensen & Olson Land Surveying, LLC.

I, Douglas G. Olson, Wisconsin Registered Land Surveyor, do hereby certify that this survey was performed by me or under my direction in full compliance with the owner's/agent's instructions and Chapter A-E 7 of the Wisconsin Administrative Code "Minimum Standards for Property Surveys" and that this map is an accurate representation thereof to the best of my knowledge and belief.

Douglas G. Olson
Wisconsin Registered Land Surveyor - 2093

Survey Date: January 9, 2002
Revisions:

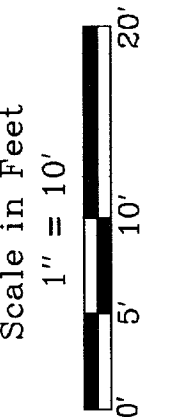

Jensen & Olson Land Surveying, LLC
45 South Wisconsin Street
Elkhorn, Wisconsin. 53121
Telephone (262) 723-3434
Facsimile (262) 723-8044

- Legend
- Found Iron Pipe
 - Found Iron Rod
 - Set Railroad Spike
 - Recorded Information
 - Concrete Surface
 - Asphalt Surface
 - Brick Surface
 - Utility Pole
 - Utility Ped.

Sheet 1 of 1 Sheets
Job Reference Number
2001.171

2001.171

Note: (88') Plat - Indicates dimension as shown on the Original Plat of the City of Elkhorn.
(88.7') Tubbs - Indicates dimension as shown on Mr. Tubbs' survey of the City of Elkhorn.

204-1517