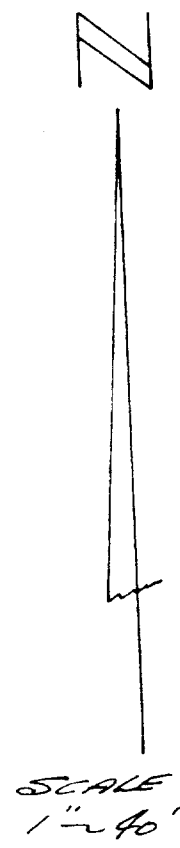


OF

 1754