
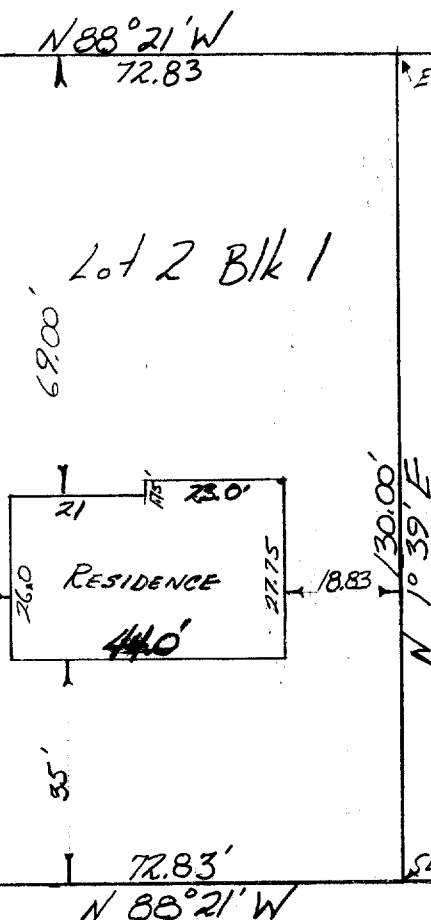


59-39

1" Iron Stakes at
Lot Corners

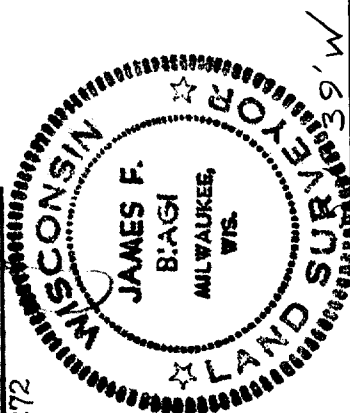


12.84' To EDGEWOOD AVE. →

2nd AVE
ELEV 100.00

DESCRIPTION: Lot 2 Block 1 of Edgewood Subdivision, in the City of Elkhorn, Wisconsin.

CERTIFICATE: I James F. Biagi, Surveyor, do hereby certify that I have surveyed the property hereon described and that the locations of the improvements are as shown on the drawing above.

SIGNED AND SEALED THIS 2ND DAY OF JUNE 1959

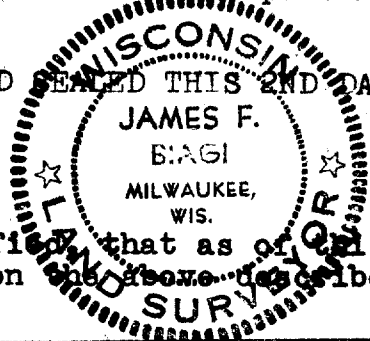

Re-certified that as of this day July 22nd 1959, buildings are located on the above described property as indicated hereon.

James F. Biagi, Surveyor.

Recertified March 30, 1965.

4-16.2