


O-INDICATES IRON PIPE

DESCRIPTION: The S 1/2 of Lot 2, Lot 3, and Lot 4 North of the Railroad ROW in Block 50 of Rockwell's Second Addition to the City of Elkhorn, Walworth County, Wisconsin.

CERTIFICATE: I, James F. Biagi, surveyor, do hereby certify that I have surveyed the property hereon described, and that the location of the improvements are as shown.

September 30, 1968.

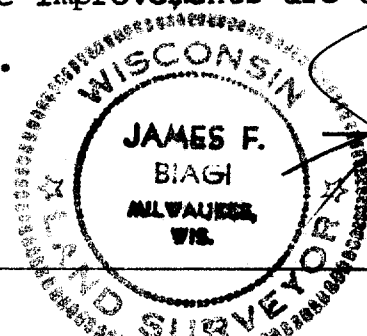

James F. Biagi
James F. Biagi, RLS 272

RW2-24

4-162