


#170-65

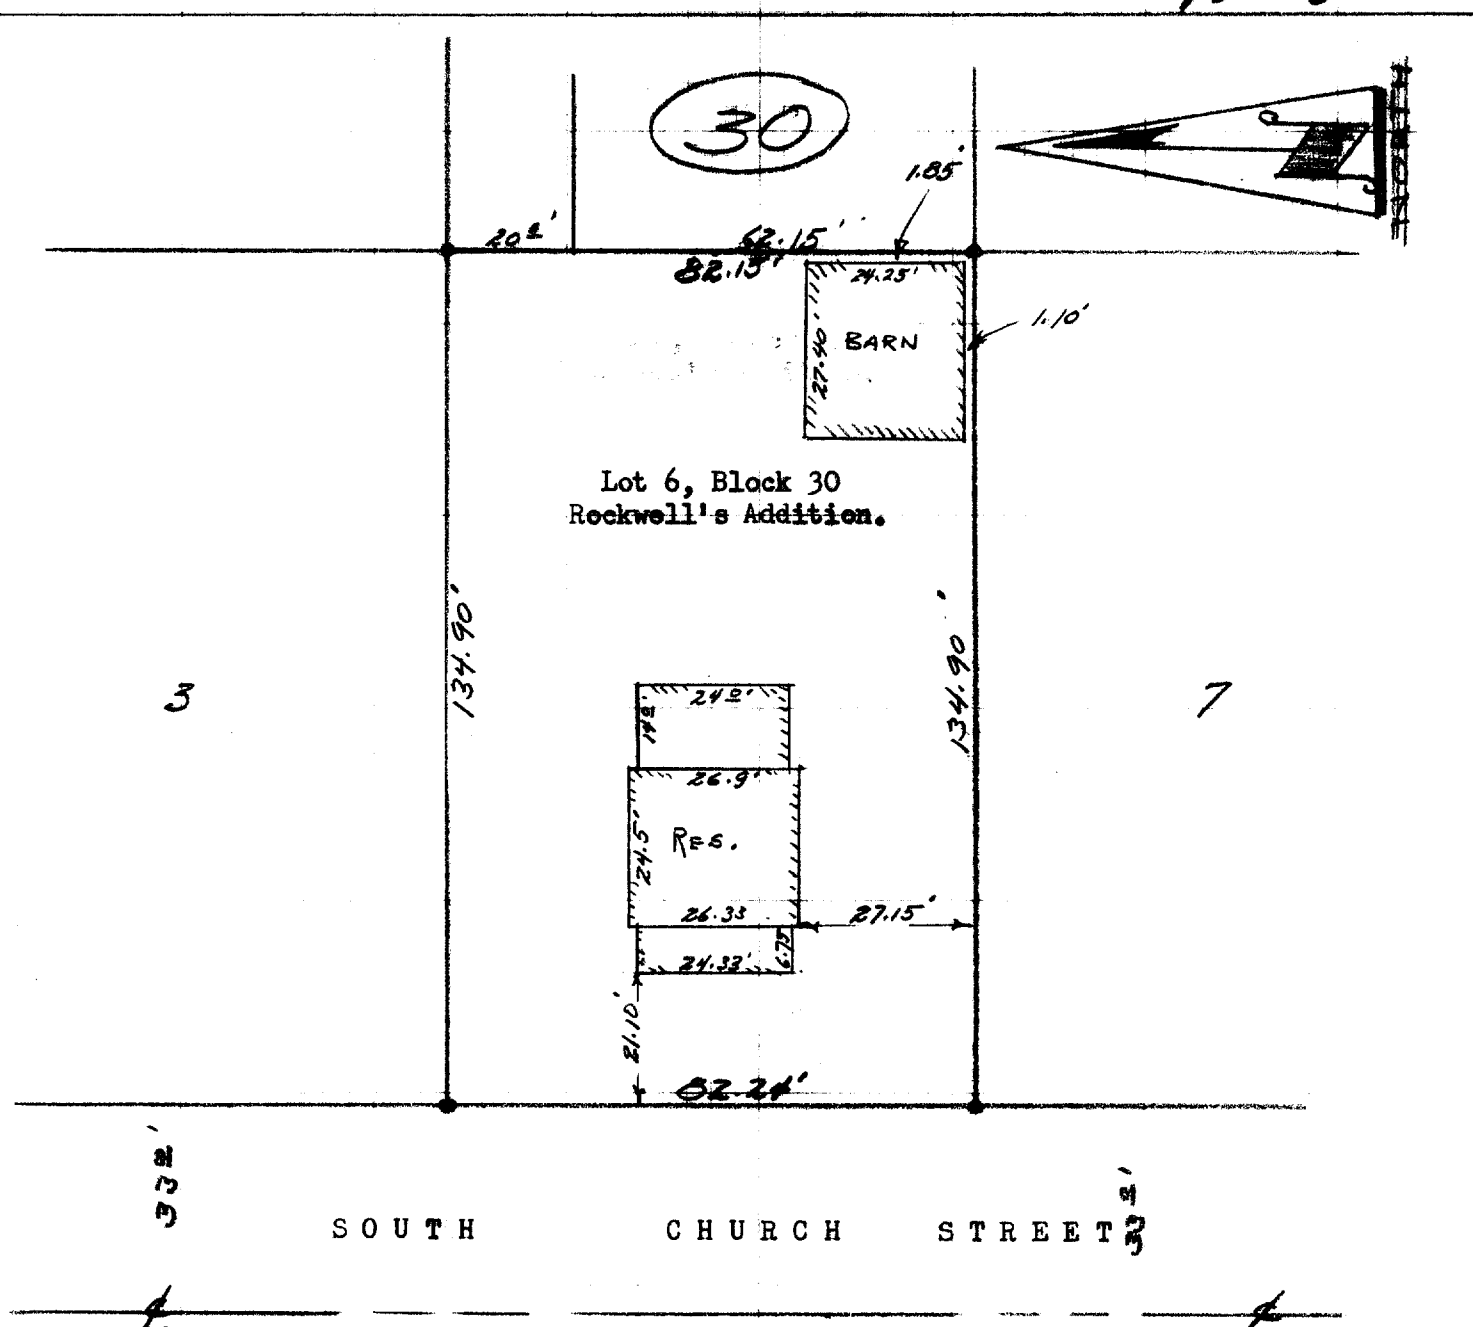


DESCRIPTION:

Lot 6, Block 30 Rockwell's Addition, City of Elkhorn, Walworth County, Wisconsin.

CERTIFICATE:

I, James F. Biagi, Surveyor, do hereby certify that I have surveyed the property hereon described and that the location of the improvements are as shown.

Date: May 29th 1965.

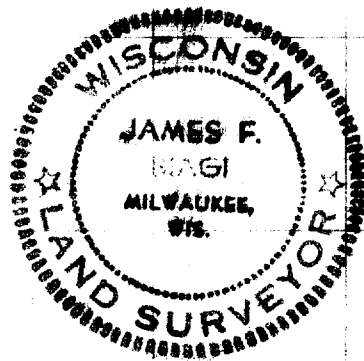

James F. Biagi, RLS 272
Elkhorn, Wisconsin.

YRW-42

4-163B