


PREPARED FOR:
DEBI OLMSTEAD
HELP-U-SELL REAL ESTATE
21 S. WISCONSIN ST.
ELKHORN, WI 53121

PLAT OF SURVEY

- OF -

J.K. SURVEYING INC.
N3705 WILLOWBEND LANE
LAKE GENEVA, WI, 53147
262-248-3697

LOT 38 OF ELKHORN WEST LOCATED IN THE NORTHEAST 1/4 OF THE SOUTHEAST 1/4
AND THE SOUTHEAST 1/4 OF THE SOUTHEAST 1/4 OF SECTION 35, T.3.N., R.16.E., AND
THE NORTH EAST 1/4 OF THE NORTHEAST 1/4 OF SECTION 2, T.2.N., R.16.E., CITY OF
ELKHORN, WALWORTH COUNTY, WISCONSIN.

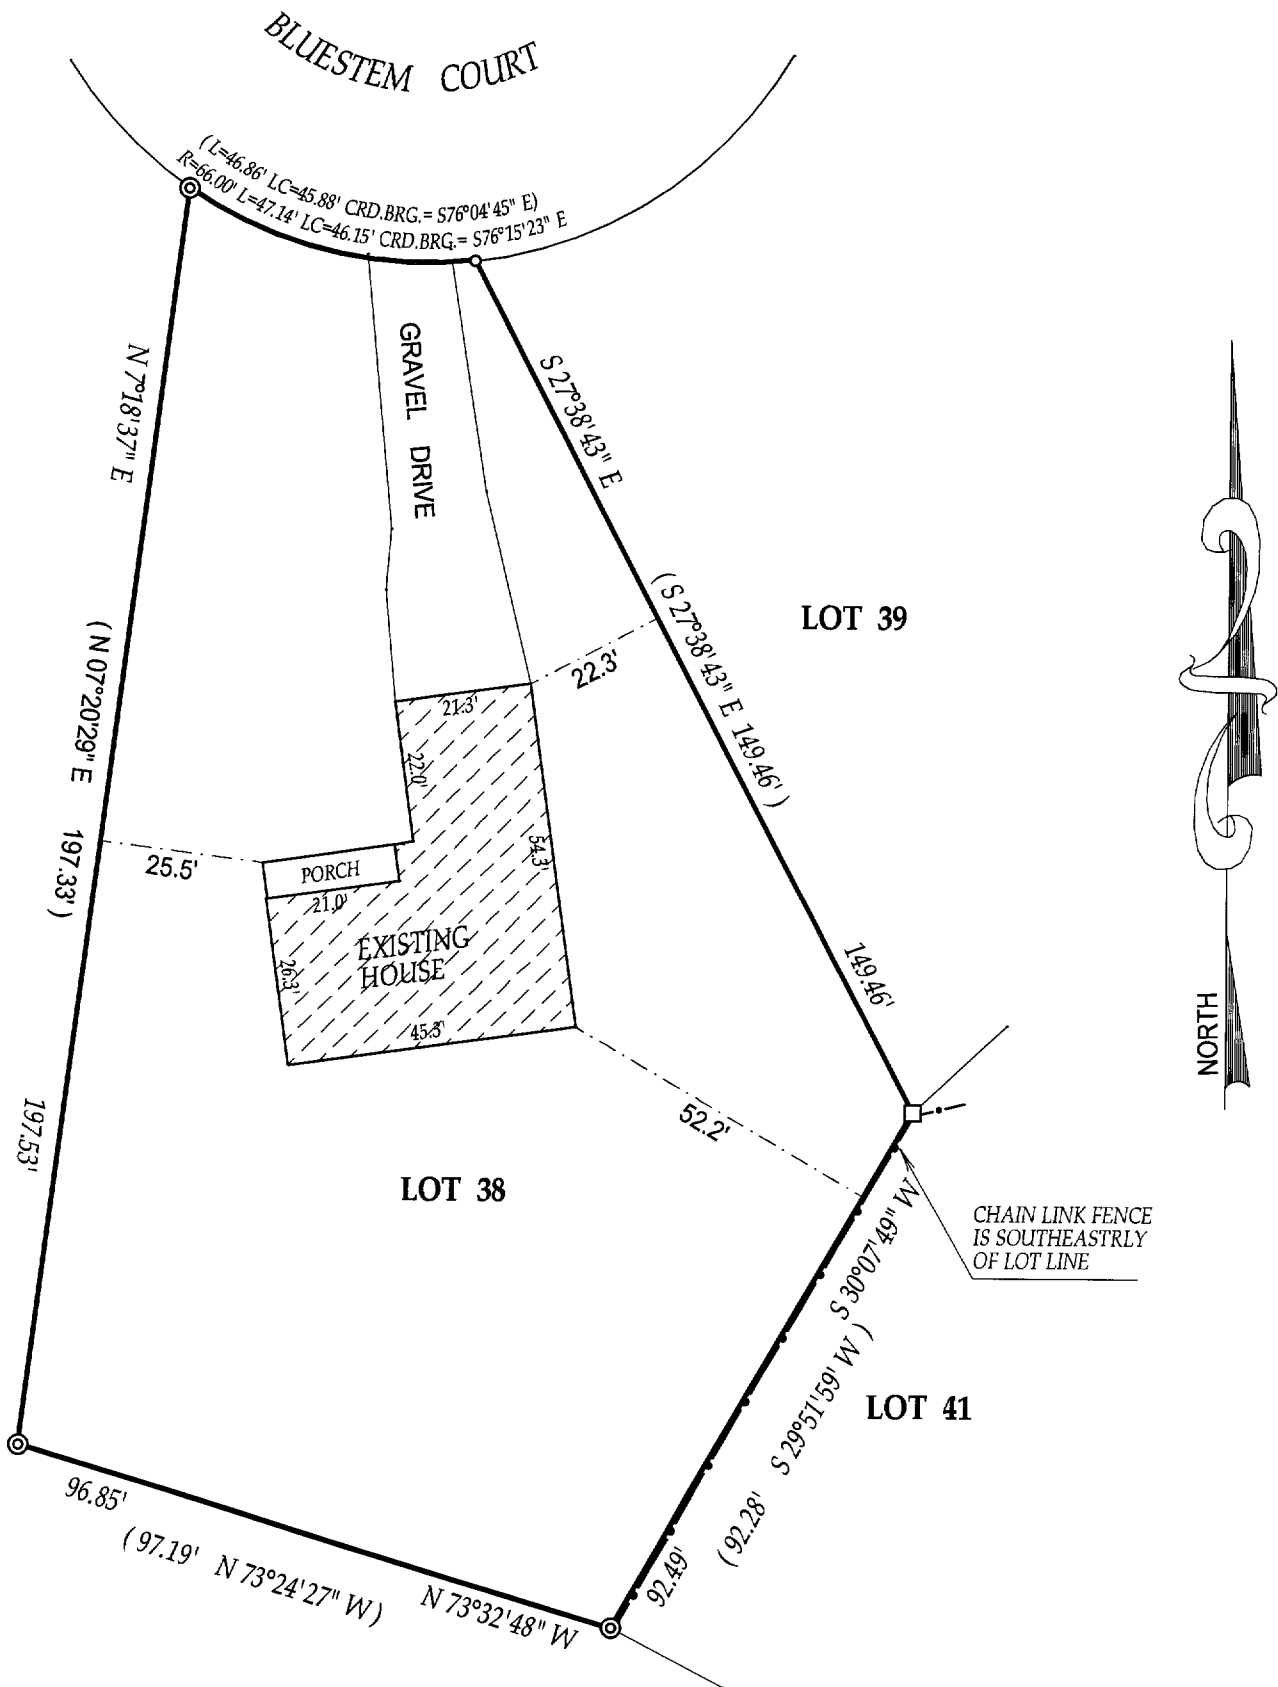

- () = recorded as
- = found iron bar
- = found iron pipe
- = set iron pipe
- = set iron bar

SCALE 1" = 30'

JOB # 03-739


TAX ID # YEW00038

COMPARE LEGAL DESCRIPTION ABOVE AND DRAWING WITH DEED. FOR BUILDING RESTRICTIONS AND EASEMENTS NOT SHOWN, REFER TO DEED, ABSTRACT SOURCES AND LOCAL MUNICIPAL CODES. NOTIFY THE SURVEYOR IMMEDIATELY OF ANY DISCREPANCY.

"I hereby certify that I have surveyed the above described property and that the above map is a true representation thereof and shows the size and location of all visible structures, apparent easements and encroachments if any."

This survey is made for the present owners of the property, and those who purchase, mortgage, or guarantee the title thereto, within one year from the date hereof.

DATED THIS 14th, DAY OF NOVEMBER, 2003

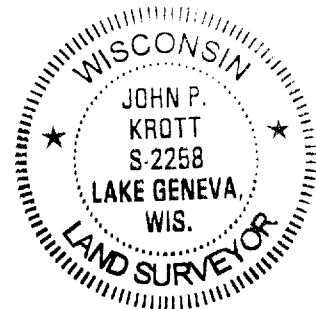

John P. Krott
JOHN KROTT S - 2258
Wisconsin Registered Land Surveyor
(original if signed in red)

004-1720