


PLAT OF SURVEY

- OF -

ROCKWELL STREET

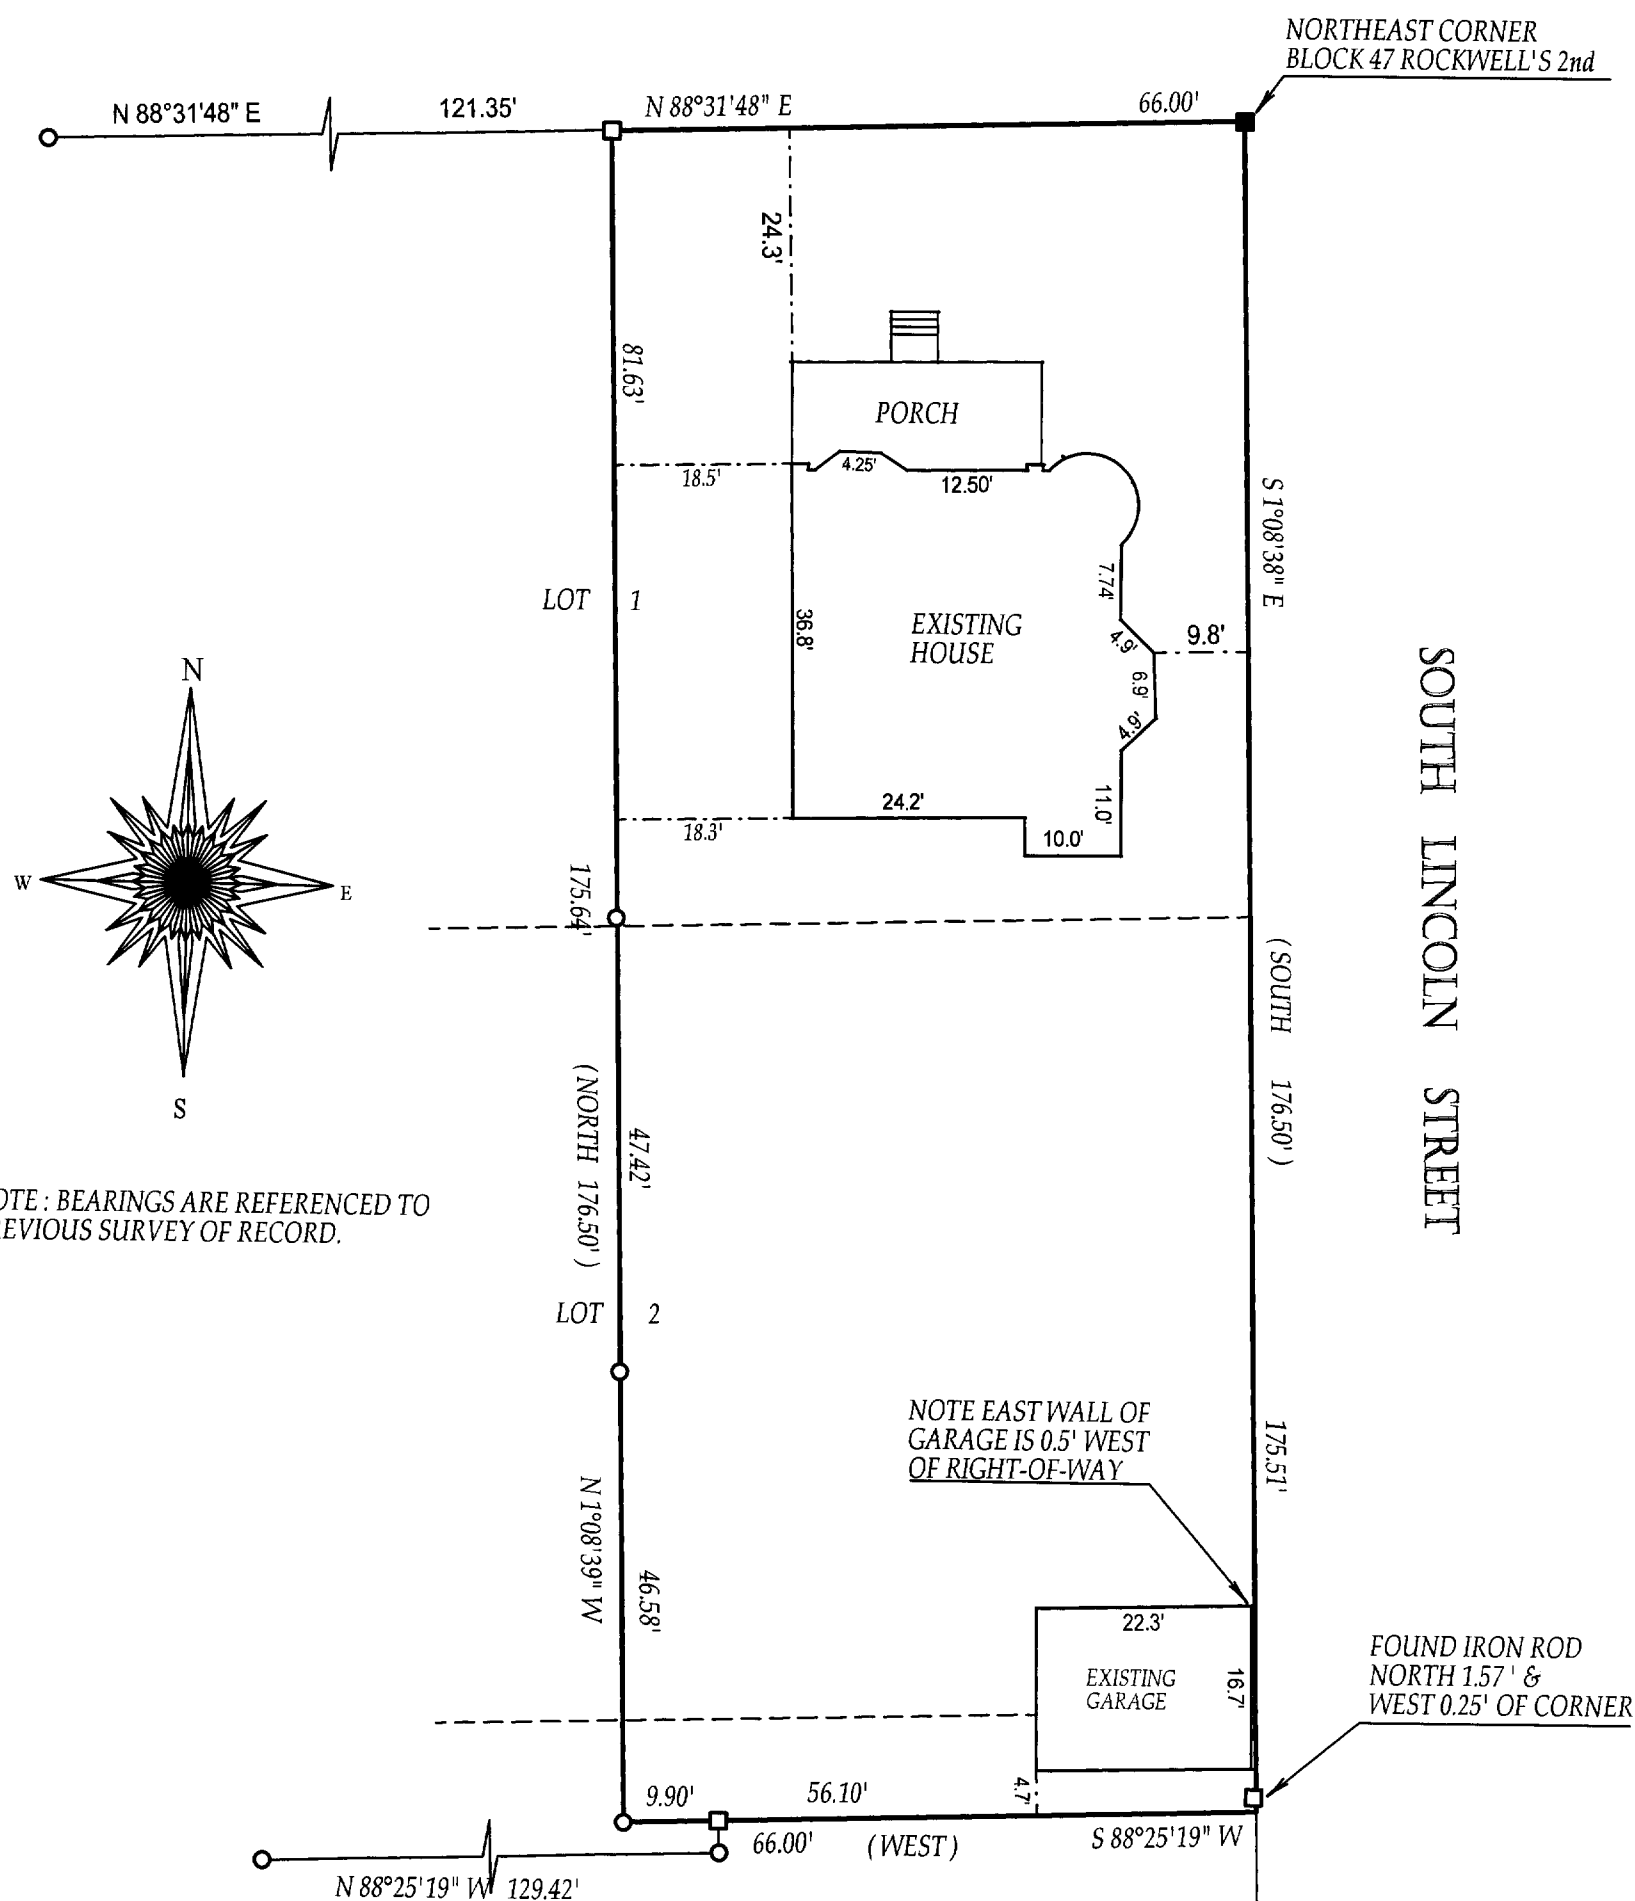

NOTE EAST WALL OF
GARAGE IS 0.5' WEST
OF RIGHT-OF-WAY

FOUND IRON ROD
NORTH 1.57' &
WEST 0.25' OF CORNER

RECEIVED
AUG 13 2007

COMPARE LEGAL DESCRIPTION ABOVE AND DRAWING WITH DEED. FOR BUILDING RESTRICTIONS AND EASEMENTS NOT SHOWN, REFER TO DEED, ABSTRACT SOURCES AND LOCAL MUNICIPAL CODES. NOTIFY THE SURVEYOR IMMEDIATELY OF ANY DISCREPANCY.

"I hereby certify that I have surveyed the above described property and that the above map is a true representation thereof and shows the size and location of all visible structures, apparent easements and encroachments if any."

This survey is made for the present owners of the property, and those who purchase, mortgage, or guarantee the title thereto, within one year from the date hereof.

A circular seal for a Wisconsin Land Surveyor. The outer ring contains the text "WISCONSIN" at the top and "LAND SURVEYOR" at the bottom, separated by two five-pointed stars. The inner circle contains the text "JOHN P. KROTT", "S 2258", "LAKE GENEVA", and "WIS." arranged vertically.

TAX ID # YRW200001

DATED THIS 29th, DAY OF JULY, 2004


JOHN KROTT S - 2258
Wisconsin Registered Land Surveyor
(original if signed in red)

004-1752