## FARRIS, HANSEN & ASSOCIATES, INC.


ENGINEERING - ARCHITECTURE - SURVEYING 7 RIDGWAY COURT - P.O. BOX 437 - ELKHORN, WISCONSIN

PHONE: (262) 723-2098 FAX: (262) 723-5886 PLAT OF SURVEY

LOT 53 OF ELKHORN WEST ADDITION NO. 1

LOCATED IN THE SE 1/4 OF SECTION 35, TOWN 3 NORTH, RANGE 16 EAST, WALWORTH COUNTY, WISCONSIN

- WORK ORDERED BY -DAN CARMODY 5803 GLEN HAVEN DRIVE GREENDALE, WI. 53129

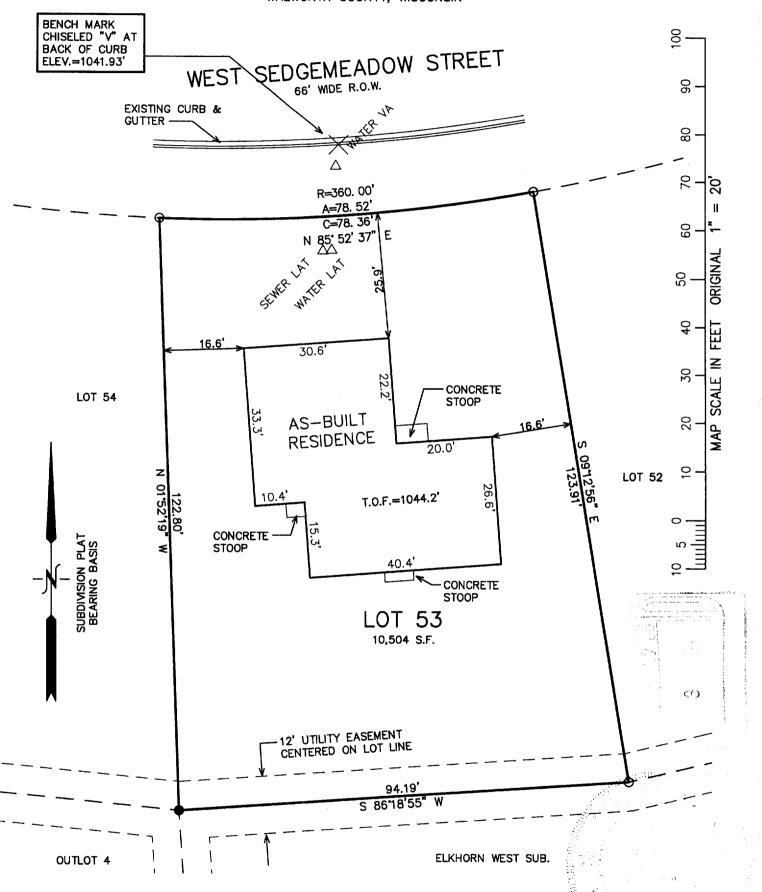

NOTE: COPIES OF THIS MAP TO WHICH THE FOLLOWING CERTIFICATE WILL APPLY SHOW THE SURVEYOR'S ORIGINAL SEAL AND SIGNATURE IN RED INK. COPIES BY ANY OTHER MEANS MAY HAVE ALTERATIONS WHICH DO NOT REPRESENT THE SURVEYOR'S WORK PRODUCT.

I HEREBY CERTIFY THAT THE ABOVE DESCRIBED PROPERTY HAS BEEN SURVEYED UNDER MY DIRECTION AND THAT THE ABOVE MAP IS A TRUE REPRESENTATION THEREOF AND SHOWS THE SIZE AND LOCATION OF THE PROPERTY AND ITS EXTERIOR BOUNDARIES. THIS SURVEY IS MADE FOR THE USE OF THE PRESENT OWNERS OF THE PROPERTY, AND ALSO THOSE WHO PURCHASE, MORTGAGE, OR GUARANTEE THE TITLE THERETO WITHIN ONE YEAR FROM THE DATE HEREOF.

REVISED 11/23/2004 TO SHOW SIZE & LOCATION OF AS-BUILT RESIDENCE

= SET IRON REBAR STAKE

= FOUND IRON PIPE STAKE

(XXX) = RECORDED AS

PROJECT: 6103.53 DATE: 06/24/2004 SHEET 1 OF 1

904-1802

PETER S. GORDON R.L.S. 2101 YEWI 00053

DATED: JUNE 23,