


121-4

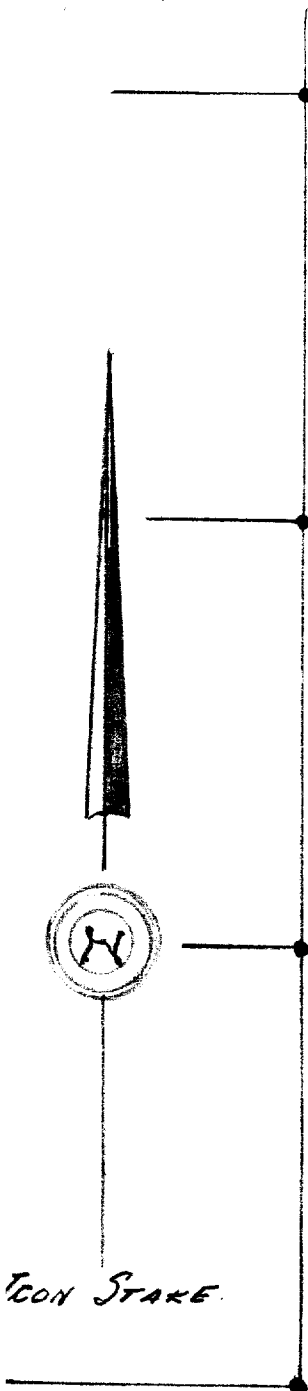

IRON STAKE

66.0'

ST.

SOUTH CHURCH


ST.

WEST

CENTRALIA

ST.

58-46

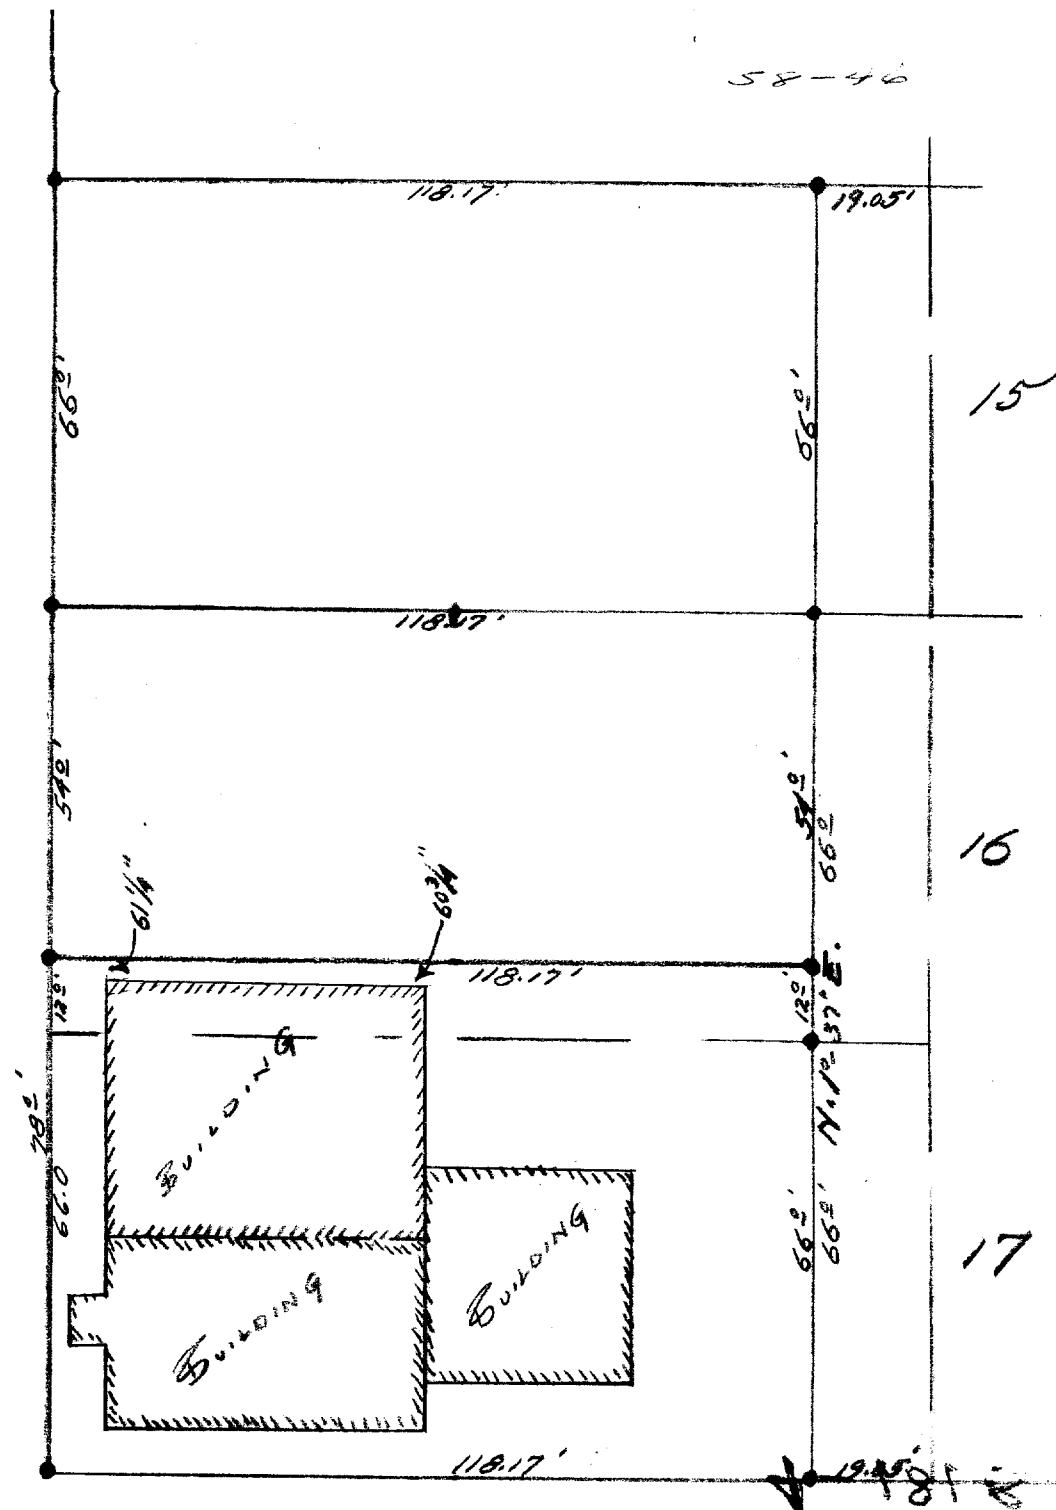

15

16

17

2-181B

U-SW-48.48A.52 NE 1/4-1-2