



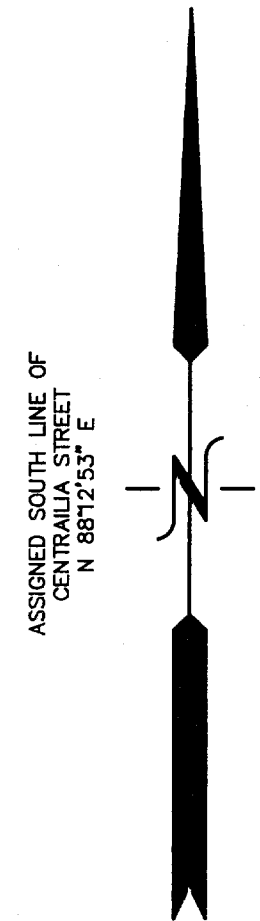

PLAT OF SURVEY
LOT 6 OF ALDER SUBDIVISION
LOCATED IN THE NW 1/4 OF SECTION 1,
TOWN 2 NORTH, RANGE 16 EAST,
CITY OF ELKHORN, WALWORTH COUNTY, WISCONSIN

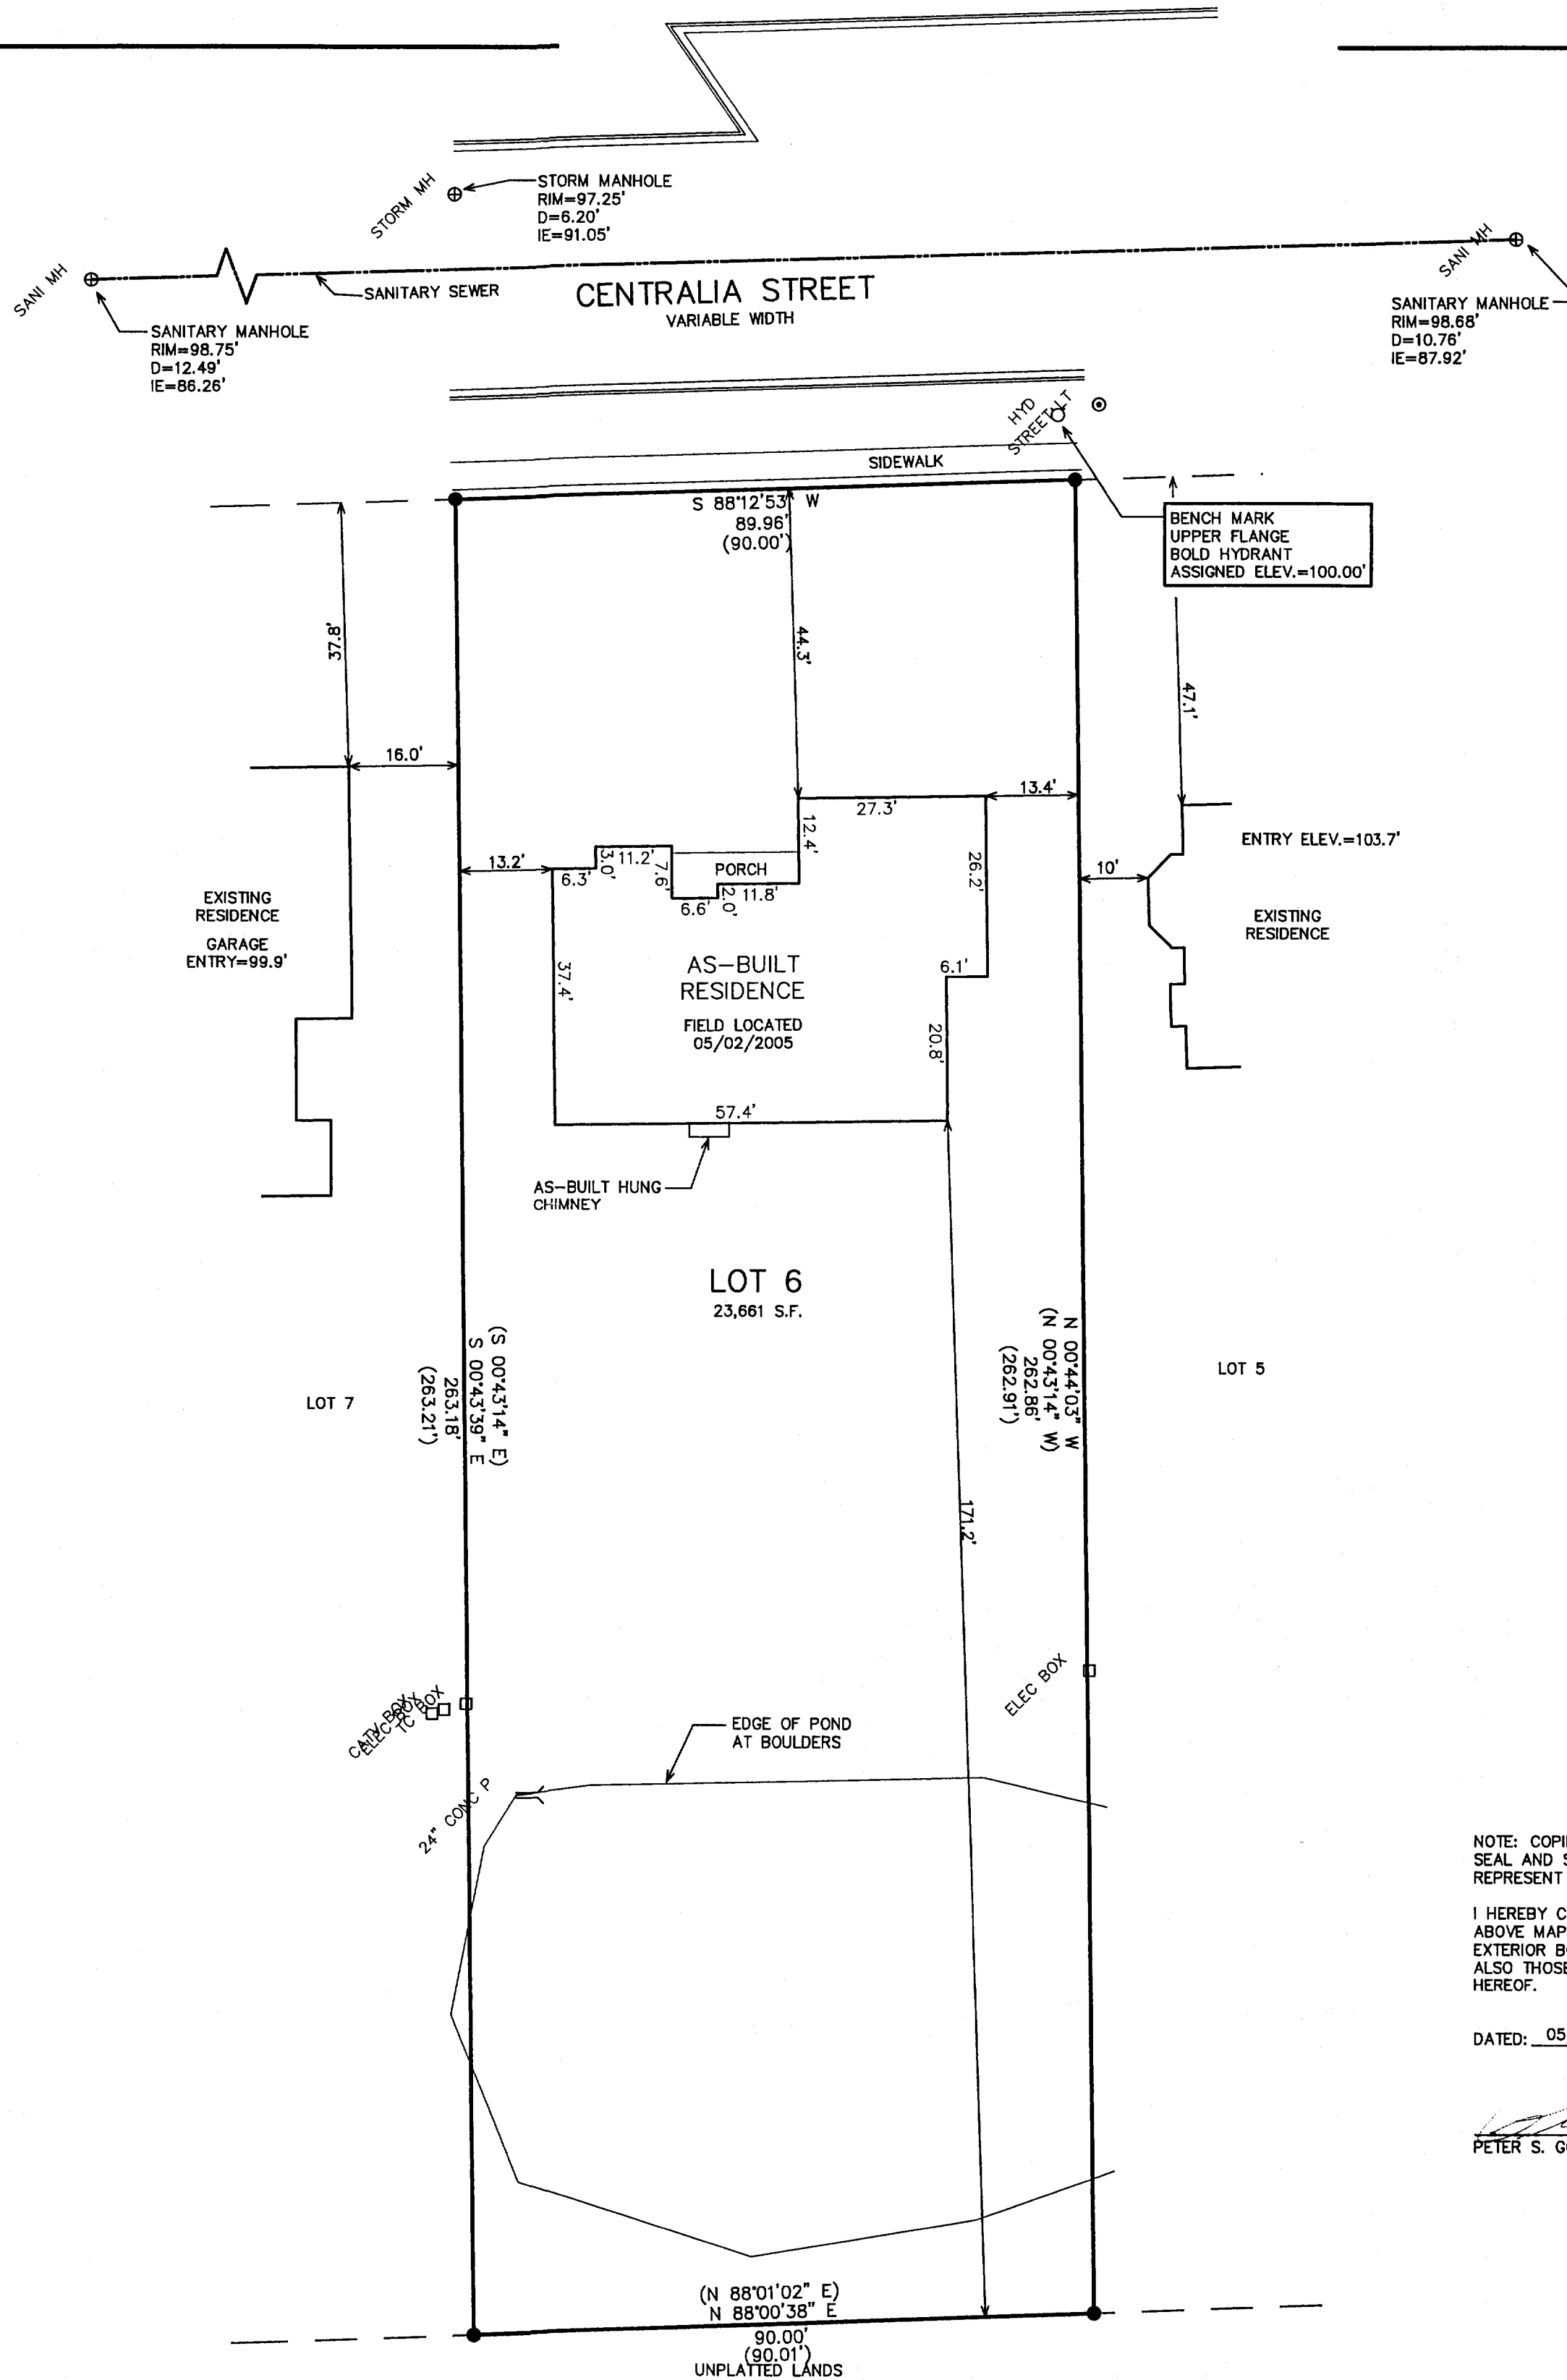

WORK ORDERED BY -
PAT MCCOLE - MARQUIS CONSTRUCTION
2827 COUNTY TRUNK "K"
FRANKSVILLE, WI 53126

FARRIS, HANSEN & ASSOCIATES, INC.
ENGINEERING - ARCHITECTURE - SURVEYING
7 RIDGWAY COURT P.O. BOX 437
ELKHORN, WISCONSIN 53121
OFFICE: (262) 723-2098 FAX: (262) 723-5886

REVISIONS
10/08/2004
SHOW SIZE &
LOCATION OF
PROPOSED
RESIDENCE
11/01/2004
SHOW SIZE &
LOCATION OF
PROPOSED
DECK

PROJECT NO.
6280
DATE:
05/22/03
SHEET NO.
1 OF 1