

PLAT OF SURVEY

RSV

ENGINEERING, INC.

Engineers • Land Surveyors • Environmental Scientists
801 MAIN STREET MUKWONAGO, WISCONSIN 53149 (262)363-2004

RECERTIFICATION
DATE: 04/21/05

FOR: INFINITY BUILDERS


DATE: 11/18/2004

DESCRIPTION: BEING ALL THAT PART OF LOT 132 THE PINE SUBDIVISION LOCATED IN PART OF THE NW, NE, SW, AND SE 1/4 OF THE SW 1/4 AND THE SW AND NW 1/4 OF THE SE 1/4 OF SECTION 5, TOWN 2 NORTH, RANGE 17 EAST, CITY OF ELKHORN, WALWORTH COUNTY, WISCONSIN.

MODEL TYPE: CYPRESS AMERICAN
GARAGE LEFT





SCALE 1" = 30'

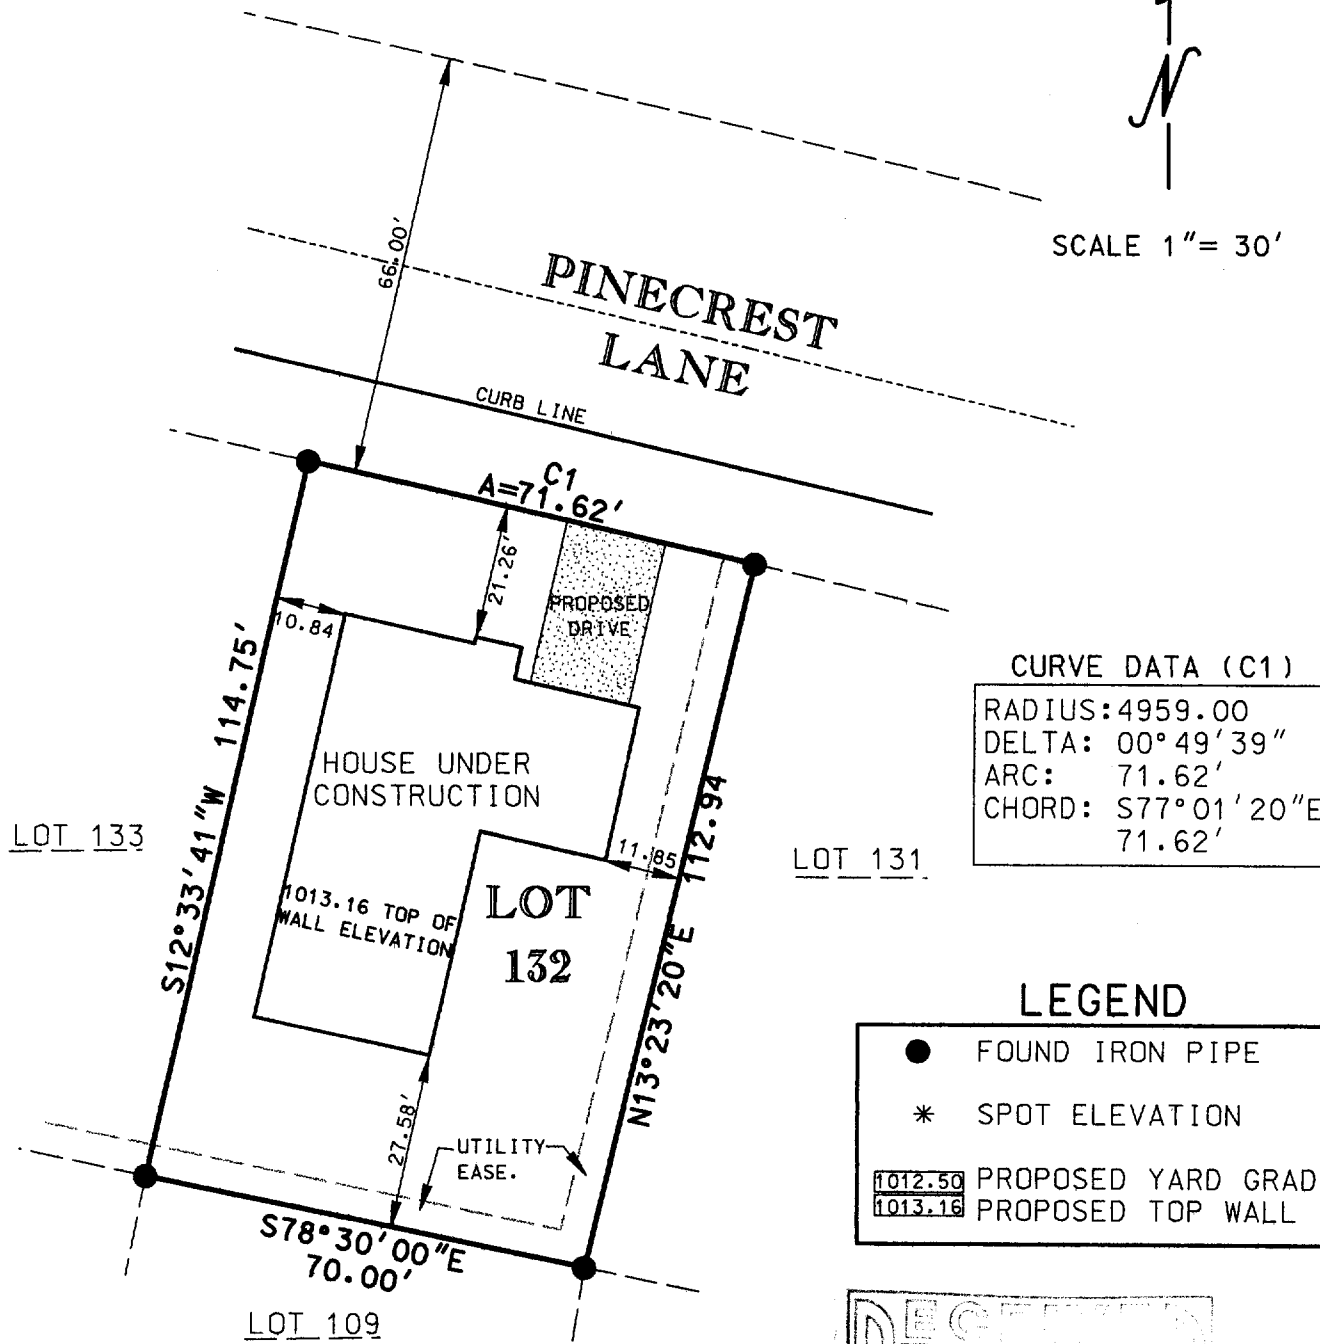

I PAUL H. VAN HENKELUM R.L.S. # 1931 HEREBY CERTIFY THAT THIS SURVEY WAS MADE IN ACCORDANCE WITH THE MINIMUM STANDARDS FOR PROPERTY SURVEYS (CHAPTER A-E7) STATE OF WISCONSIN AND HAS BEEN PREPARED UNDER MY DIRECTION AND CONTROL AND IS CORRECT TO THE BEST OF MY KNOWLEDGE AND BELIEF.

Paul H. Van Henkelum 4/25/05

PAUL H. VAN HENKELUM, R.L.S. # 1931
RSV DATA6/04/SURVEYS/J04268recrt.DGN

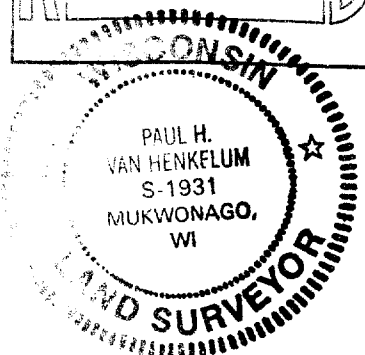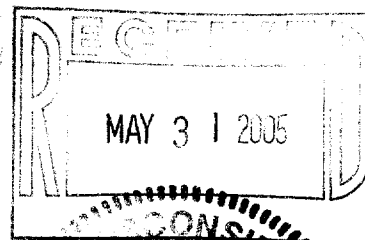

UPI 00132

004-1879