


Plat of Survey

of

A parcel of land described in a Warranty Deed recorded May 3, 2005 as Document No. 638699 as shown below:

Part of the SE 1/4 of Section 24 and the NE 1/4 of Section 25 in T3N, R16E, City of Elkhorn, described as follows: Commencing at the SE corner of Sec. 24 T. 3 N., R. 16 E., Walworth County, Wisconsin; thence S. 03° 02' 34" W. along the East line of said Section 397.64 feet to a point, thence S. 41° 35' 20" E. 68.38 feet to a point, thence S. 48° 24' 40" W. 840.00 feet to a point on the SWly ROW line of Interstate Hwy. #12, the place of beginning of the lands hereinafter described, to-wit: thence S. 88° 42' 20" W. 83.12 feet, thence S. 03° 17' 40" E. 540.15 feet, thence S. 87° 24' 40" W. 534.44 feet, thence N. 03° 15' 40" W. 1331.00 feet, thence S. 87° 23' 00" W. 329.80 feet, thence N. 03° 04' 00" W. 1037.70 feet to the SWly ROW line of Interstate Hwy. #12, thence S. 41° 35' 20" E. along the SWly ROW line of said Hwy. 349.55 feet, thence S. 32° 41' 00" E. along said ROW line 840.30 feet, thence S. 23° 55' 40" E. along said ROW line 889.80 feet to the place of beginning.

Surveyed for: Duane Newman  
N5488 Newman Drive  
Elkhorn, Wisconsin. 53121


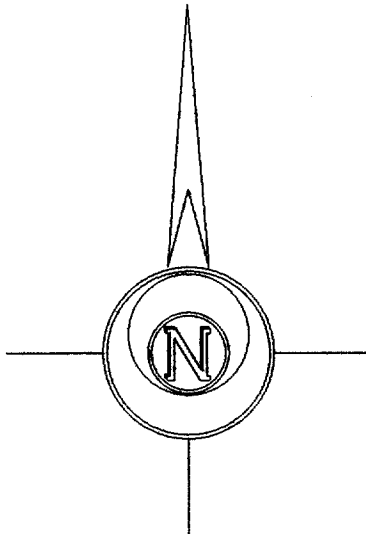


Copyright c 2005 by Jensen & Olson Land Surveying, LLC.

All rights reserved. No part of this survey plat may be reproduced or transmitted in any form by any means - graphic, electronic, or mechanical, including photocopying, tracing, or information storage and retrieval systems - without permission in writing from Douglas G. Olson, Jensen & Olson Land Surveying, LLC.

I hereby certify that I have surveyed the above described property and the map hereon is correct to the best of my professional knowledge and belief and shows the size and location of the property, its exterior boundaries, the location and dimensions of all visible structures thereon, boundary fences, apparent easements and roadways and visible encroachments, if any.  
This survey is made for the exclusive use of the present owners of property, and also those who purchase, mortgage or guarantee title thereto, within one year from the date hereof.

Douglas G. Olson  
Wisconsin Registered Land Surveyor - 2093

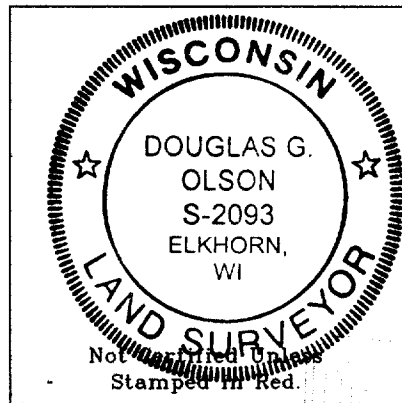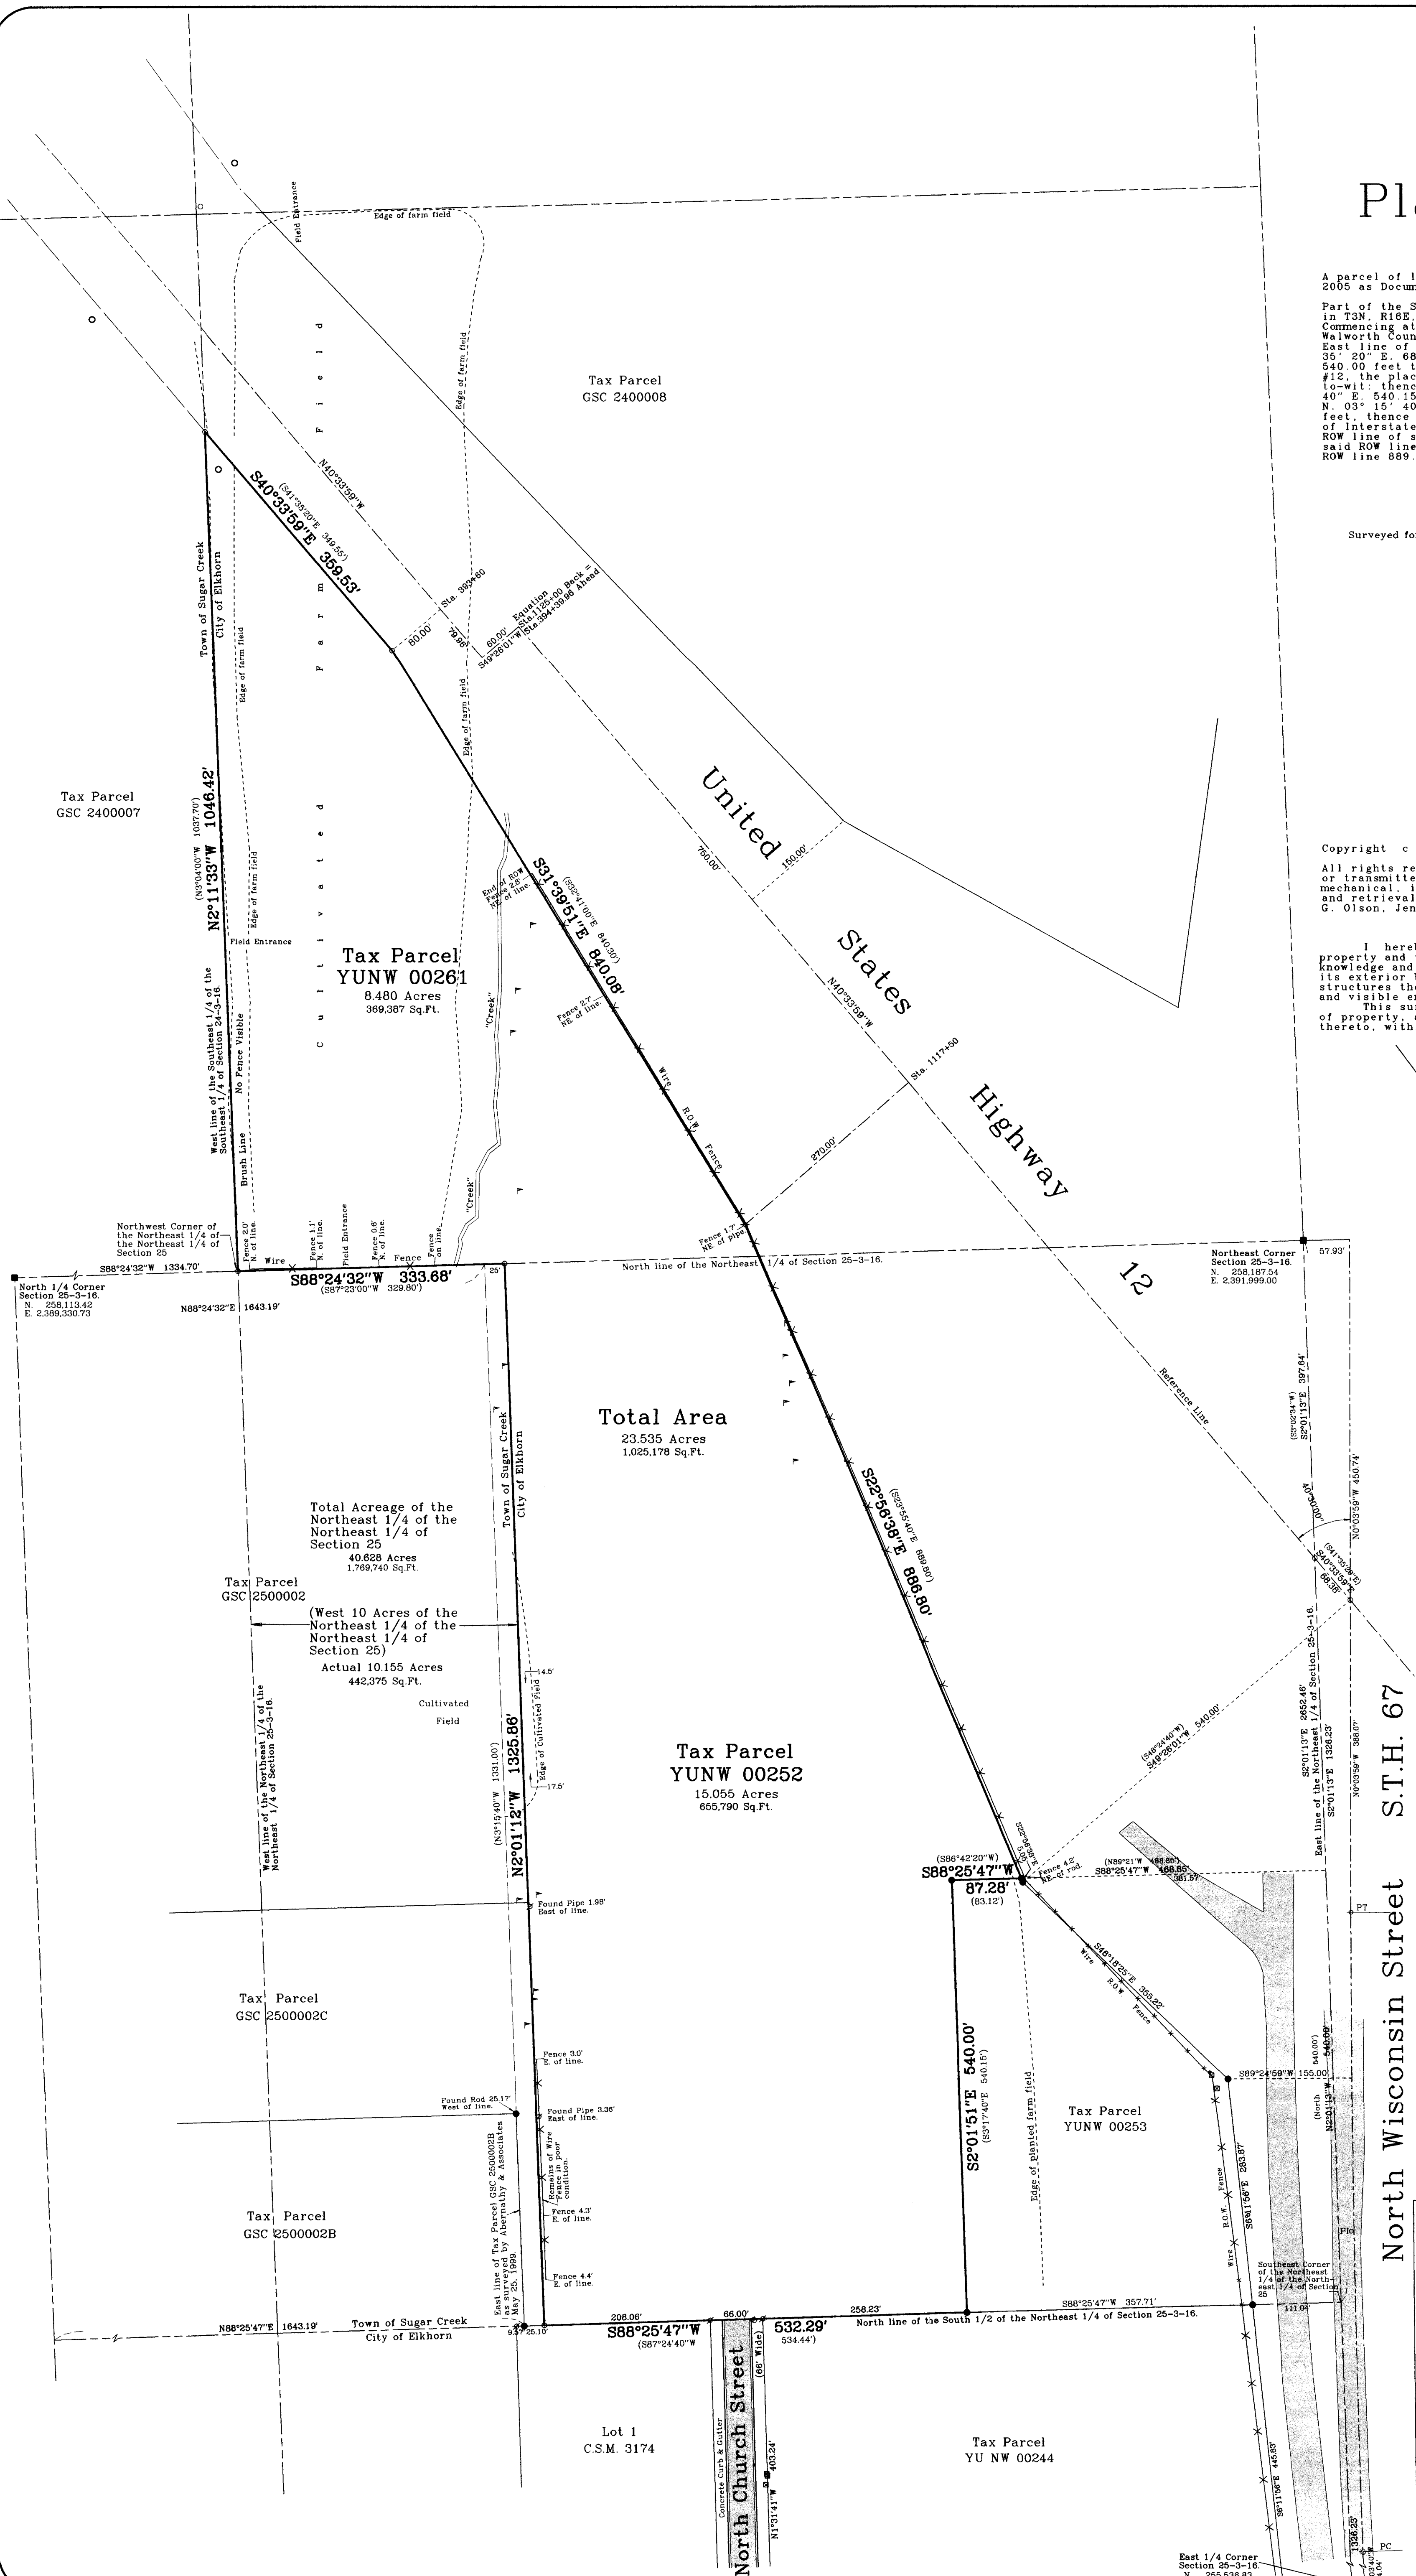

Notes: 1) This survey plat is not certified unless signed and sealed in red ink.  
2) This survey is subject to Wisconsin lien laws. This Plat of Survey is the notice of intent to file lien. Lien waiver required.

2005.051

Sheet 1 of 1 Sheets.

Job Reference Number

2005.051

Legend

- Found County Section Corner
- Found Iron Pipe
- Found Iron Rod 3/4" dia.
- Set Iron Rod 3/4" dia.
- Recorded Information
- Manhole
- Fire Hydrant
- Water Valve
- Utility Pedestal
- Light Pole
- Asphalt Surface

Wetland flag placed by others. Appears to be an old flagging with many flags missing.

Jensen & Olson Land Surveying, LLC

45 South Wisconsin Street P.O. Box 322  
Elkhorn, Wisconsin. 53121  
Telephone: (262) 723-3434  
Facsimile: (262) 723-8044

Scale in Feet

1" = 100'

Survey date: May 12, 2005.

Revisions:

94 NW 00252 004-1935