



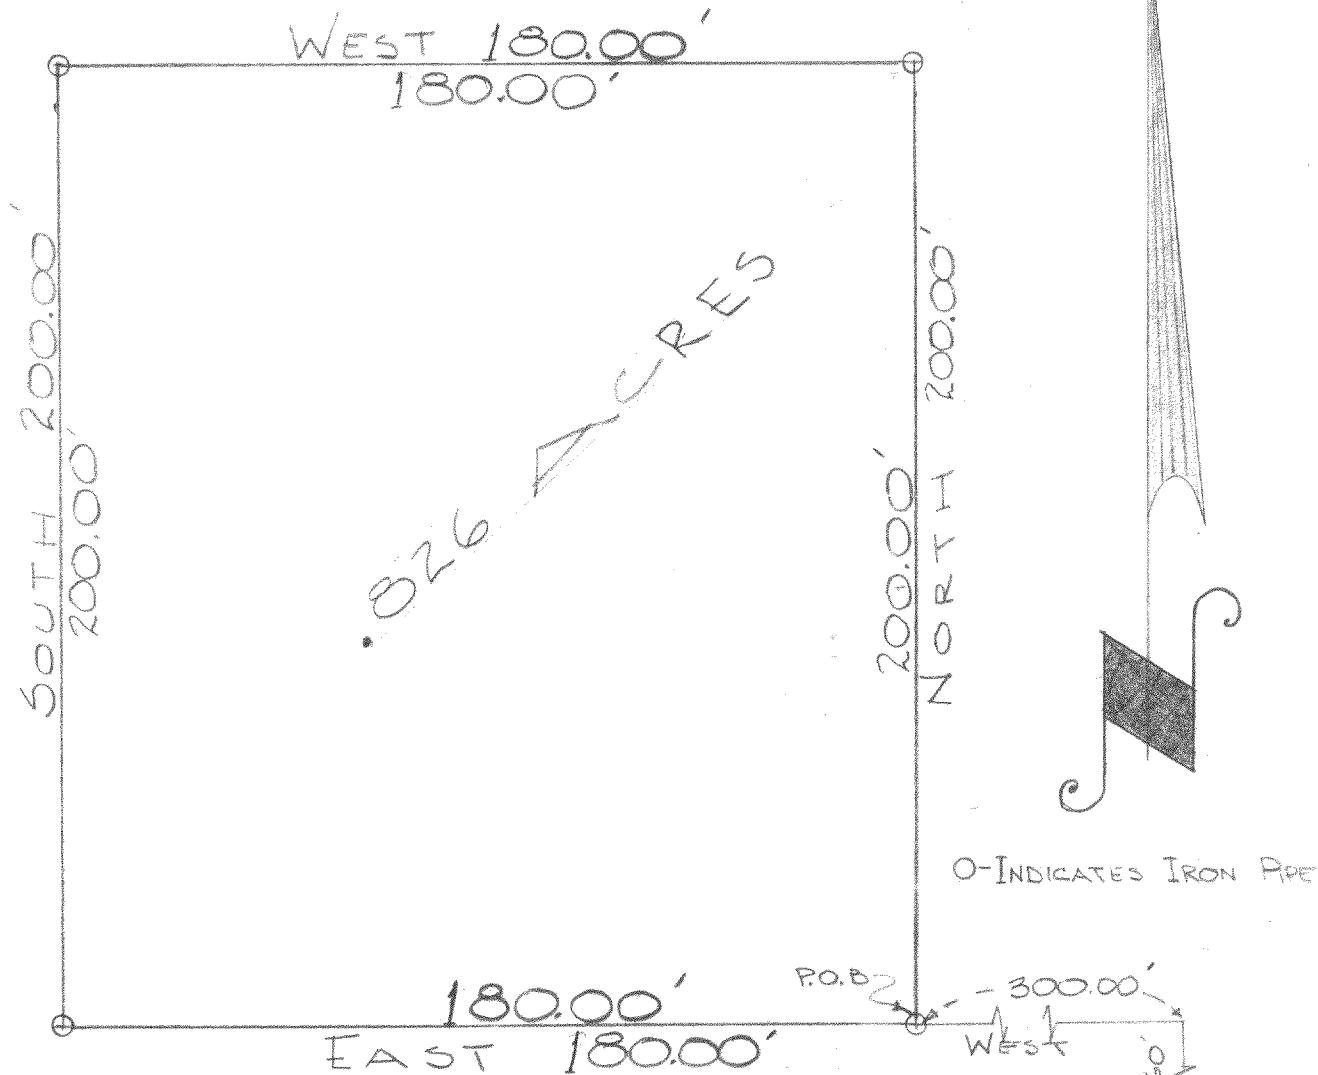

DESCRIPTION: A parcel of land located in the $\frac{1}{2}$ of the SE $\frac{1}{4}$ of Sec. 25, T. 3 N., R. 16 E. described as follows, to wit:

Commencing at a point in the East line of said section which point is located 435.60 feet north of the Southeast corner of said section, thence West 300.00 feet to an iron stake which is the place of beginning; continue thence north 200.00 feet to an iron stake which is 300.00 feet West of the East line of said section, thence West 180.00 feet to an iron stake, thence South 200.00 feet to an iron stake, thence East 180.00 feet to the place of beginning.

CERTIFICATE: I, James F. Biagi, surveyor do hereby certify that I have surveyed the property hereon described.
August 18, 1962.

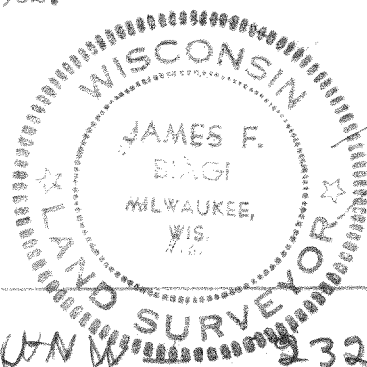

James F. Biagi

Part of UNW 232

4-197B