


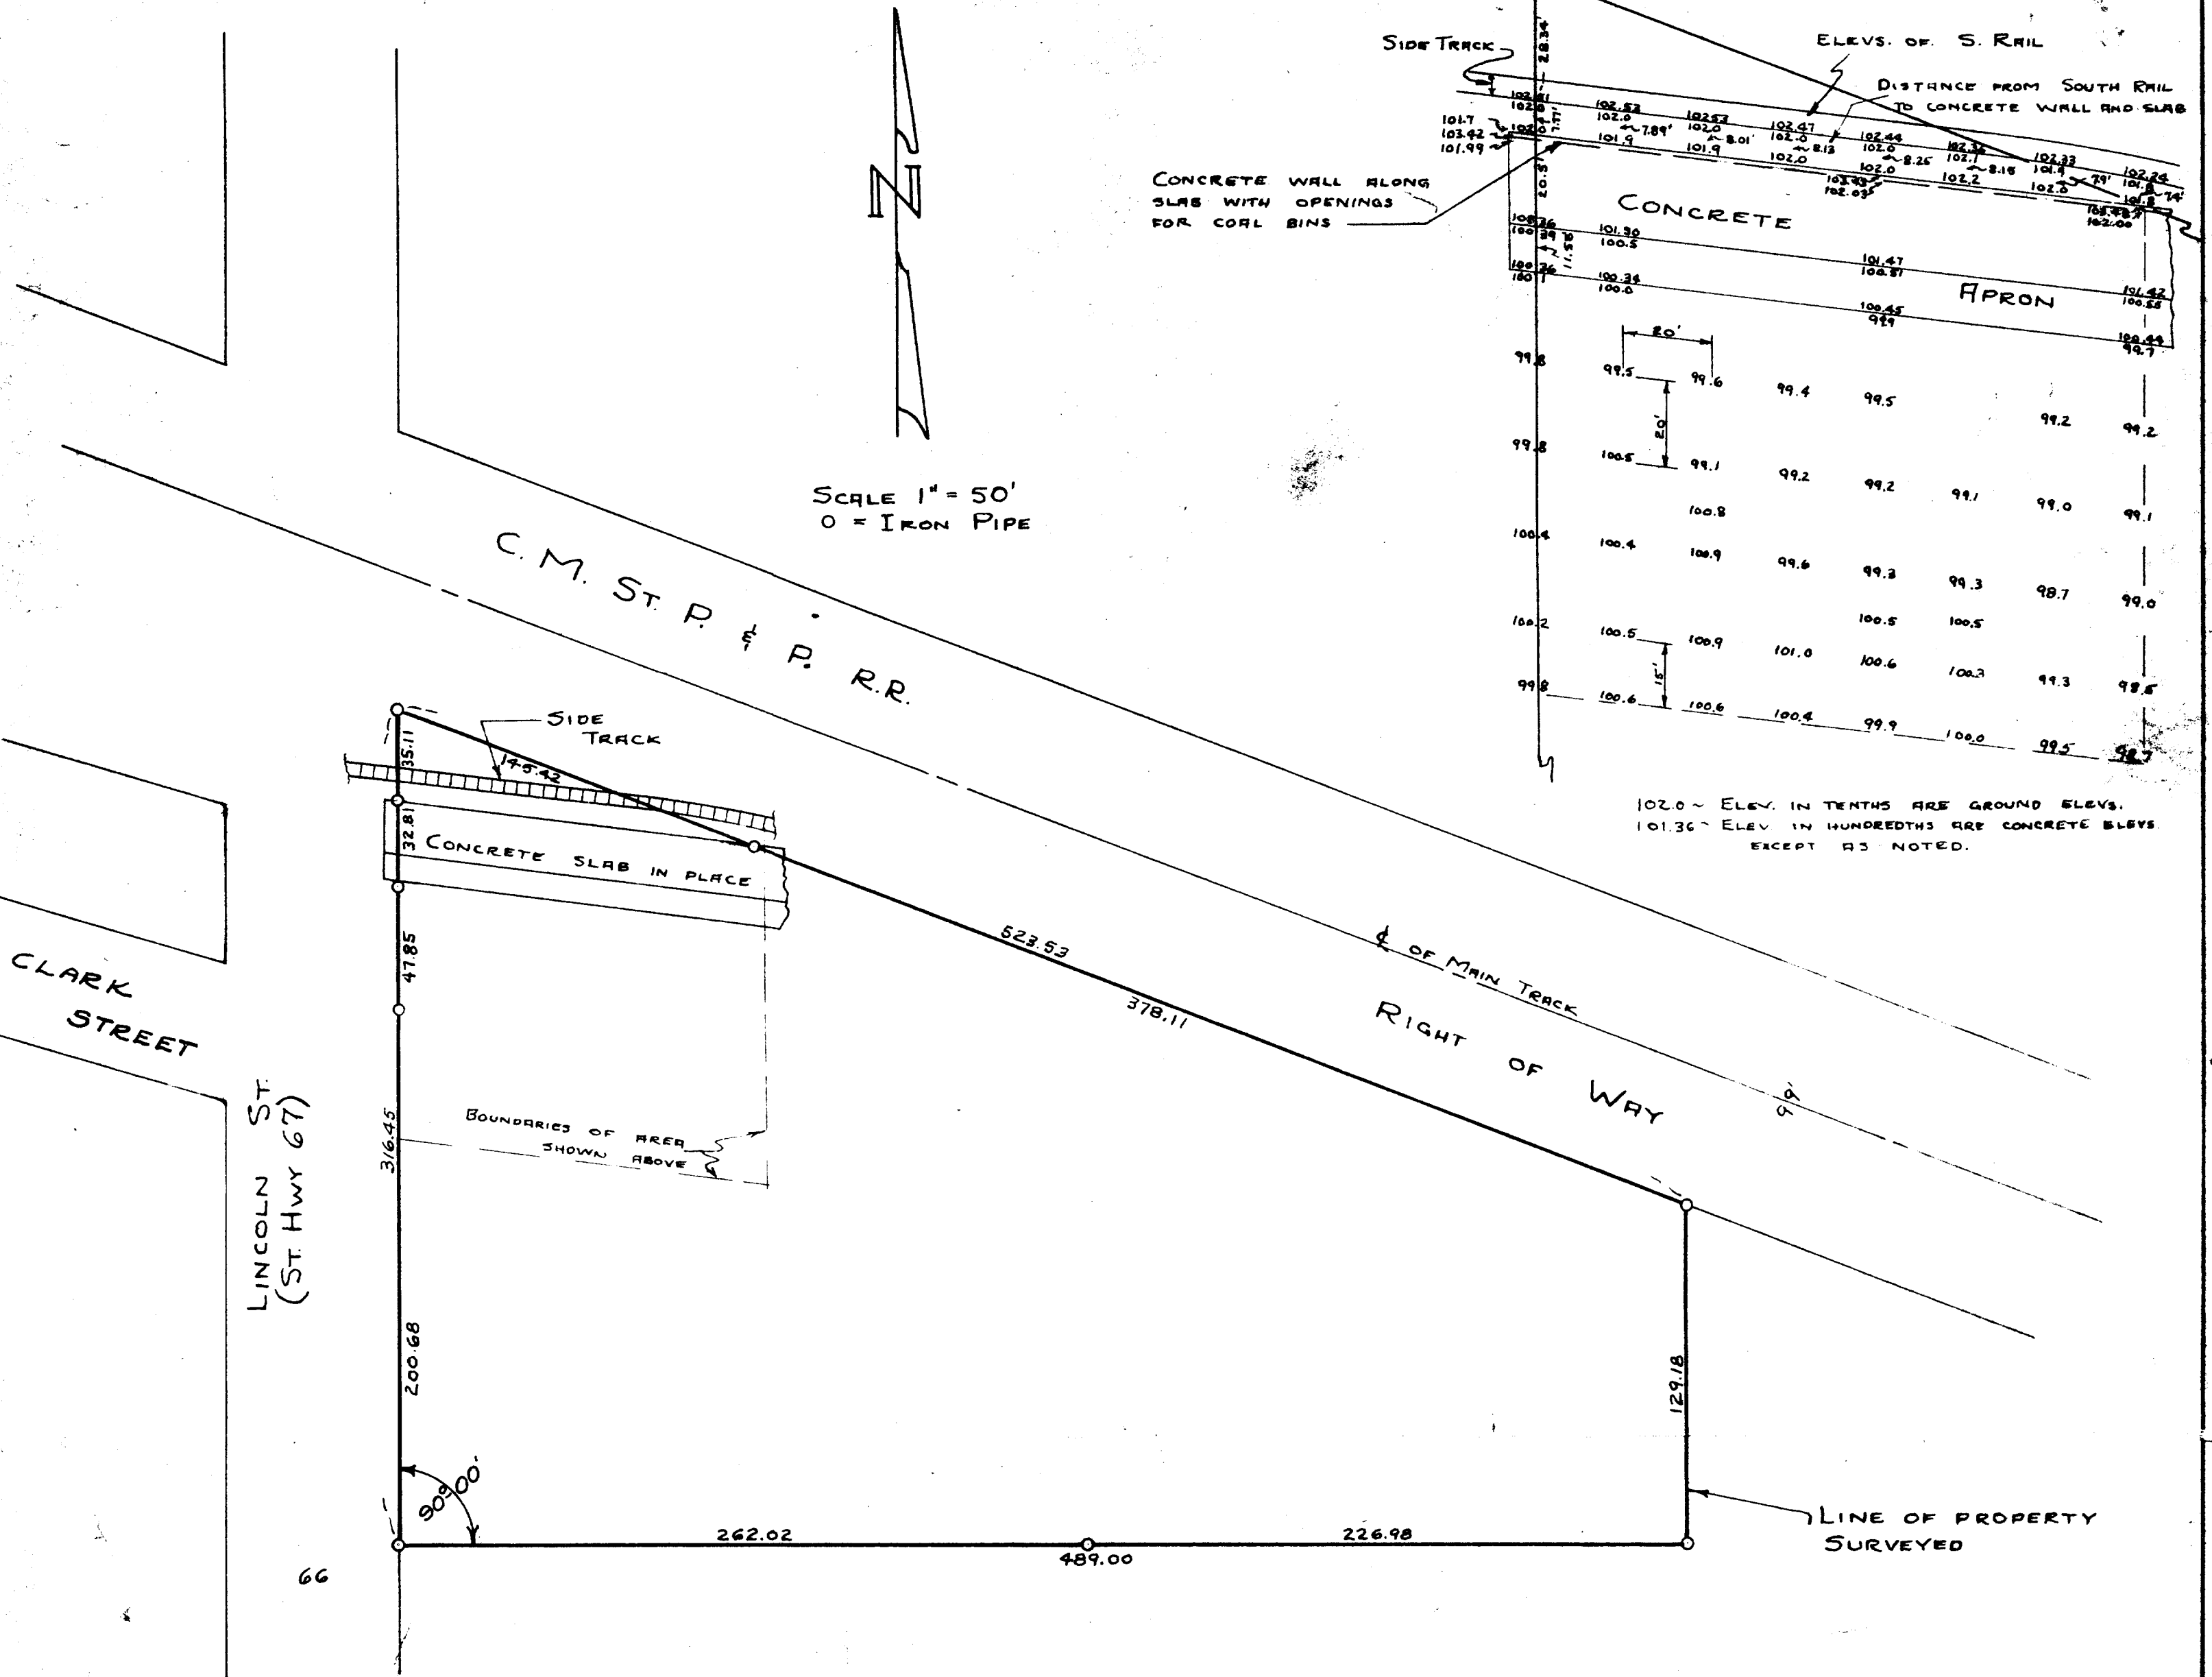

PLAT OF SURVEY OF LAND PURCHASED BY THE ELKHORN LUMBER COMPANY
LOCATED IN THE NW $\frac{1}{4}$ OF SECTION 6, T2N R17E, IN THE CITY OF
ELKHORN, WALWORTH COUNTY, WISCONSIN

SEPT. 1949

Lloyd L. Jensen
COUNTY SURVEYOR

DESCRIPTION OF LAND SURVEYED

Commencing at a point where the E'ly line of East Street intersects the S'ly line of the Chicago, Milwaukee, St. Paul & Pacific Railway Company's right of way through the City of Elkhorn and which point is more particularly described as the NW corner of the real estate acquired by the grantors from Philomena Dunphy, John J. Dunphy, Helen Dunphy, Edward J. Dunphy, and Marie Dunphy by deed dated June 23, 1945 and recorded June 30, 1945 in Volume 333 of Deeds, Walworth County Records at page 369; thence S. from said point in the E'ly line of East Street 316.45 feet to a point; thence E. at right angles to the E'ly line of East Street 489 feet to a point; thence N. parallel to the E. line of East Street 129.18 feet to the S'ly line of the right of way of the Chicago, Milwaukee, St. Paul & Pacific Railway; thence NW'ly 523.53 feet in the S'ly line of the right of way of said railway company to the place of beginning, being in Section 6, T 2 N, R 17 E, Walworth County, Wisconsin, together with all buildings and improvements situated upon the premises.