

PLAT OF SURVEY

BEING ALL OF LOT 25 OF STONEGATE FARMS, LOCATED IN THE NW 1/4 AND SW 1/4 OF
THE NW 1/4 OF SEC. 1, T.2N., R.16E., CITY OF ELKHORN, WALWORTH COUNTY, WI.

SURVEYOR

DAVID T. BOSSHARD, RLS 2641
YAGGY COLBY ASSOCIATES
501 MAPLE AVE., P.O. BOX 180500
DELAFIELD, WISCONSIN 53018
(262)646-6855

SURVEY FOR


BIELINSKI CUSTOM HOMES
RE: CORNELSSEN
N16 W23377 STONE RIDGE DRIVE
WAUKESHA, WI 53188

LEGEND


- - 1" IRON PIPE FOUND
- ⊙ - 2" IRON PIPE FOUND
- - UTILITY BOX
- ⊗ - CURB STOP
- Ⓢ - MANHOLE
- ⊕ - BENCHMARK (AS NOTED)
- ⌚ - UTILITY POLE

11-17-2006

DMF

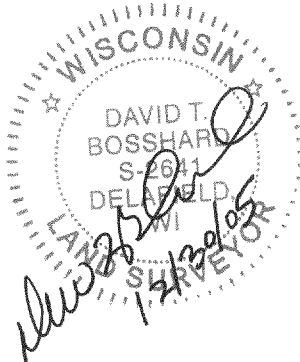

NOTE: THE MISSING LOT CORNER IRONS WERE
NOT RESET AT THIS TIME PER THE CLIENT'S
REQUEST. SIGNED LOT PIPE PLACEMENT
WAIVER ON FILE IN ACCORDANCE WITH AE
7.01(2) OF ADMIN. CODE.

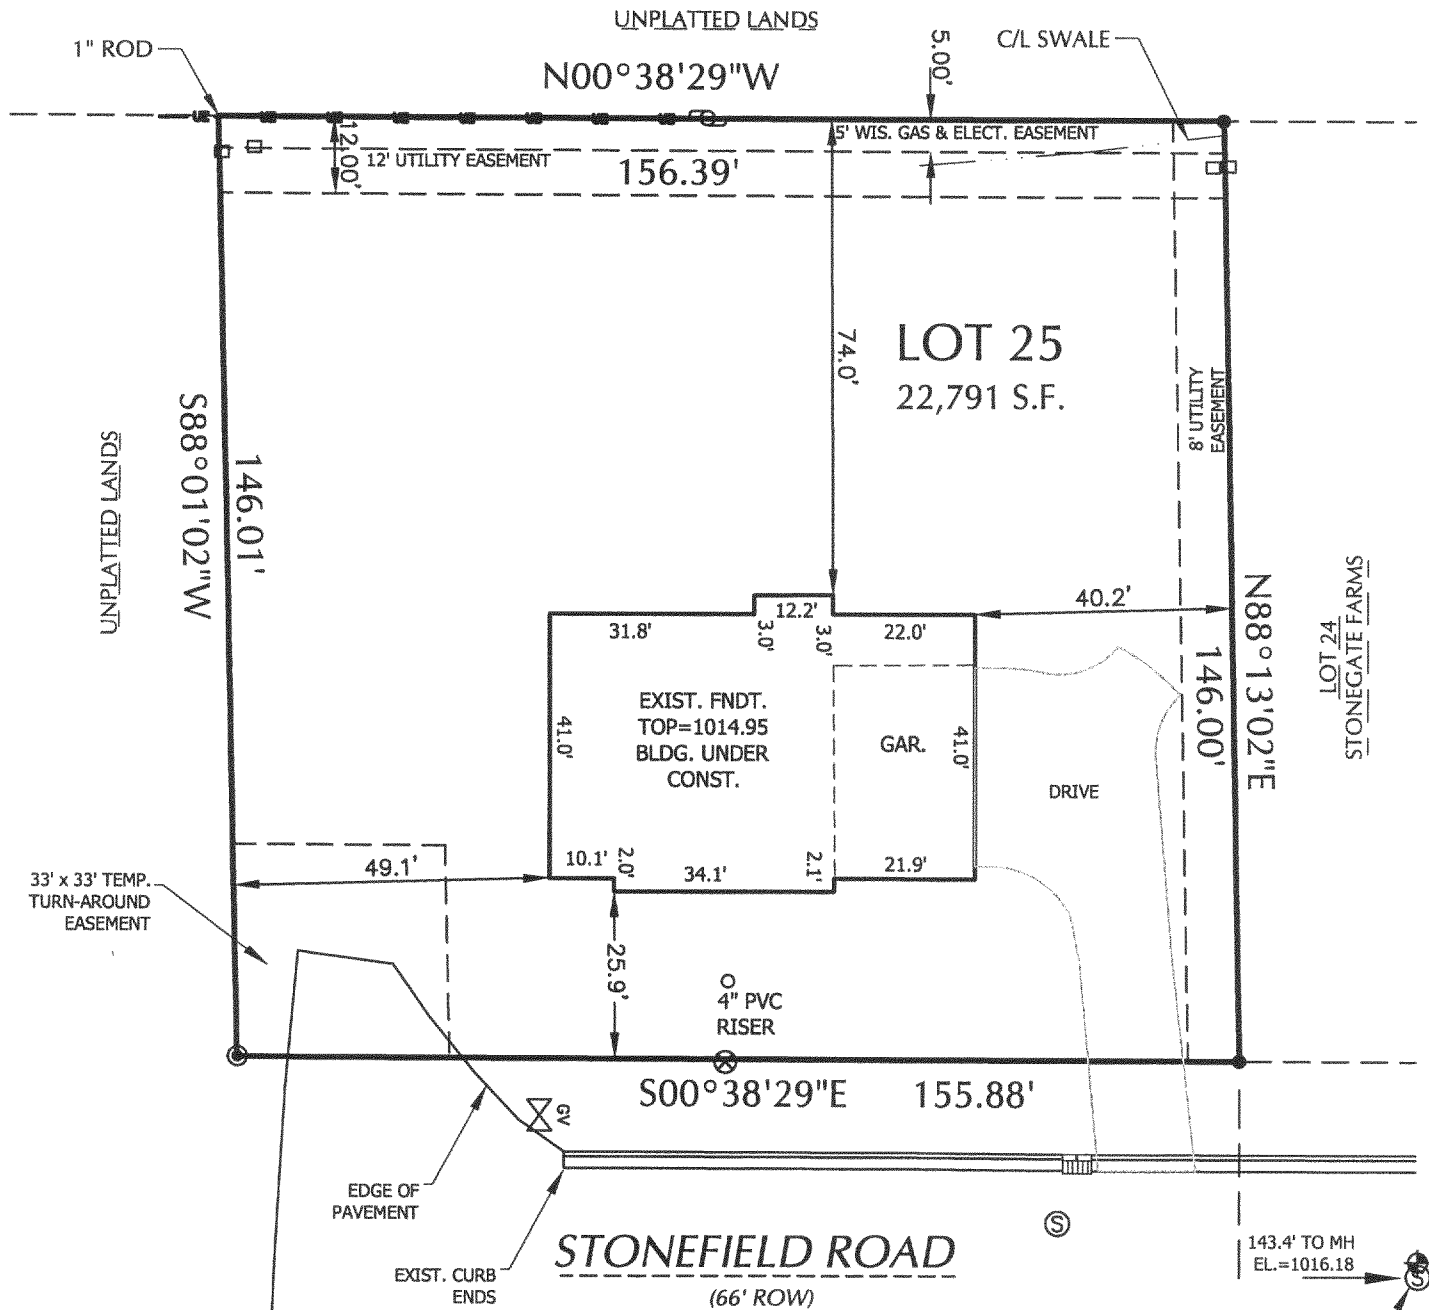

SURVEYOR'S CERTIFICATE:

I HEREBY CERTIFY THAT I HAVE SURVEYED THE ABOVE DESCRIBED PROPERTY AND THAT
THE ABOVE MAP IS A TRUE REPRESENTATION THEREOF AND SHOWS THE SIZE AND
LOCATION OF THE PROPERTY, ITS EXTERIOR BOUNDARIES, THE LOCATION OF ALL VISIBLE
STRUCTURES AND DIMENSIONS OF ALL PRINCIPAL BUILDINGS THEREON, BOUNDARY
FENCES, APPARENT EASEMENTS, ROADWAYS, AND VISIBLE ENCROACHMENTS, IF ANY.

THIS SURVEY IS MADE FOR THE USE OF THE PRESENT OWNERS OF THE PROPERTY, AND
ALSO THOSE WHO PURCHASE, MORTGAGE, OR GUARANTEE THE TITLE THERETO WITHIN
ONE (1) YEAR FROM DATE HEREOF.

YAGGY COLBY ASSOCIATES 501 MAPLE AVE., DELAFIELD, WI 262-646-6855
PATH: P:\B13163\B13163-197\DWG\B13163-197.DWG



SCALE : 1" = 30'

YSF - 25

004 - 2031