


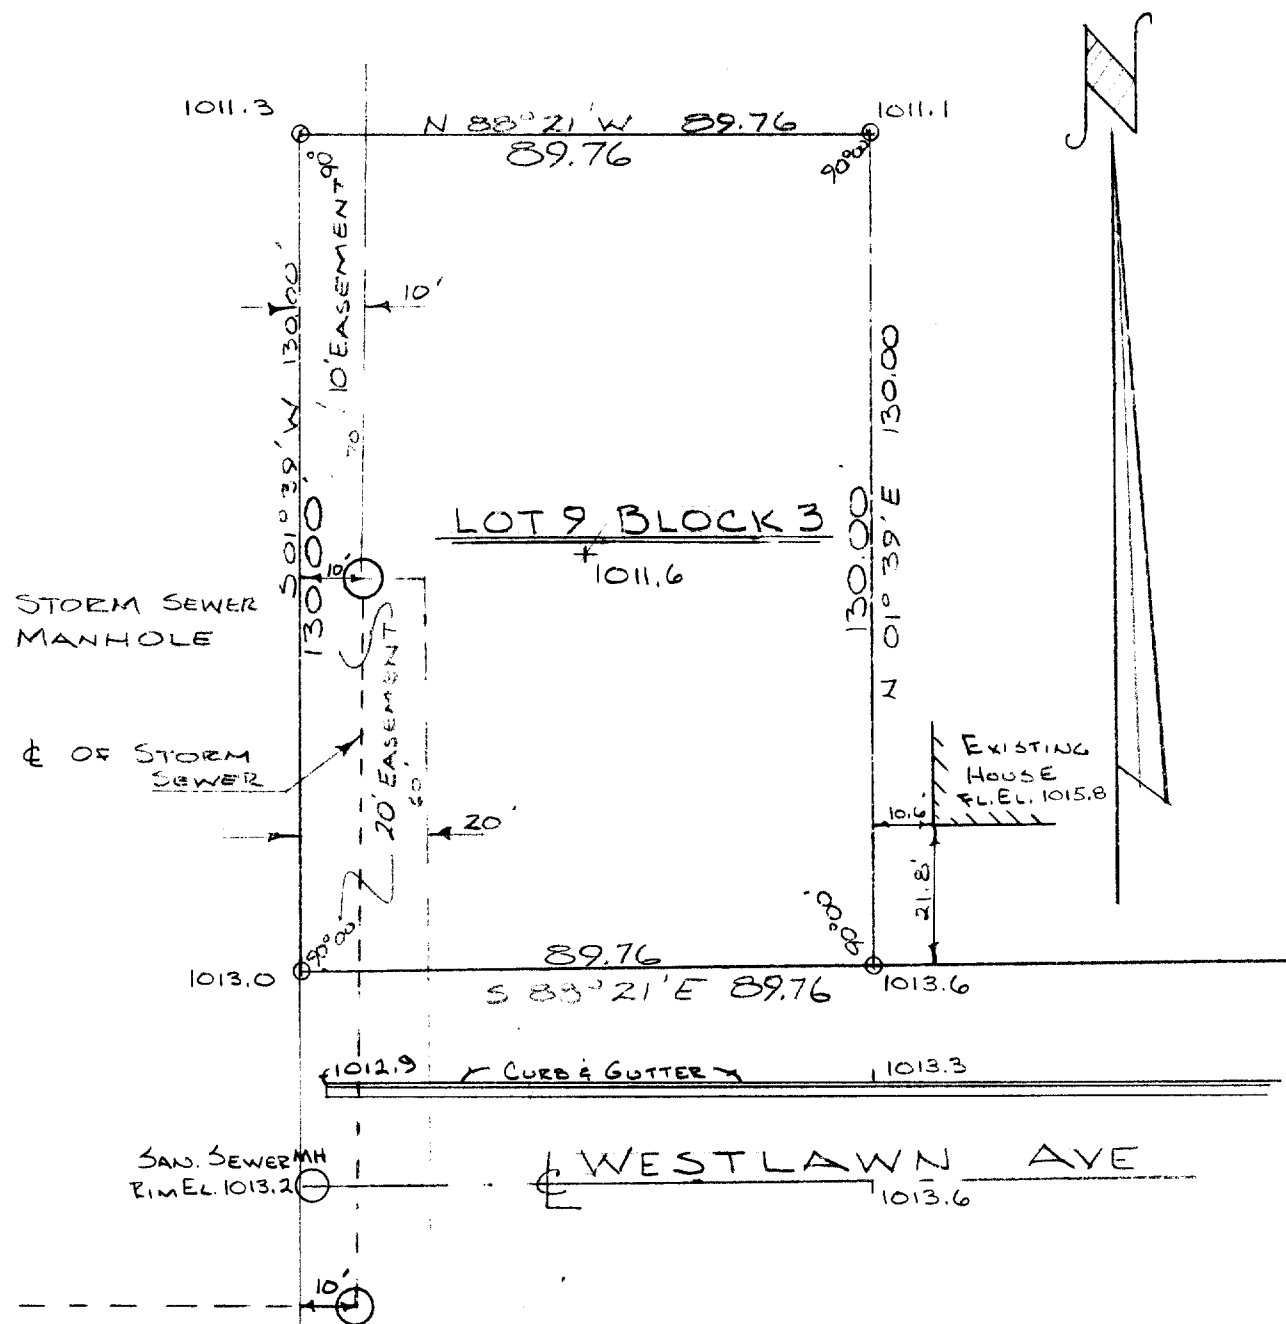

DESCRIPTION:


Lot 9 of Block 3 of Edgewood Second Addition located in the City of Elkhorn, Walworth County, Wisconsin.

CERTIFICATE:

I hereby certify that the above drawing correctly shows the storm sewer easements located in the above described property.

March 22, 1972.

James F. Biagi

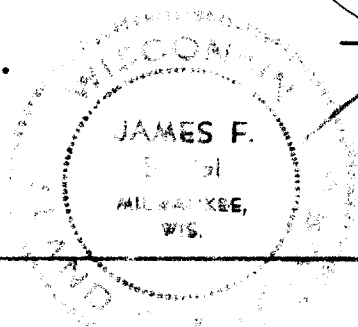

4EA2-1

4-29B