


PLAT OF SURVEY AND BUILDING LOCATION
FOR
BANCO MORTGAGE
OF

Part of Lot 7 in Block 5, Arnold's Addition to the Village (now City) of Elkhorn, Walworth County, Wisconsin, described as follows: Begin at the intersection of the North line of Geneva Street and the Easterly line of the old C.M. ST. P. & P. Railroad; thence South $89^{\circ}13'$ East 165.98 feet; thence North $0^{\circ}47'$ East 243.78 feet, to the centerline of the old Wisconsin Central Railroad; thence North $39^{\circ}41'$ West along said centerline, 1.95 feet; thence South $34^{\circ}40'05''$ West 295.44 feet to the point of beginning.

OWNER: Patrick and
Marie
Chudecke

BEARINGS ARE BASED ON
THE NORTH LINE OF
GENEVA ST., ASSUMED
BEARING $S 89^{\circ} 13' E$.

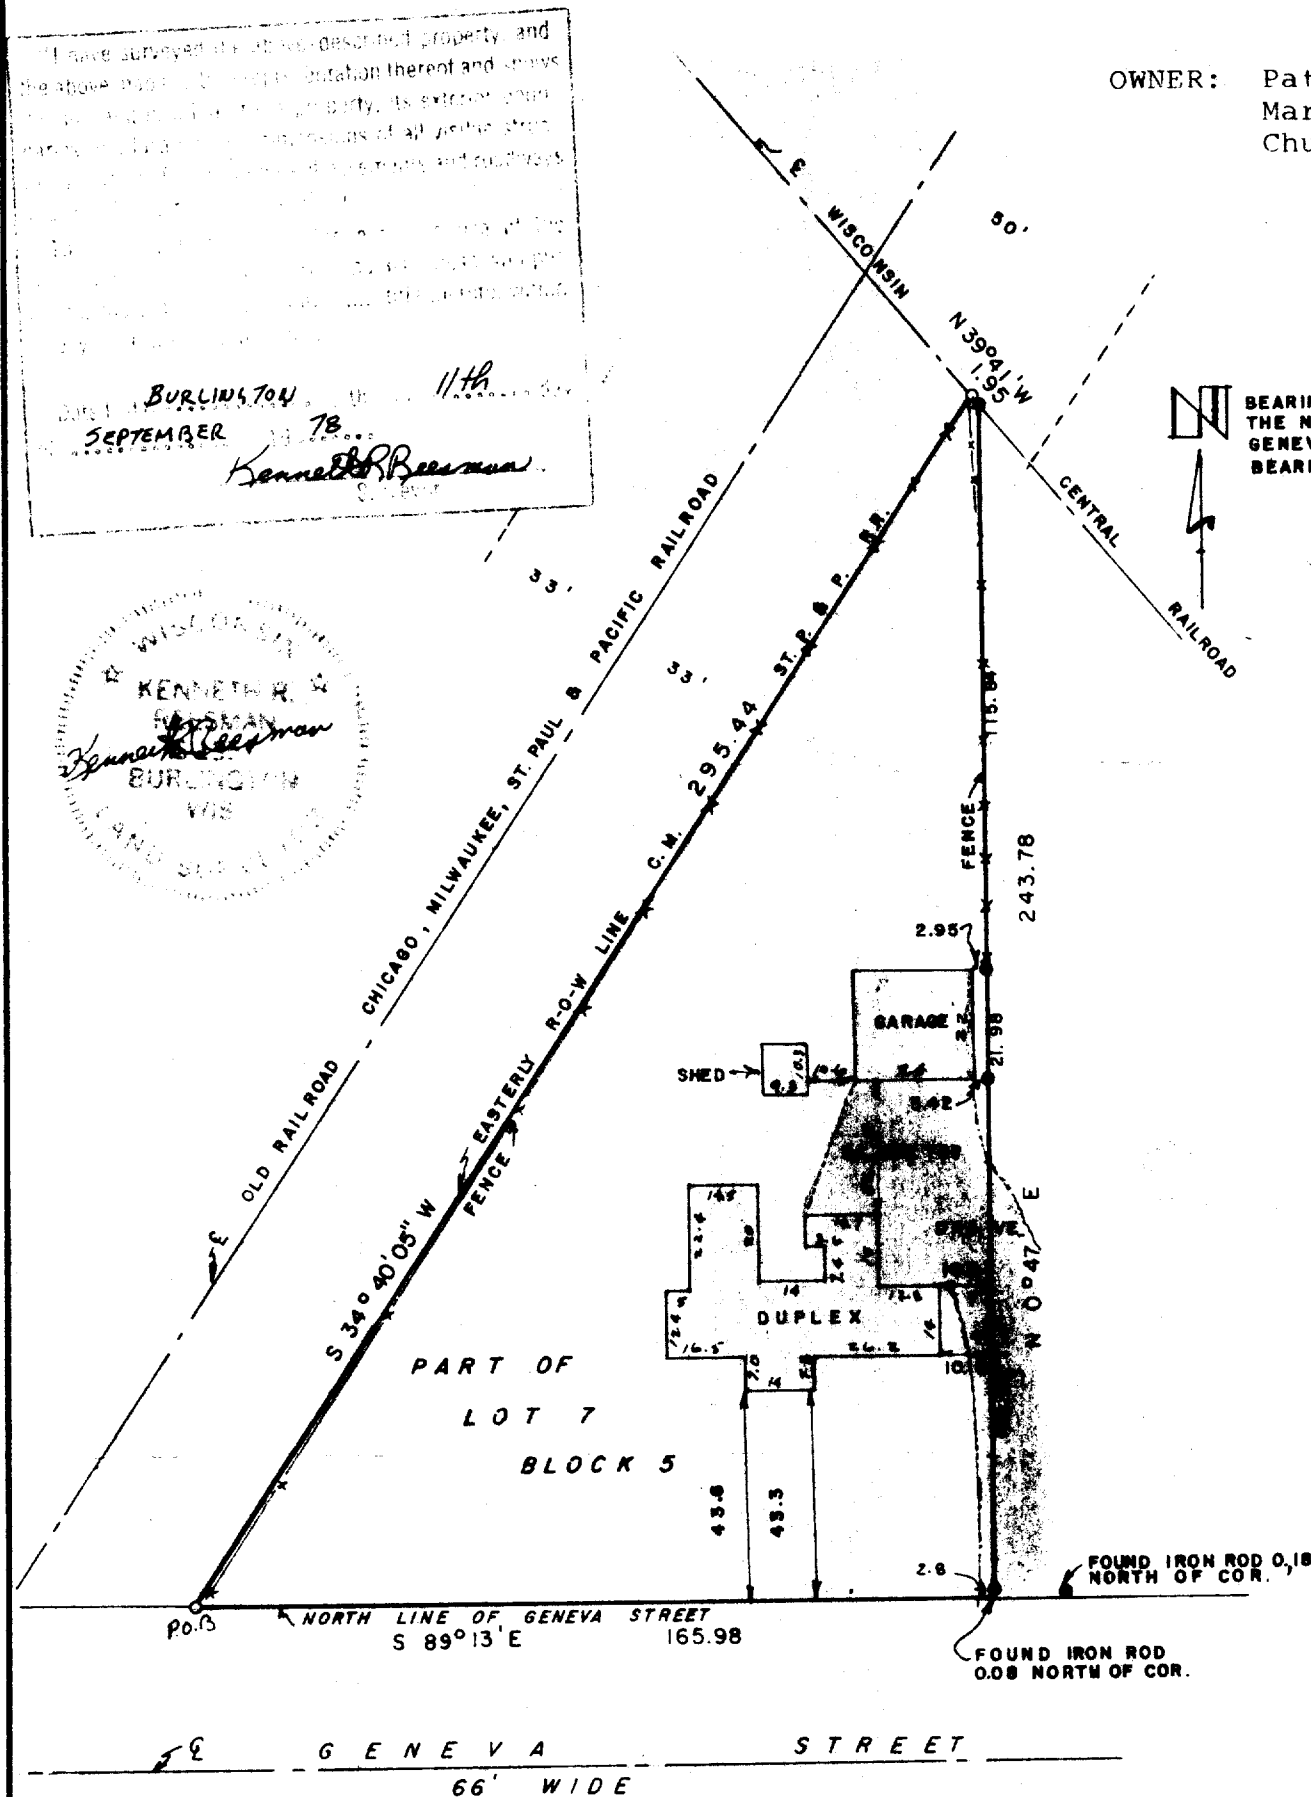

— L E G E N D —
● FOUND 5/8" SOLID IRON ROD
○ FOUND IRON PIPE
SCALE 1" = 40'
DATE: 9-11-78