

PLAT OF SURVEY




PART OF LOTS 8 & 9 OF BLOCK 26 OF THE ORIGINAL PLAT OF THE CITY OF ELKHORN LOCATED IN PART OF THE SE 1/4 OF SECTION 36, TOWN 3 NORTH, RANGE 16 EAST, CITY OF ELKHORN, WALWORTH COUNTY, WISCONSIN

That part of Lots 8 and 9 in Block 26 of the Original Plat of the City of Elkhorn, County of Walworth, State of Wisconsin, described as follows:

Part of Lot 9, Block 26, beginning at the Northeast corner of Lot 9, thence South 40 feet, thence West 72 feet, thence South 16 feet, thence West 60 feet, thence North 56 feet to the Northwest corner of Lot 9, thence East to the point of beginning; ALSO part of Lot 8, Block 26, beginning 20 feet South of the Northwest corner of Lot 8, thence East to East line of Lot, thence South 10 feet, thence West to West line of Lot, thence North 10 feet to the point of beginning, Original Plat to the City of Elkhorn, Walworth County, Wisconsin.

Tax Key No: YOP 00237

LEGAL DESCRIPTION OF RECORD TAKEN FROM TITLE COMMITMENT PROVIDED BY CLIENT

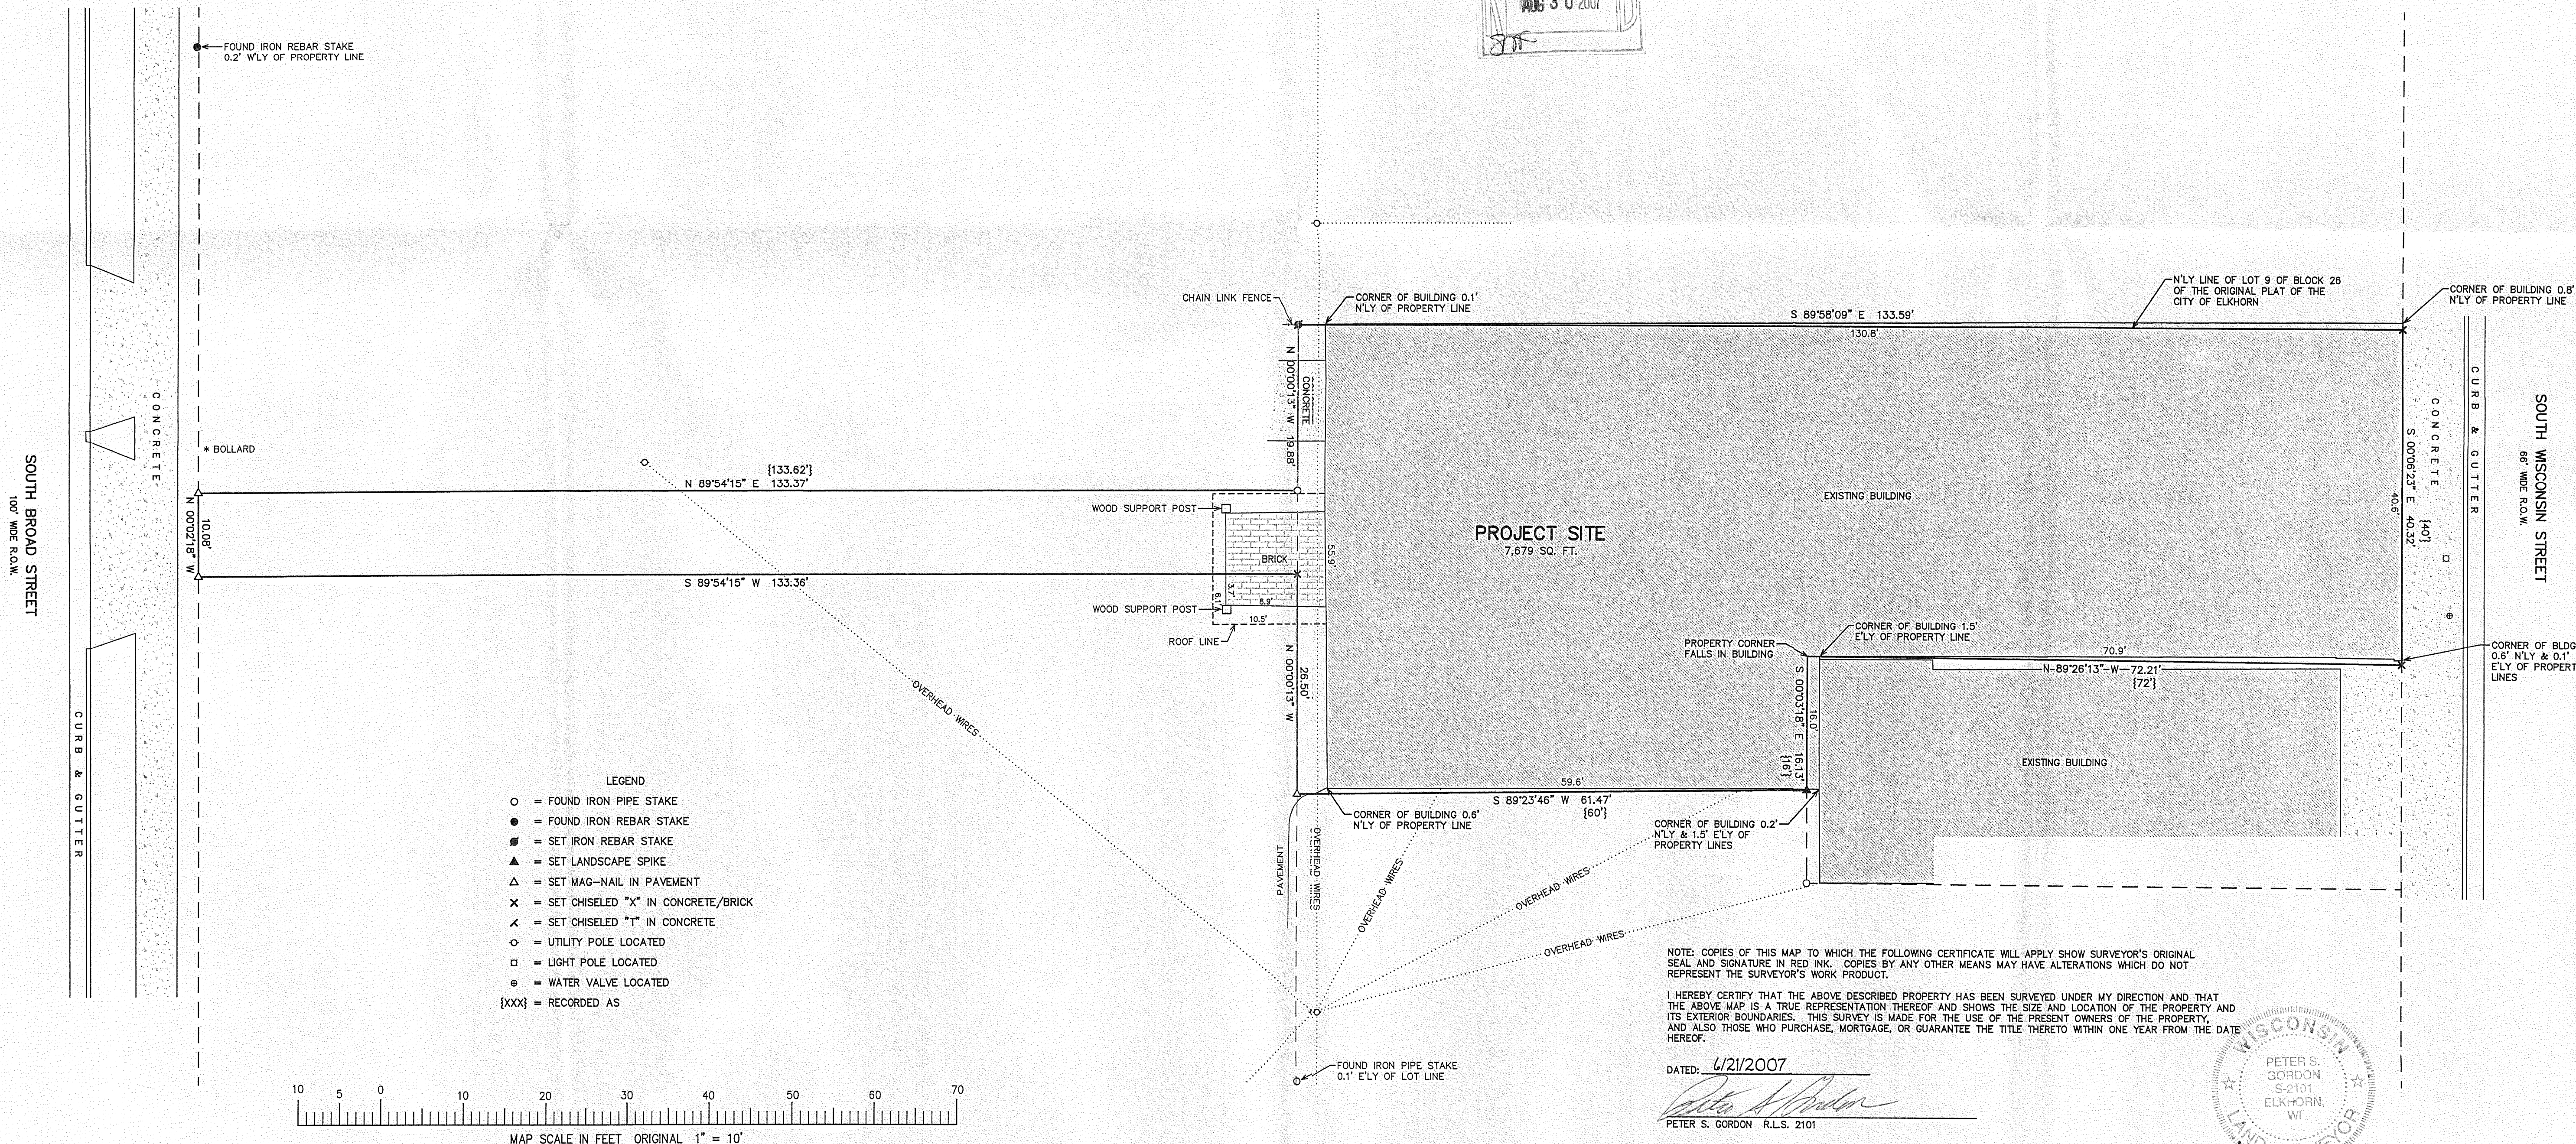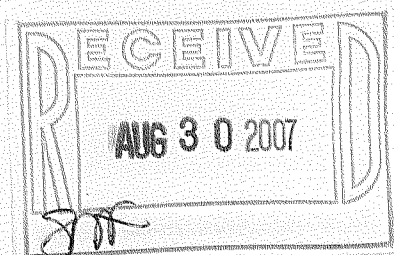
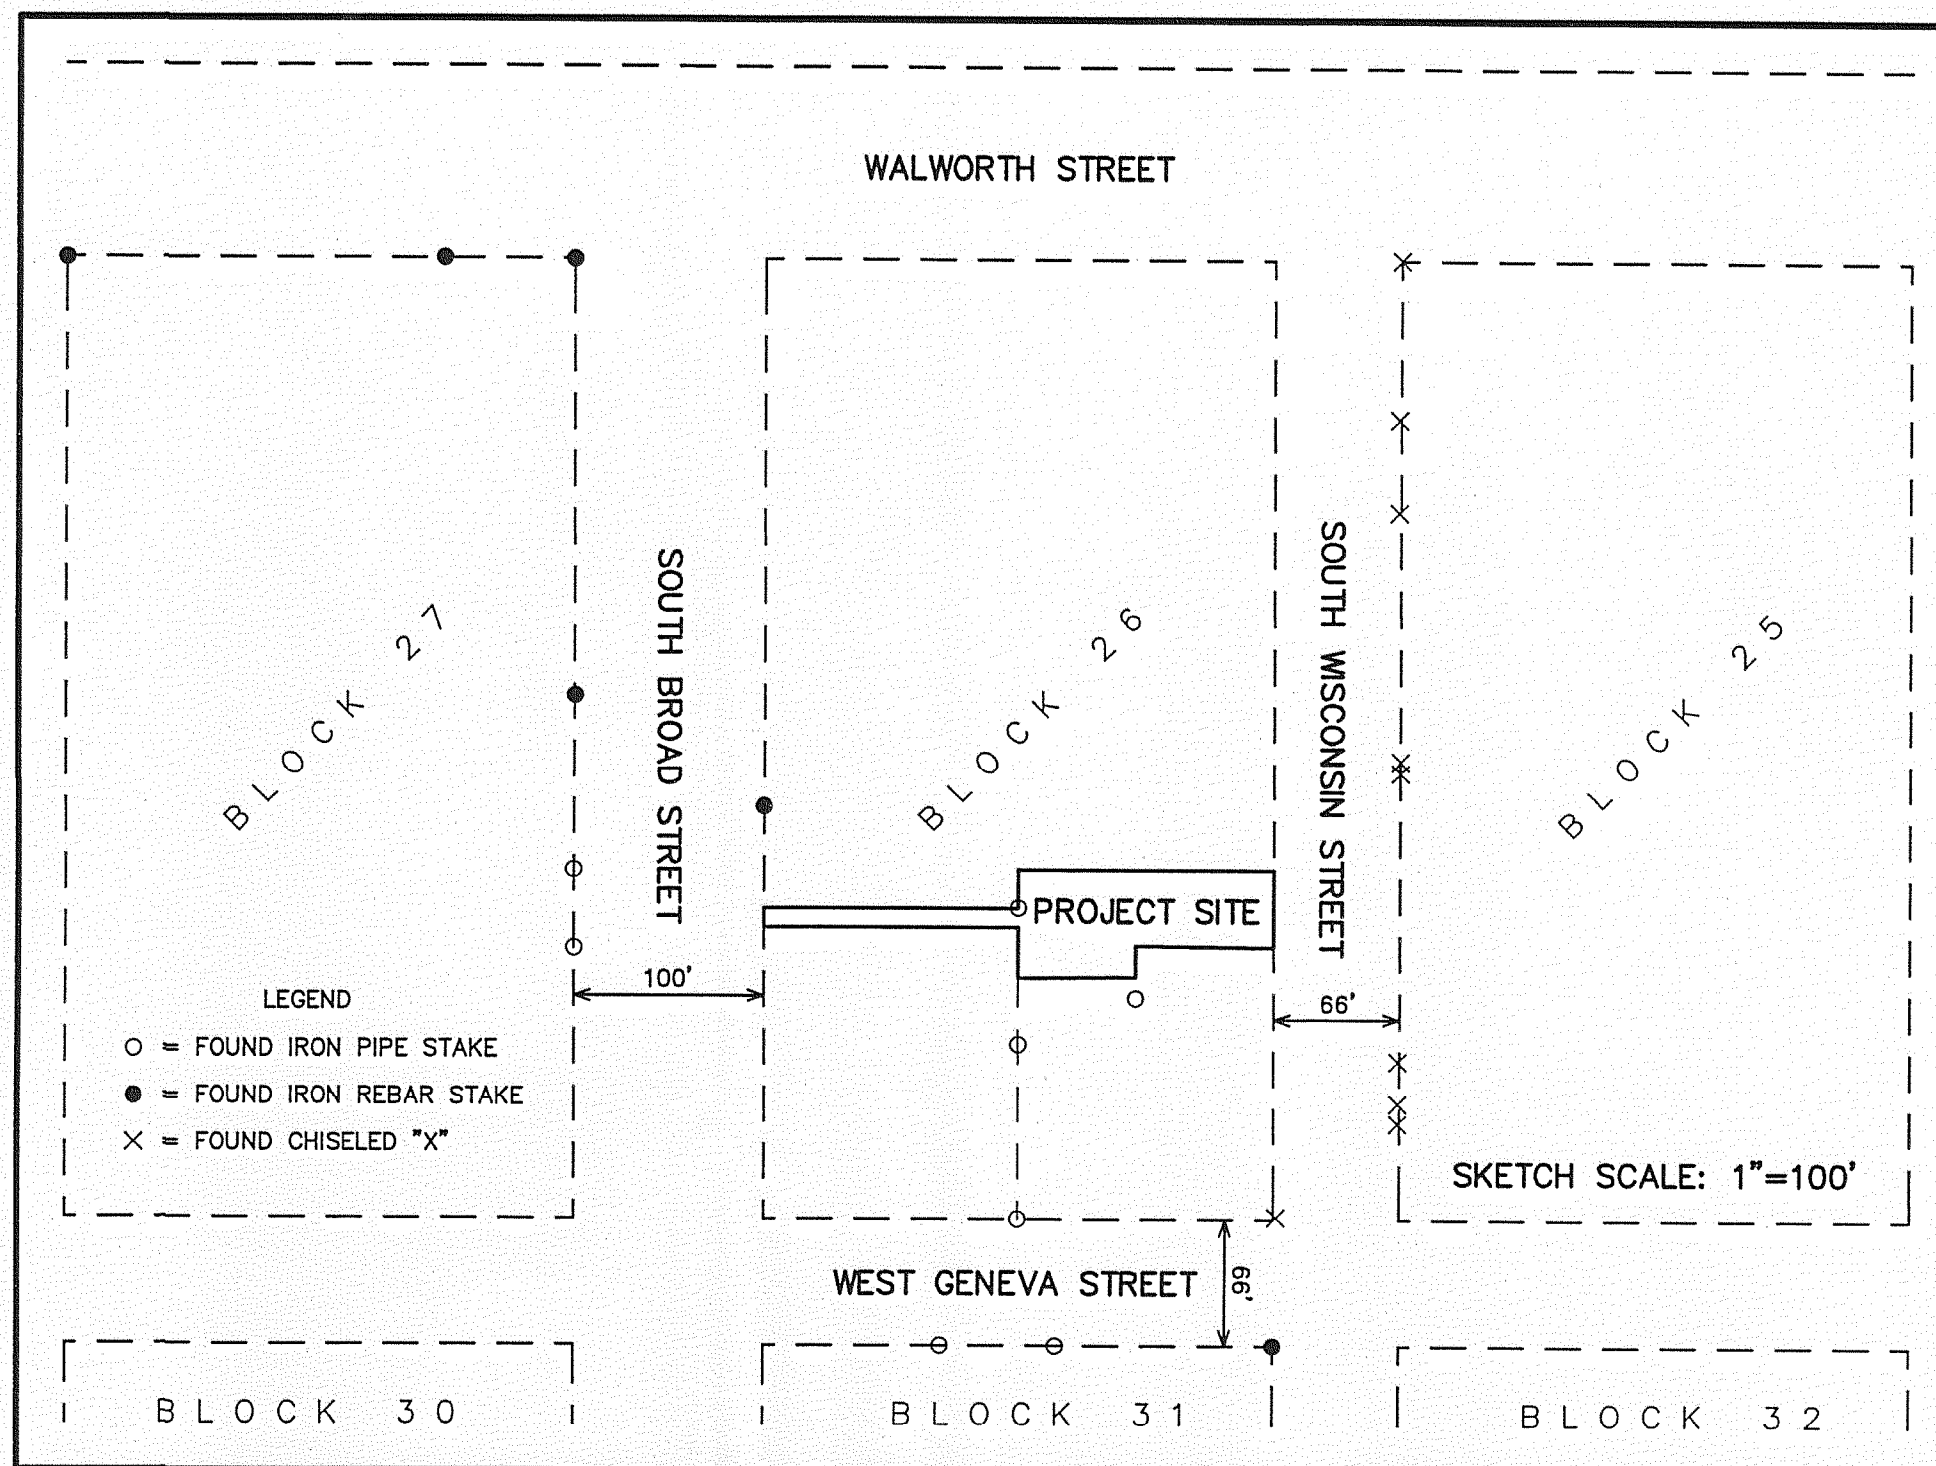


NOTE: COPIES OF THIS MAP TO WHICH THE FOLLOWING CERTIFICATE WILL APPLY SHOW SURVEYOR'S ORIGINAL SEAL AND SIGNATURE IN RED INK. COPIES BY ANY OTHER MEANS MAY HAVE ALTERATIONS WHICH DO NOT REPRESENT THE SURVEYOR'S WORK PRODUCT.

I HEREBY CERTIFY THAT THE ABOVE DESCRIBED PROPERTY HAS BEEN SURVEYED UNDER MY DIRECTION AND THAT THE ABOVE MAP IS A TRUE REPRESENTATION THEREOF AND SHOWS THE SIZE AND LOCATION OF THE PROPERTY AND ITS EXTERIOR BOUNDARIES. THIS SURVEY IS MADE FOR THE USE OF THE PRESENT OWNERS OF THE PROPERTY, AND ALSO THOSE WHO PURCHASE, MORTGAGE, OR GUARANTEE THE TITLE THERETO WITHIN ONE YEAR FROM THE DATE HEREOF.

DATED: 6/21/2007

PETER S. GORDON
S-2101
ELKHORN, WI
R.L.S. 2101

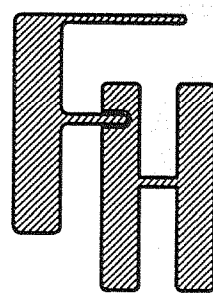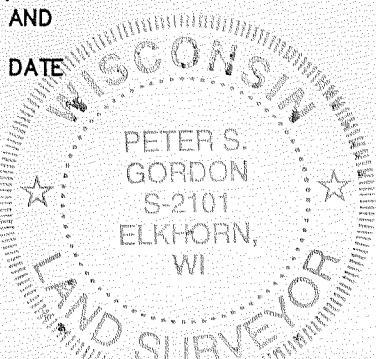

PLAT OF SURVEY

WORK ORDERED BY -
ERSKINE CONSTRUCTION
27 SOUTH BROAD STREET
ELKHORN, WI 53121

FARRIS, HANSEN & ASSOCIATES, INC.
ENGINEERING - ARCHITECTURE - SURVEYING
7 RIDGWAY COURT P.O. BOX 437
ELKHORN, WISCONSIN 53121
OFFICE: (262) 723-2098 FAX: (262) 723-5886

REVISIONS

PROJECT NO.

7336

DATE

06/21/2007

SHEET NO.

1 OF 1

004-2160