


# FARRIS, HANSEN & ASSOCIATES, INC.

ENGINEERING – ARCHITECTURE – SURVEYING  
7 RIDGWAY COURT – P.O. BOX 437 – ELKHORN, WISCONSIN 53121  
PHONE: (262) 723-2098 FAX: (262) 723-5886



## BOUNDARY SURVEY & MONITORING WELL LOCATION

LOT 2 CSM 938  
RECORDED IN VOL. 4, PG. 183, DOC. 46839  
LOCATED IN THE NE 1/4 SECTION 36  
TOWN 3 NORTH, RANGE 16 EAST, CITY OF ELKHORN  
WALWORTH COUNTY, WISCONSIN

— WORK ORDERED BY —  
KONICEK ENVIRONMENTAL CONSULTING, LLC  
1032 S. SPRING STREET  
PORT WASHINGTON, WI. 53074

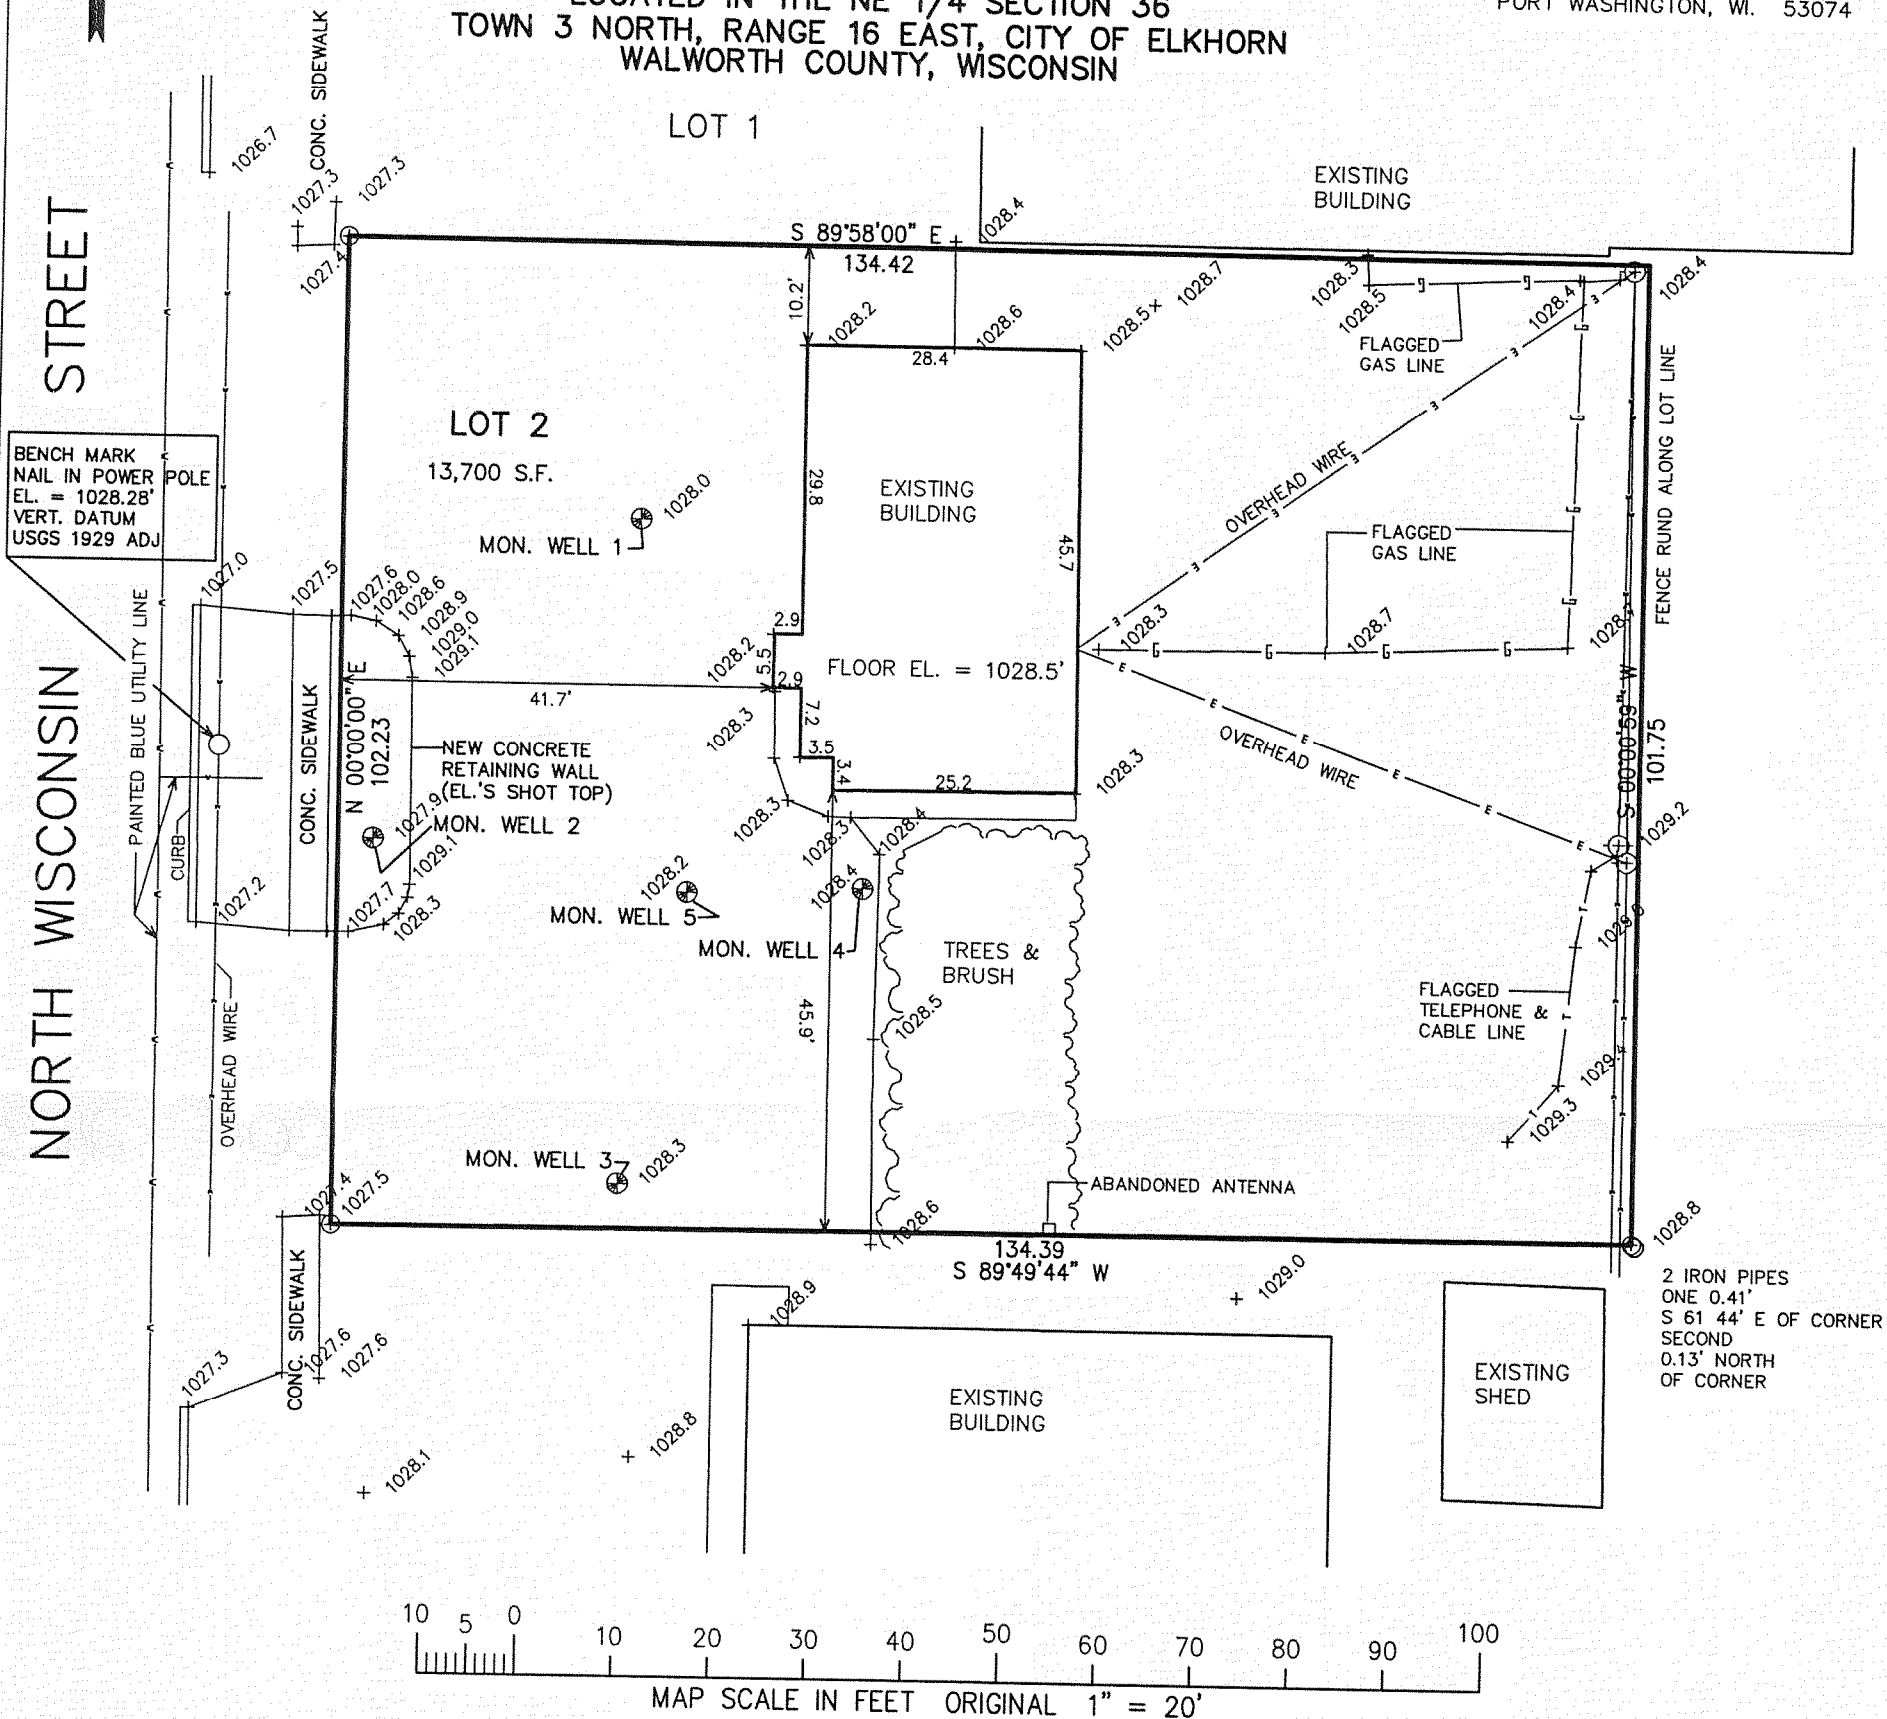

| MONITORING WELL # | GROUND EL. | TOP PIPE EL. |
|-------------------|------------|--------------|
| 1                 | 1028.0'    | 1027.55'     |
| 2                 | 1027.9'    | 1027.39'     |
| 3                 | 1028.3'    | 1027.92'     |
| 4                 | 1028.4'    | 1028.11'     |
| 5                 | 1028.2'    | 1027.84'     |

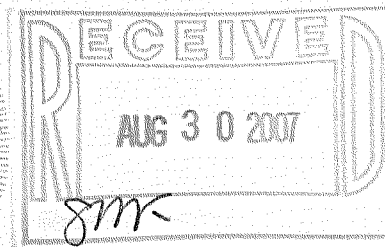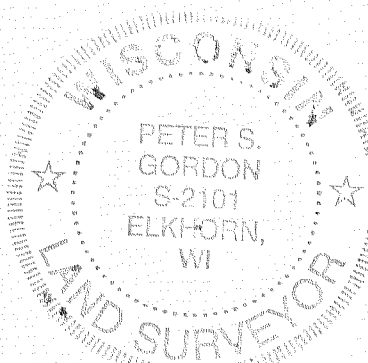

NOTE: COPIES OF THIS MAP TO WHICH THE FOLLOWING CERTIFICATE WILL APPLY SHOW SURVEYOR'S ORIGINAL SEAL AND SIGNATURE IN RED INK. COPIES BY ANY OTHER MEANS MAY HAVE ALTERATIONS WHICH DO NOT REPRESENT THE SURVEYOR'S WORK PRODUCT.

I HEREBY CERTIFY THAT THE ABOVE DESCRIBED PROPERTY HAS BEEN SURVEYED UNDER MY DIRECTION AND THAT THE ABOVE MAP IS A TRUE REPRESENTATION THEREOF AND SHOWS THE SIZE AND LOCATION OF THE PROPERTY AND ITS EXTERIOR BOUNDARIES. THIS SURVEY IS MADE FOR THE USE OF THE PRESENT OWNERS OF THE PROPERTY, AND ALSO THOSE WHO PURCHASE, MORTGAGE, OR GUARANTEE THE TITLE THERETO WITHIN ONE YEAR FROM THE DATE HEREOF.

DATED: AUGUST 3, 2007

*Peter S. Gordon*  
PETER S. GORDON R.L.S. 2101

PROJECT: 4100.07  
DATE: 08-03-2007  
SHEET 1 OF 1

AUG 03 2007

YA 938-2

004-2163