


PLAT OF SURVEY
LOT 2 OF CERTIFIED SURVEY MAP NO. 4148

LOCATED IN THE NE 1/4 OF THE SE 1/4 OF SECTION 25, TOWN 3 NORTH,
RANGE 16 EAST, CITY OF ELKHORN, WALWORTH COUNTY, WISCONSIN

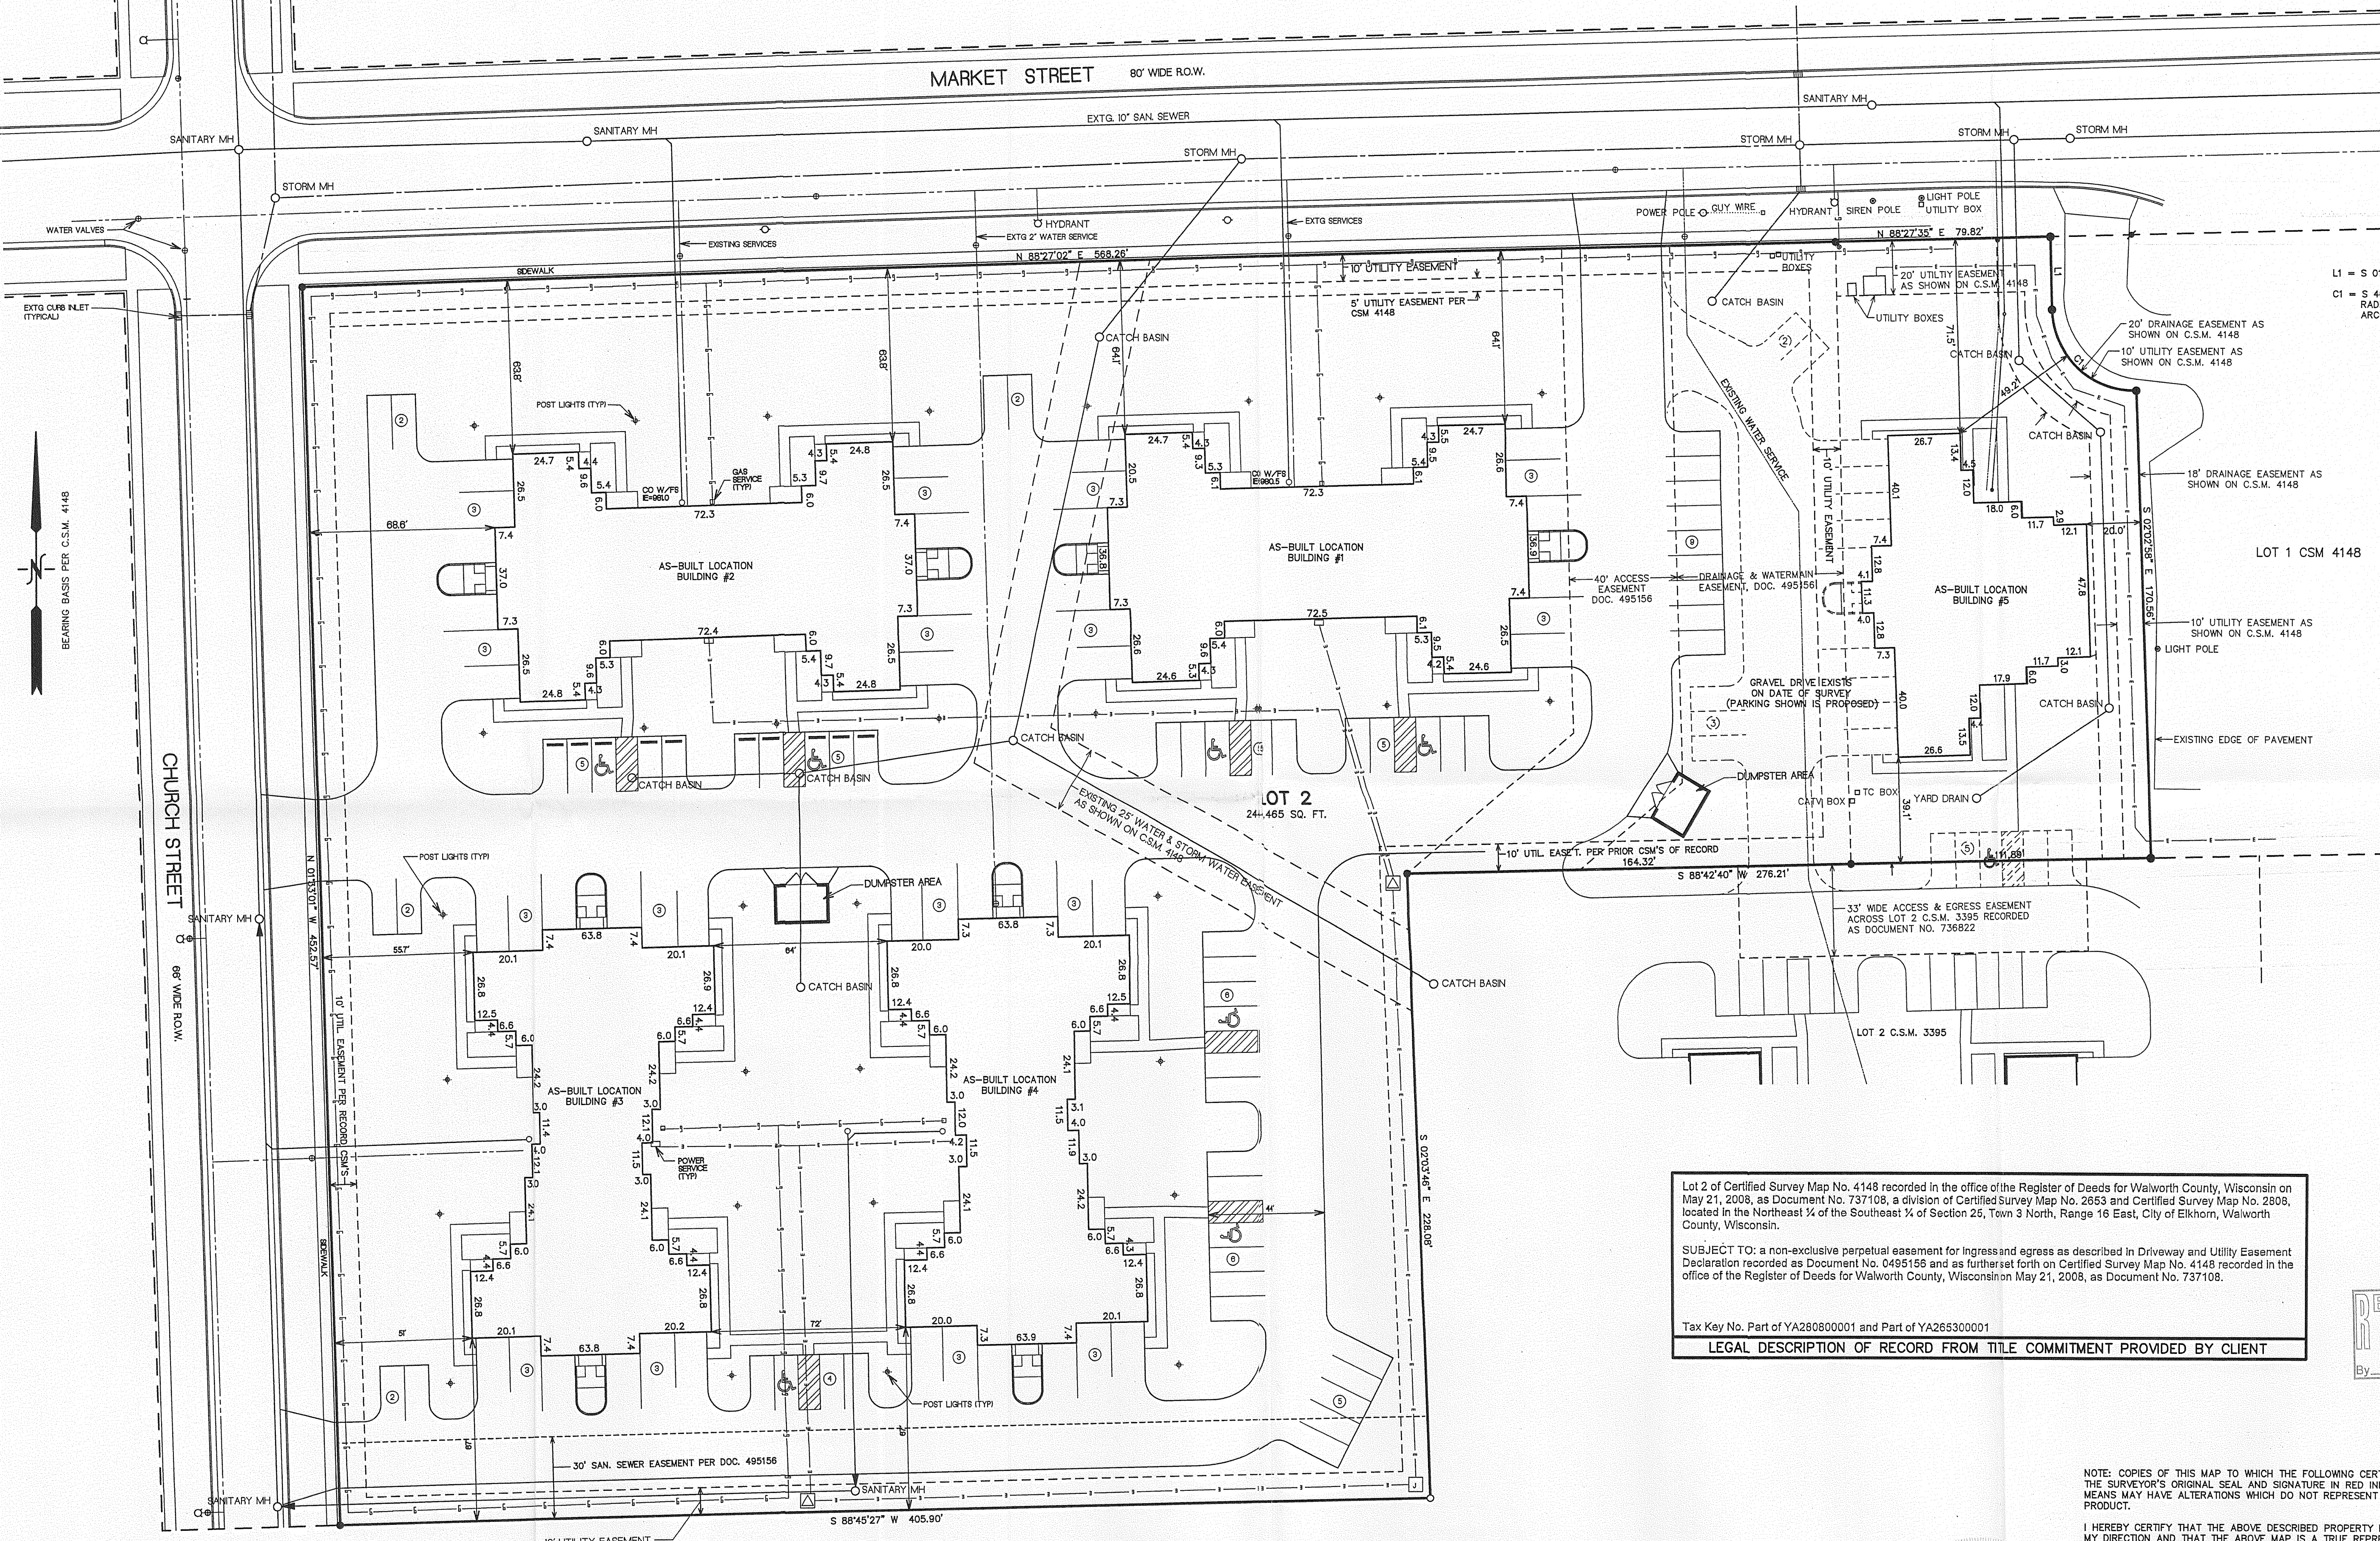

L1 = S 01°32'25" E 26.86'
C1 = S 46°33'08" E 43.14'
RADIUS=30.50'
ARC=47.92'

LOT 1 CSM 4148


33' WIDE ACCESS & EGRESS EASEMENT
ACROSS LOT 2 C.S.M. 3395 RECORDED
AS DOCUMENT NO. 736822

Lot 2 of Certified Survey Map No. 4148 recorded in the office of the Register of Deeds for Walworth County, Wisconsin on May 21, 2008, as Document No. 737108, a division of Certified Survey Map No. 2808, located in the Northeast 1/4 of the Southeast 1/4 of Section 25, Town 3 North, Range 16 East, City of Elkhorn, Walworth County, Wisconsin.

SUBJECT TO: a non-exclusive perpetual easement for ingress and egress as described in Driveway and Utility Easement Declaration recorded as Document No. 0495158 and as further set forth on Certified Survey Map No. 4148 recorded in the office of the Register of Deeds for Walworth County, Wisconsin on May 21, 2008, as Document No. 737108.

Tax Key No. Part of YA260800001 and Part of YA265300001

LEGAL DESCRIPTION OF RECORD FROM TITLE COMMITMENT PROVIDED BY CLIENT

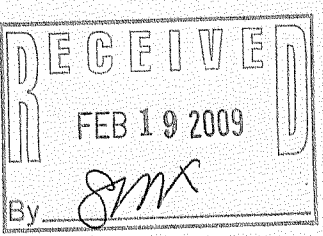


NOTE: COPIES OF THIS MAP TO WHICH THE FOLLOWING CERTIFICATE WILL APPLY SHOW THE SURVEYOR'S ORIGINAL SEAL AND SIGNATURE IN RED INK. COPIES BY ANY OTHER MEANS MAY HAVE ALTERATIONS WHICH DO NOT REPRESENT THE SURVEYOR'S WORK PRODUCT.

I HEREBY CERTIFY THAT THE ABOVE DESCRIBED PROPERTY HAS BEEN SURVEYED UNDER MY DIRECTION AND THAT THE ABOVE MAP IS A TRUE REPRESENTATION THEREOF AND SHOWS THE SIZE AND LOCATION OF THE PROPERTY, ITS EXTERIOR BOUNDARIES, THE LOCATION OF ALL VISIBLE STRUCTURES, AND DIMENSIONS OF ALL PRINCIPLE BUILDINGS THEREON, BOUNDARY FENCES, APPARENT EASEMENTS, ROADWAYS, AND VISIBLE ENCROACHMENTS, IF ANY. THIS SURVEY IS MADE FOR THE USE OF THE PRESENT OWNERS OF THE PROPERTY, AND ALSO THOSE WHO PURCHASE, MORTGAGE, OR GUARANTEE THE TITLE THERETO WITHIN ONE YEAR FROM THE DATE HEREOF.


DATE: 1/23/2009

Peter S. Gordon
PETER S. GORDON

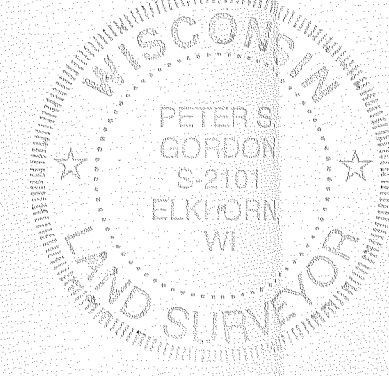


NOTE: SNOW AND ICE EXISTS ON SITE ON DATE OF SURVEY.
UTILITIES SHOWN ON THIS MAP WERE TAKEN FROM
MAPS OF RECORD. FOR REFERENCE ONLY.

- LEGEND
- = FOUND IRON PIPE STAKE
 - = FOUND IRON REBAR STAKE
 - (XXX) = RECORDED AS

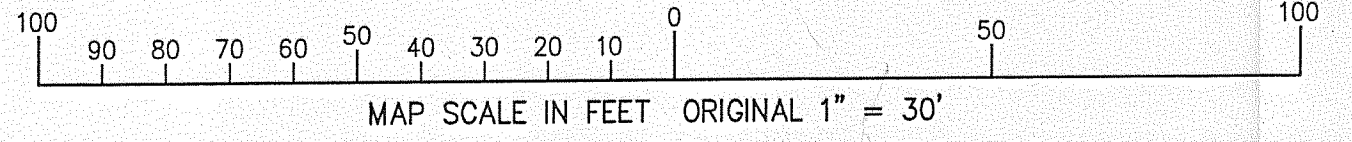

YA4148-2

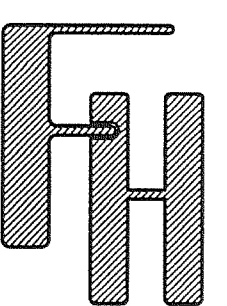

FARRIS, HANSEN & ASSOCIATES, INC.
APARTMENT DEVELOPMENT
MARKET STREET
CITY of ELKHORN, WALWORTH CO., WISCONSIN

WORK ORDERED BY -
DAN CARMODY
5803 GLENHAREN DRIVE
GREENDALE, WI 53129

FARRIS, HANSEN & ASSOCIATES, INC.
ENGINEERING - ARCHITECTURE - SURVEYING
7 RIDGWAY COURT P.O. BOX 437
ELKHORN, WISCONSIN 53121
OFFICE: (262) 723-2098 FAX: (262) 723-5886

REVISIONS

PROJECT NO. 5444.07
DATE 01/23/2009
SHEET NO. 1 OF 1

007-2249