


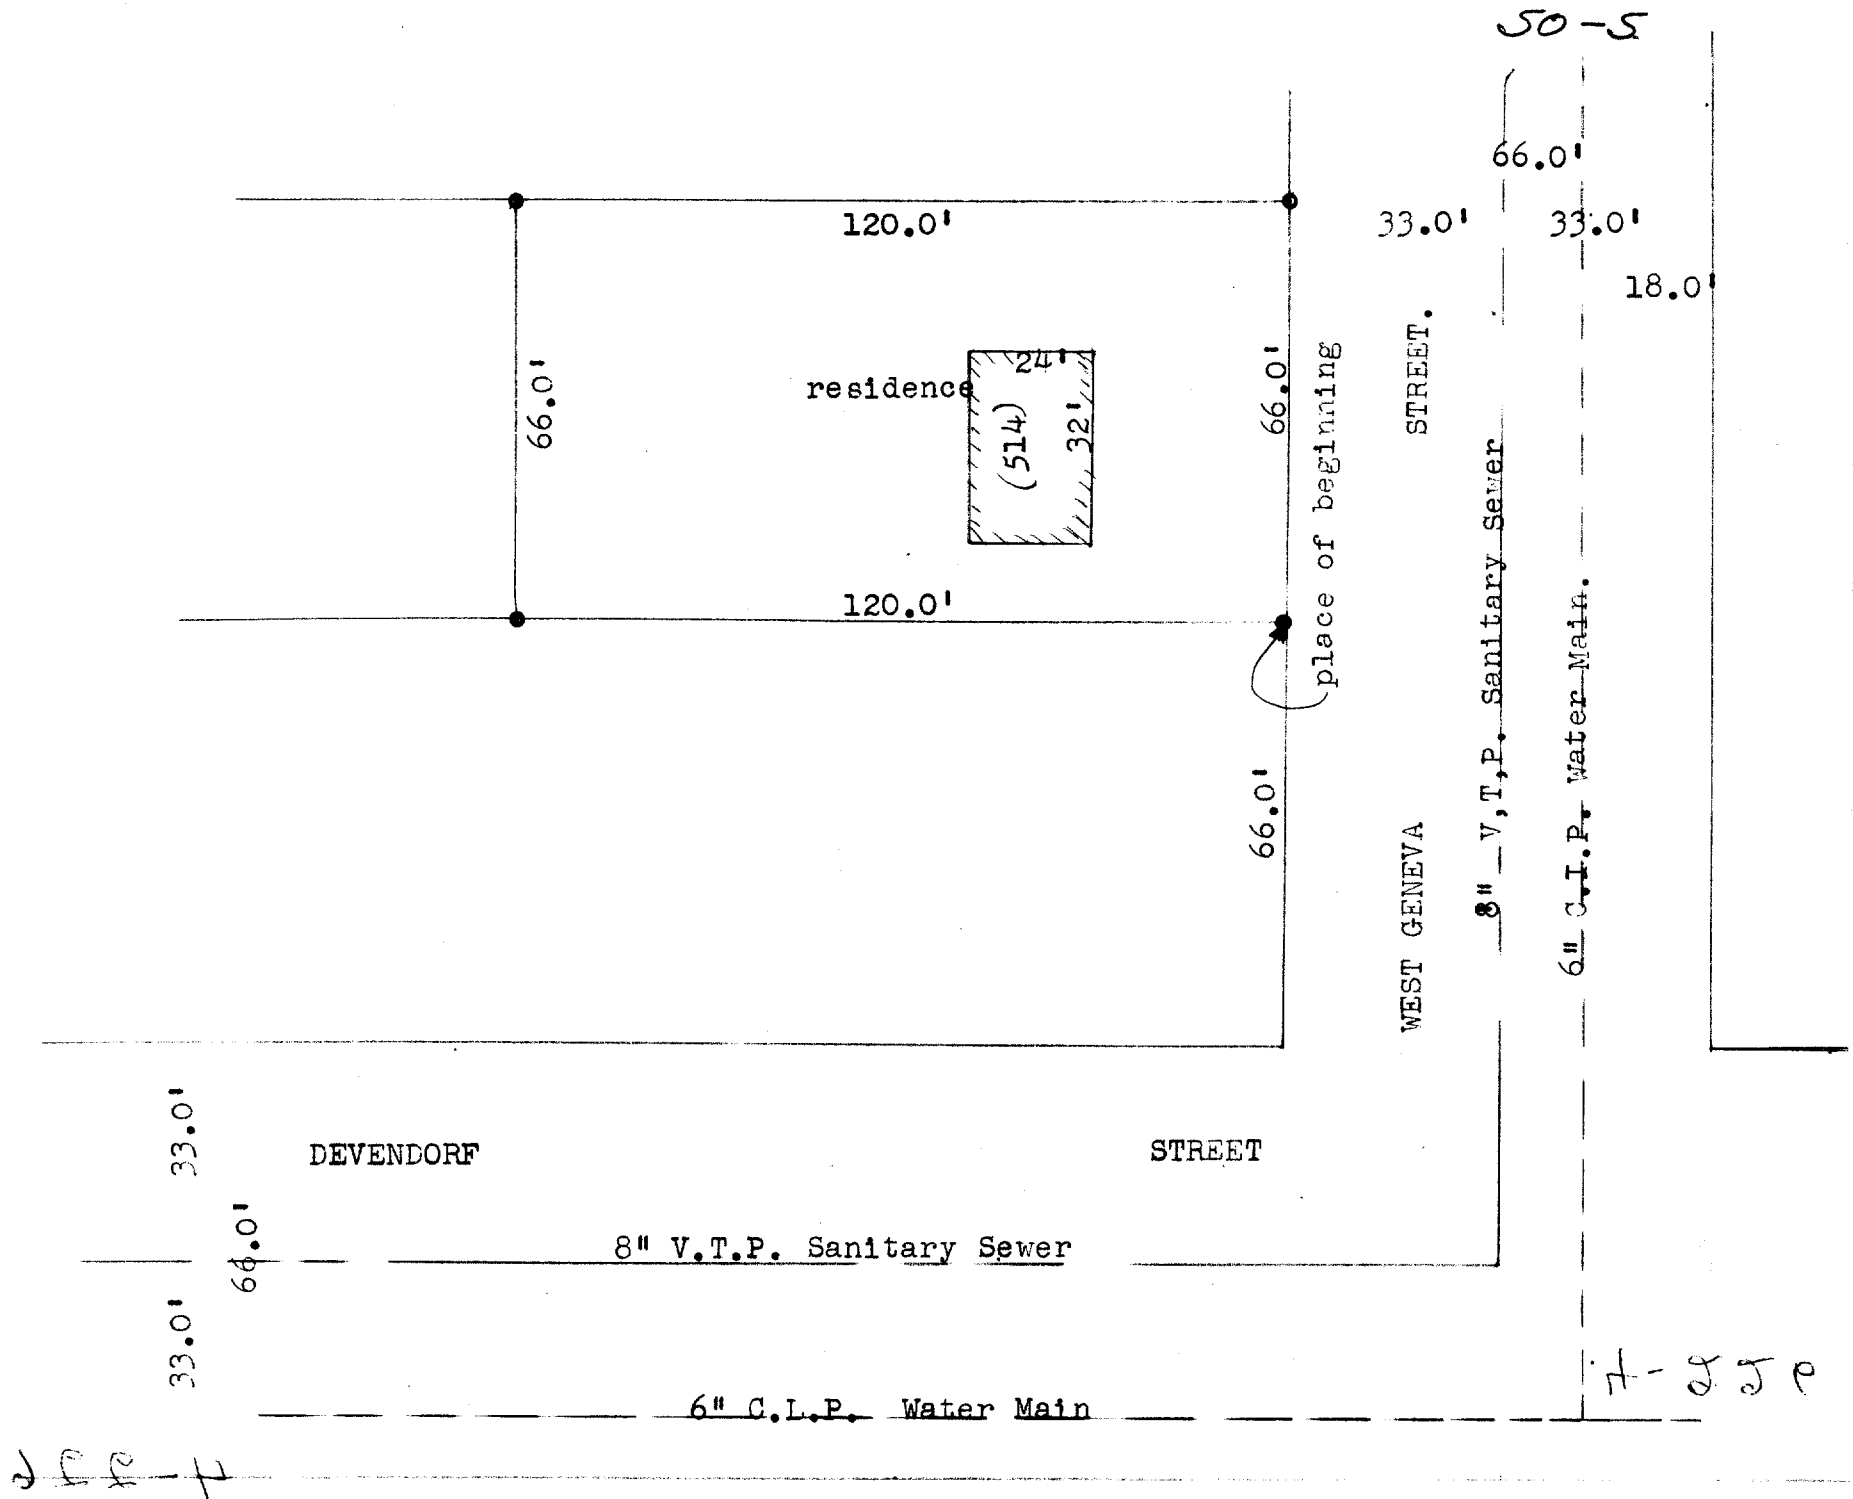

DESCRIPTION:

Commencing at a point in the North line of West Geneva Street in the City of Elkhorn, Walworth County, Wisconsin, 66 feet East of the intersection of the north line of said West Geneva Street and the East line of Devendorf Street, thence north parallel with the east line of Devendorf Street, 120.0 feet to an iron stake, thence East parallel with the north line of West Geneva Street, 66.0 feet to an iron stake, thence South 120.0 feet to a point in the north line of West Geneva Street, thence West in the north line of said West Geneva Street, 66.0 feet to the place of beginning.

CERTIFICATE:

I, hereby certify that I, have on this the 8th day of September, surveyed the above described property according to the official records on file in the office of the Recorder of Deeds in and for Walworth County, Wisconsin, and find that the measurements and bearings of the boundary lines of said property as taken at the site on this day, substantially agree with those in said official record, and that no encroachments exist, and that the survey of the lot and information relative to the residence located on said lot, all as shown on the above survey, is a true and correct representation of the conditions found at the site on this 8th day of September, 1950.

SIGNED AND SEALED ON THIS THE 11TH DAY OF SEPTEMBER 1950.

Joseph M. Biagi
Joseph M. Biagi. Professional Engineer.
Elkhorn Wisconsin.