


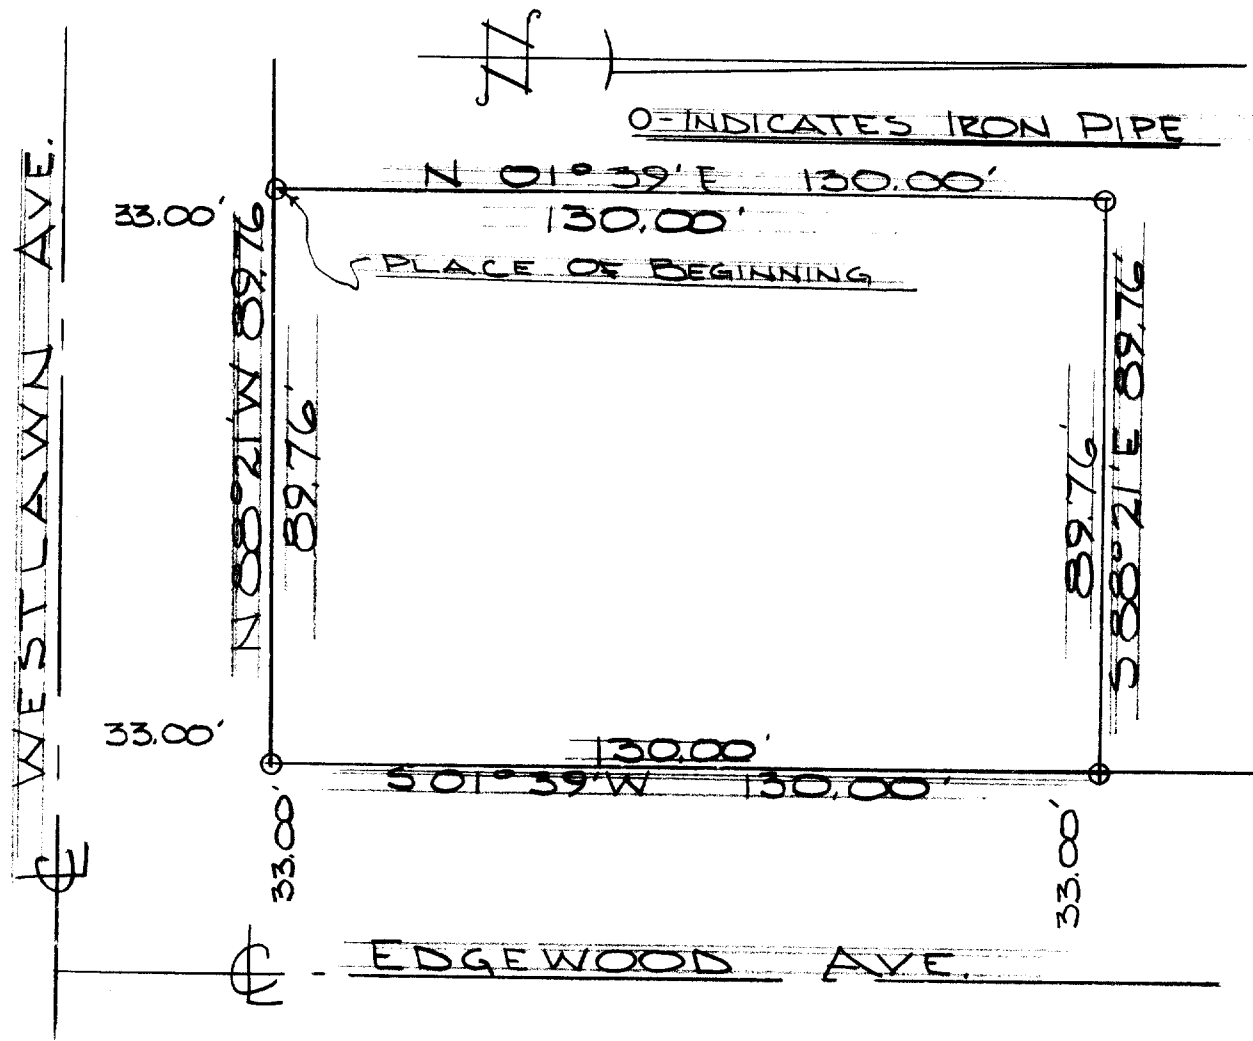

DESCRIPTION: Commencing at the NW corner of the NE $\frac{1}{4}$ of Section 36 T. 3 N., R. 16 E. in the City of Elkhorn, Walworth County, Wisconsin; thence S. 01° 39' W. 1815.38 feet, thence S. 88° 21' E. 538.56 feet to the place of beginning of the lands hereinafter described; thence N. 01° 39' E. 130.00 feet, thence S. 88° 21' E. 89.76 feet, thence S. 01° 39' W. 130.00 feet, thence N. 88° 21' W. 89.76 feet to the place of beginning.

CERTIFICATE: I, James F. Biagi, surveyor, do hereby certify that I have surveyed the property hereon described.

April 25, 1966.



James F. Biagi
James F. Biagi RLS 272