


Northwest corner of the S.E. $\frac{1}{4}$ of
Section 36, Town 3 north, Range 16 east.

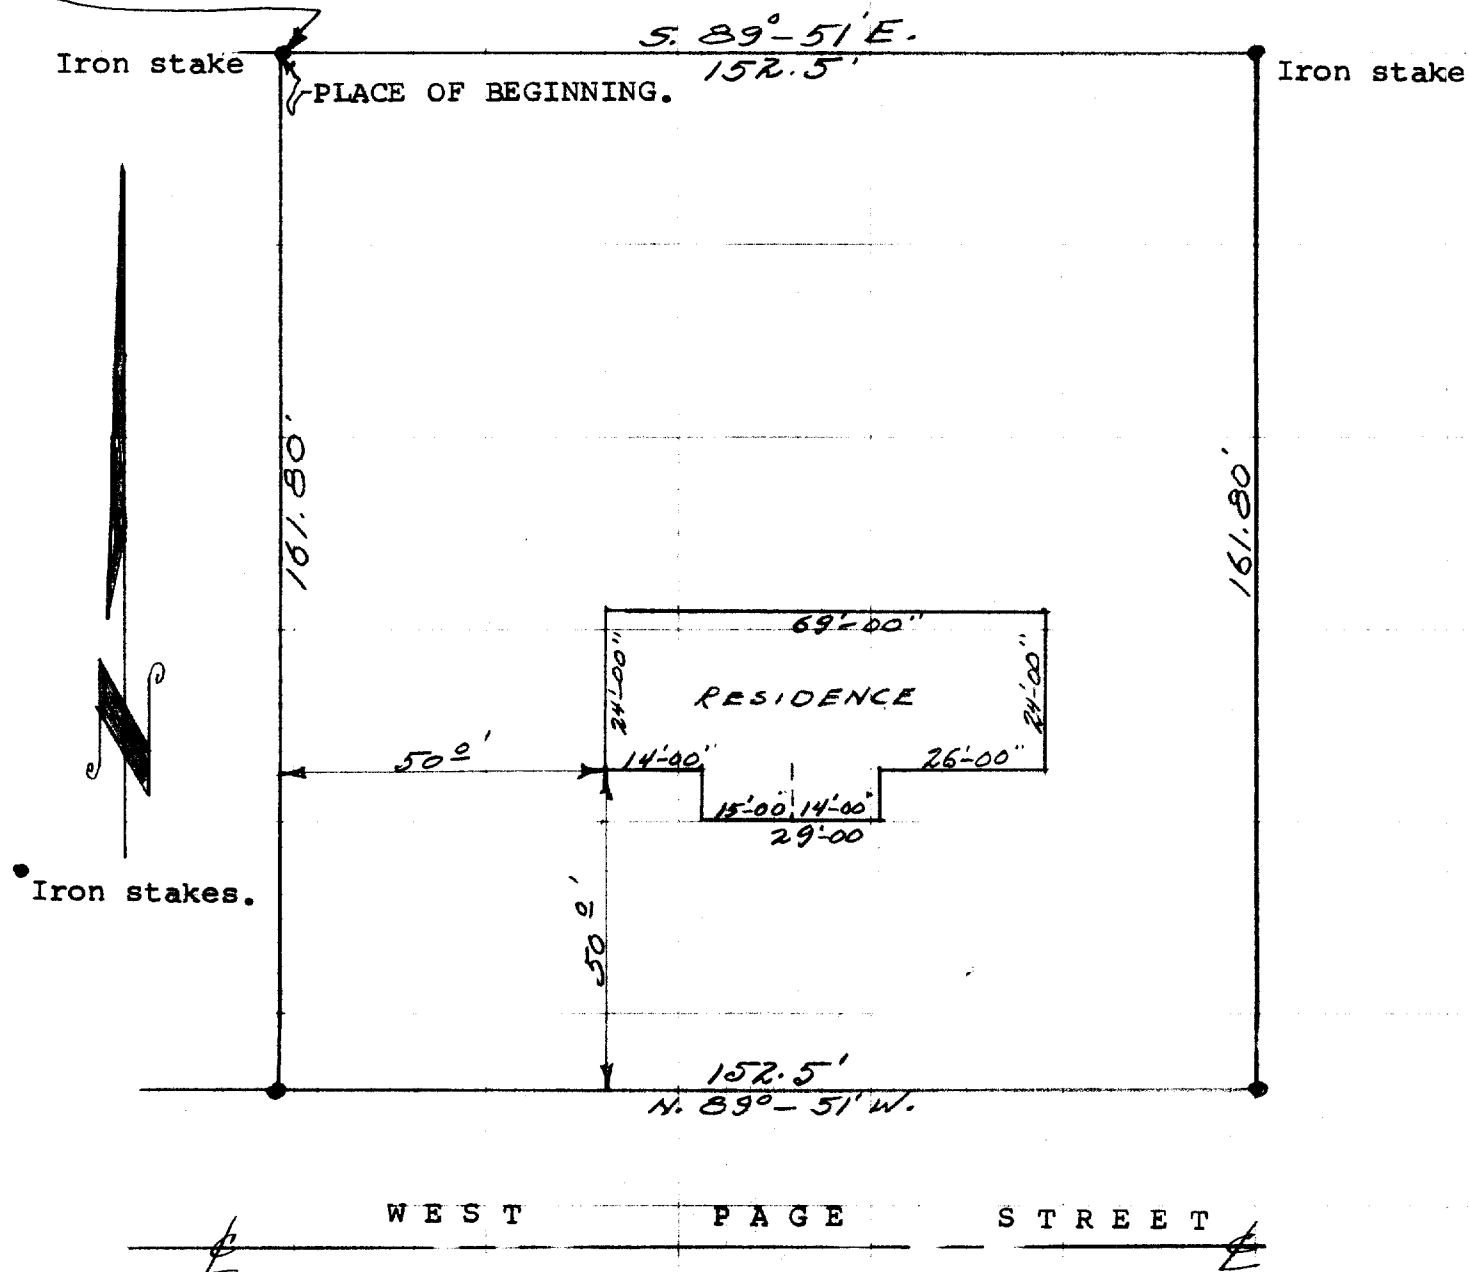

Description:

Commencing at the northwest corner of the S.E. $\frac{1}{4}$ of Section 36, Town 3 north, Range 16 east, City of Elkhorn, Walworth County, Wisconsin, thence S. $89^{\circ} 51' E.$, 152.50 feet to an iron stake, thence South 161.80 feet to an iron stake in the north line of West Page Street, thence N. $89^{\circ} 51' W.$ along said north line 152.50 feet to an iron stake, thence North 161.8 feet to the place of beginning.

CERTIFICATE:

I, James F. Biagi, surveyor, do hereby certify that I have surveyed the property hereon described on this the 9th day of September 1968.

Dated this 9th day of September 1968. James F. Biagi RLS 272
Elkhorn, Wisconsin.