



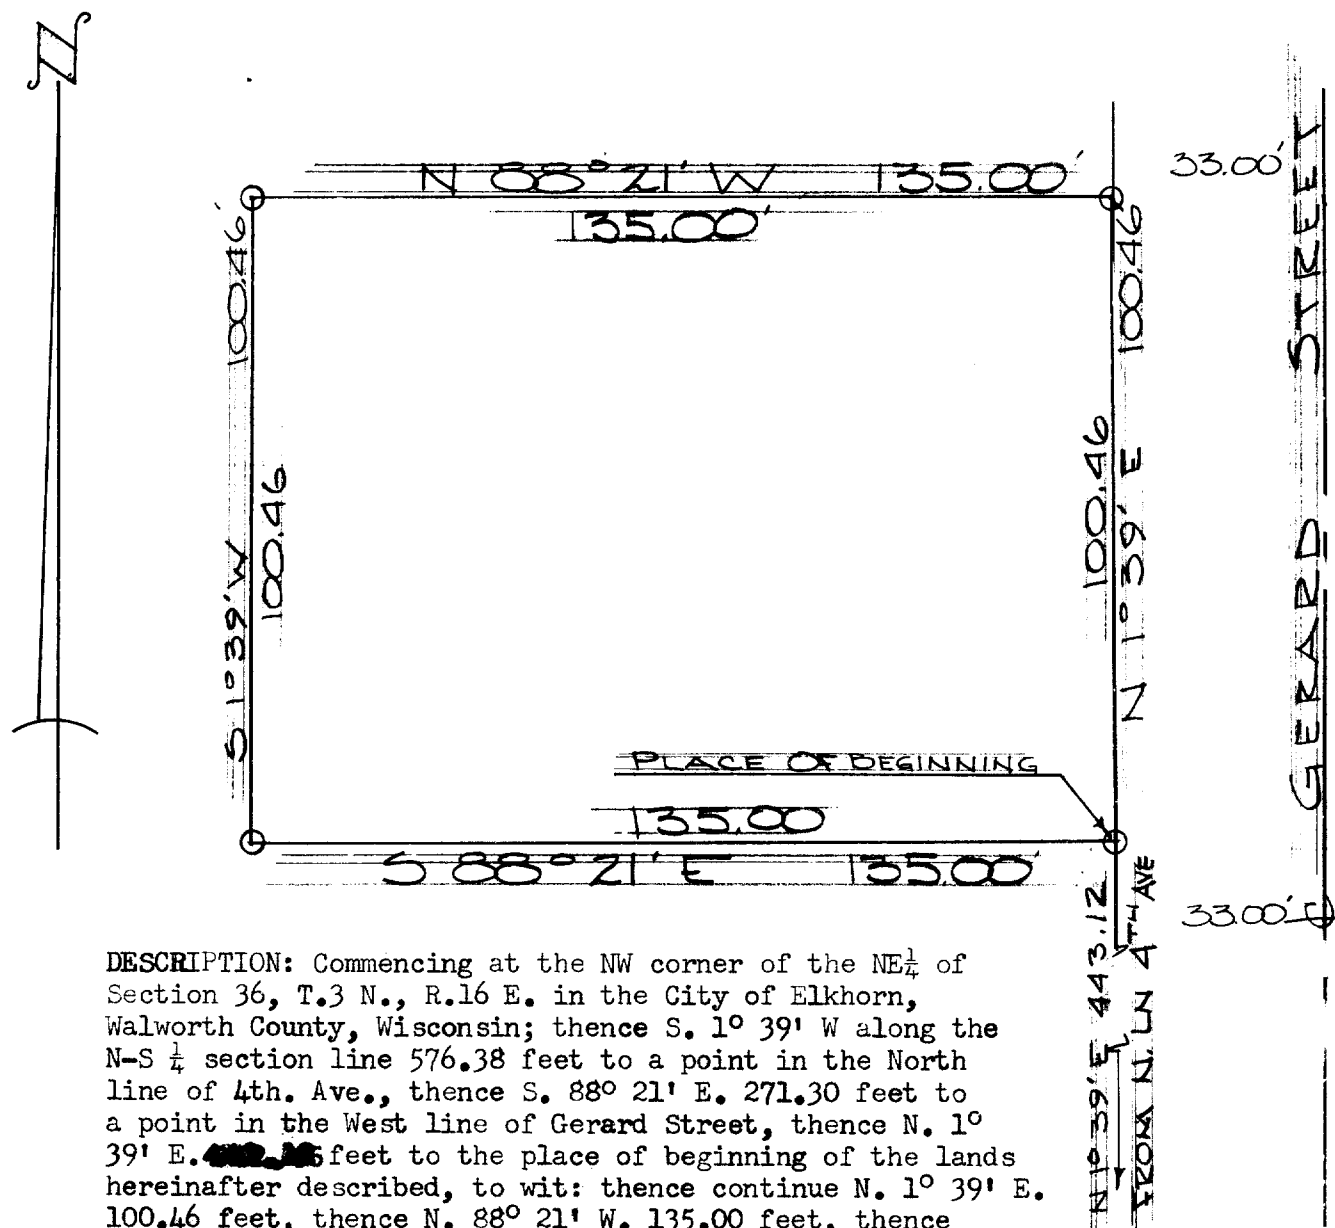

DESCRIPTION: Commencing at the NW corner of the NE $\frac{1}{4}$ of Section 36, T.3 N., R.16 E. in the City of Elkhorn, Walworth County, Wisconsin; thence S. $1^{\circ} 39'$ W along the N-S $\frac{1}{4}$ section line 576.38 feet to a point in the North line of 4th. Ave., thence S. $88^{\circ} 21'$ E. 271.30 feet to a point in the West line of Gerard Street, thence N. $1^{\circ} 39'$ E. 100.46 feet to the place of beginning of the lands hereinafter described, to wit: thence continue N. $1^{\circ} 39'$ E. 100.46 feet, thence N. $88^{\circ} 21'$ W. 135.00 feet, thence S. $1^{\circ} 39'$ W. 100.46 feet, thence S. $88^{\circ} 21'$ E. 135.00 feet to the place of beginning.

CERTIFICATE: I, James F. Biagi, surveyor do hereby certify that I have surveyed the property hereon described.

August 7, 1966

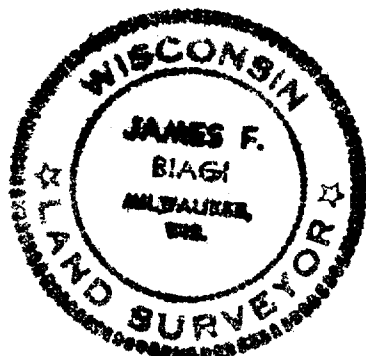

James F. Biagi
James F. Biagi

271.30
576.38