



FARRIS, HANSEN & ASSOCIATES, INC.

ENGINEERING - ARCHITECTURE - SURVEYING  
7 RIDGWAY COURT - P.O. BOX 437 - ELKHORN, WISCONSIN 53121  
PHONE: (262) 723-2098 FAX: (262) 723-5886

PLAT OF SURVEY

LOT 2 IN WEST OAK PARK, BEING A SUBDIVISION  
IN THE NORTHEAST 1/4 OF SECTION 36, TOWN 3 NORTH,  
RANGE 16 EAST, CITY OF ELKHORN, WALWORTH COUNTY, WISCONSIN

WORK ORDERED BY -  
RUTH MEYER  
304 WEST OAK LANE  
ELKHORN, WI 53121

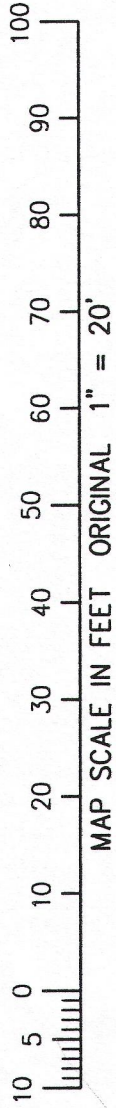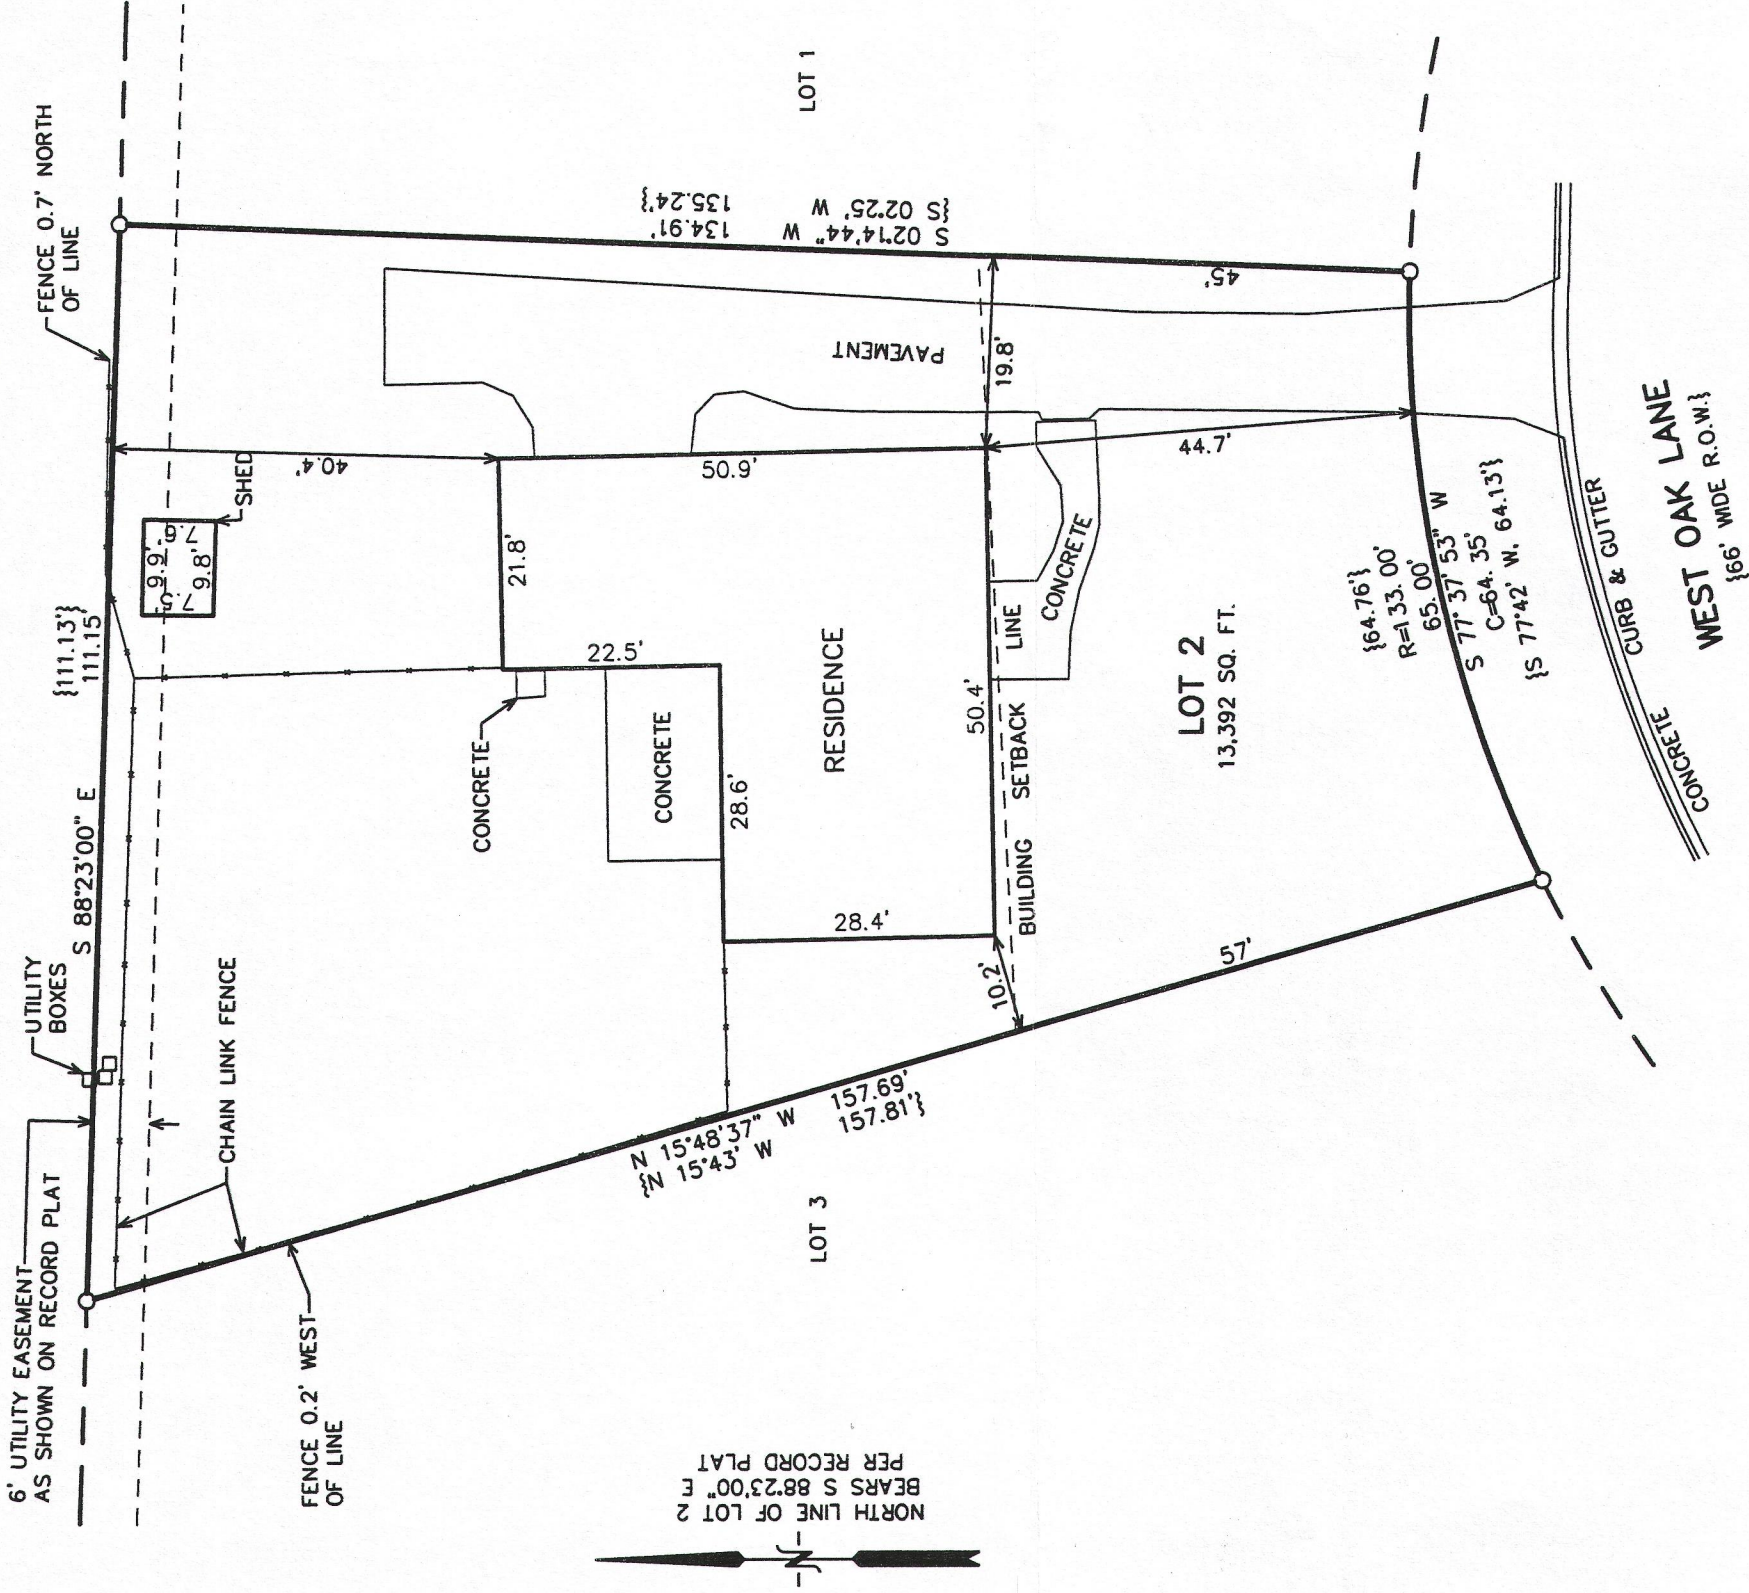


NOTE: COPIES OF THIS MAP TO WHICH THE FOLLOWING CERTIFICATE  
WILL APPLY SHOW THE SURVEYOR'S ORIGINAL SEAL AND SIGNATURE  
IN RED INK. COPIES BY ANY OTHER MEANS MAY HAVE ALTERATIONS  
WHICH DO NOT REPRESENT THE SURVEYOR'S WORK PRODUCT.

I HEREBY CERTIFY THAT THE ABOVE DESCRIBED PROPERTY HAS BEEN  
SURVEYED UNDER MY DIRECTION AND THAT THE ABOVE MAP IS A TRUE  
REPRESENTATION THEREOF AND SHOWS THE SIZE AND LOCATION OF  
THE PROPERTY AND ITS EXTERIOR BOUNDARIES. THIS SURVEY IS  
MADE FOR THE USE OF THE PRESENT OWNERS OF THE PROPERTY, AND  
ALSO THOSE WHO PURCHASE, MORTGAGE, OR GUARANTEE THE TITLE  
THERE TO WITHIN ONE YEAR FROM THE DATE HEREOF.

DATED: JUNE 19, 2013

*Peter S. Gordon*  
PETER S. GORDON R.L.S. 2101

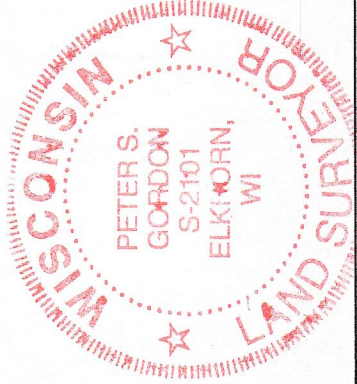

LEGEND  
O = IRON PIPE STAKE FOUND  
{XXX} = RECORDED AS

PROJECT: 8821  
DATE: 6/19/2013  
SHEET 1 OF 1