


60-20

4-23B

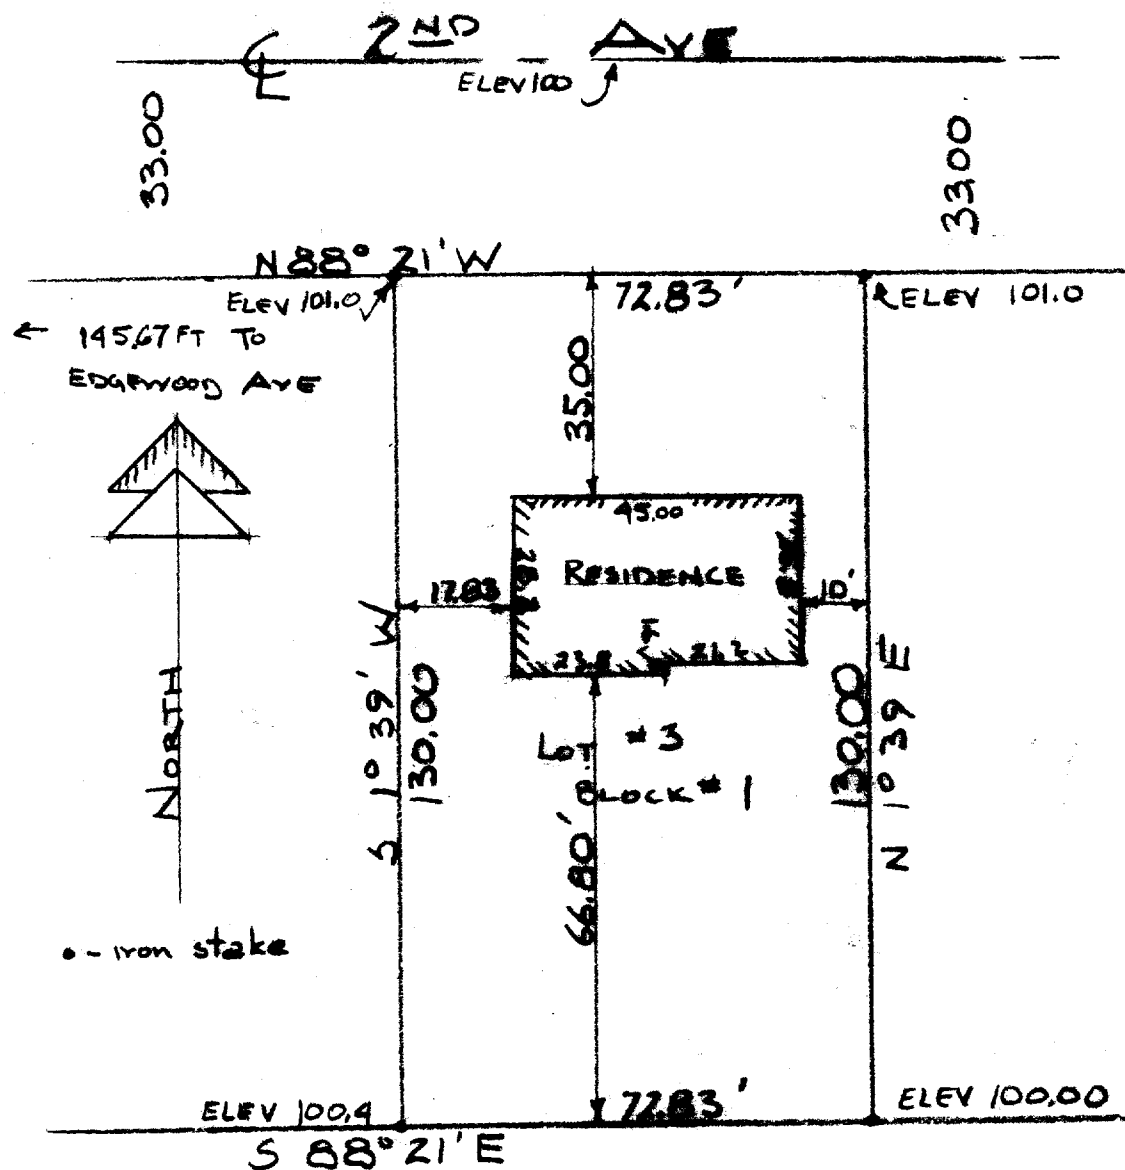


DESCRIPTION: Lot # 3 of Block # 1 of Edgewood Subdivision  
in the City of Elkhorn, Walworth County, Wisconsin.

CERTIFICATE: I hereby certify that I have surveyed the  
property hereon described and that the location  
of all the improvements are as shown hereon.

SIGNED AND SEALED ON OCTOBER 4TH 1960.

*James F. Bligh*  
James F. Bligh (272 RLS)

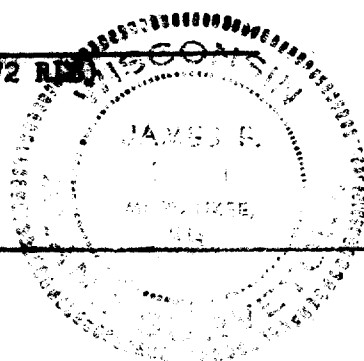

4-23B

YES