
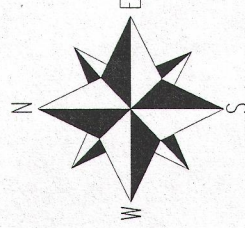


PREPARED FOR
BLACKHAWK COMMUNITY CREDIT UNION
2640 COURT ST.
JANESVILLE WI. 53547

PLAT OF SURVEY

-OF-
LOT 17, STONEGATE FARMS SUBDIVISION, ACCORDING TO THE RECORD
PLAT THEREOF, SAID LAND BEING IN THE CITY OF ELKHORN, COUNTY
OF WALWORTH AND STATE OF WISCONSIN.

KROTT SURVEYING INC.
N3705 WILLOW BEND LANE
LAKE GENEVA WI. 53147
PHONE # (262)248-3697
FAX # (262)249-0639

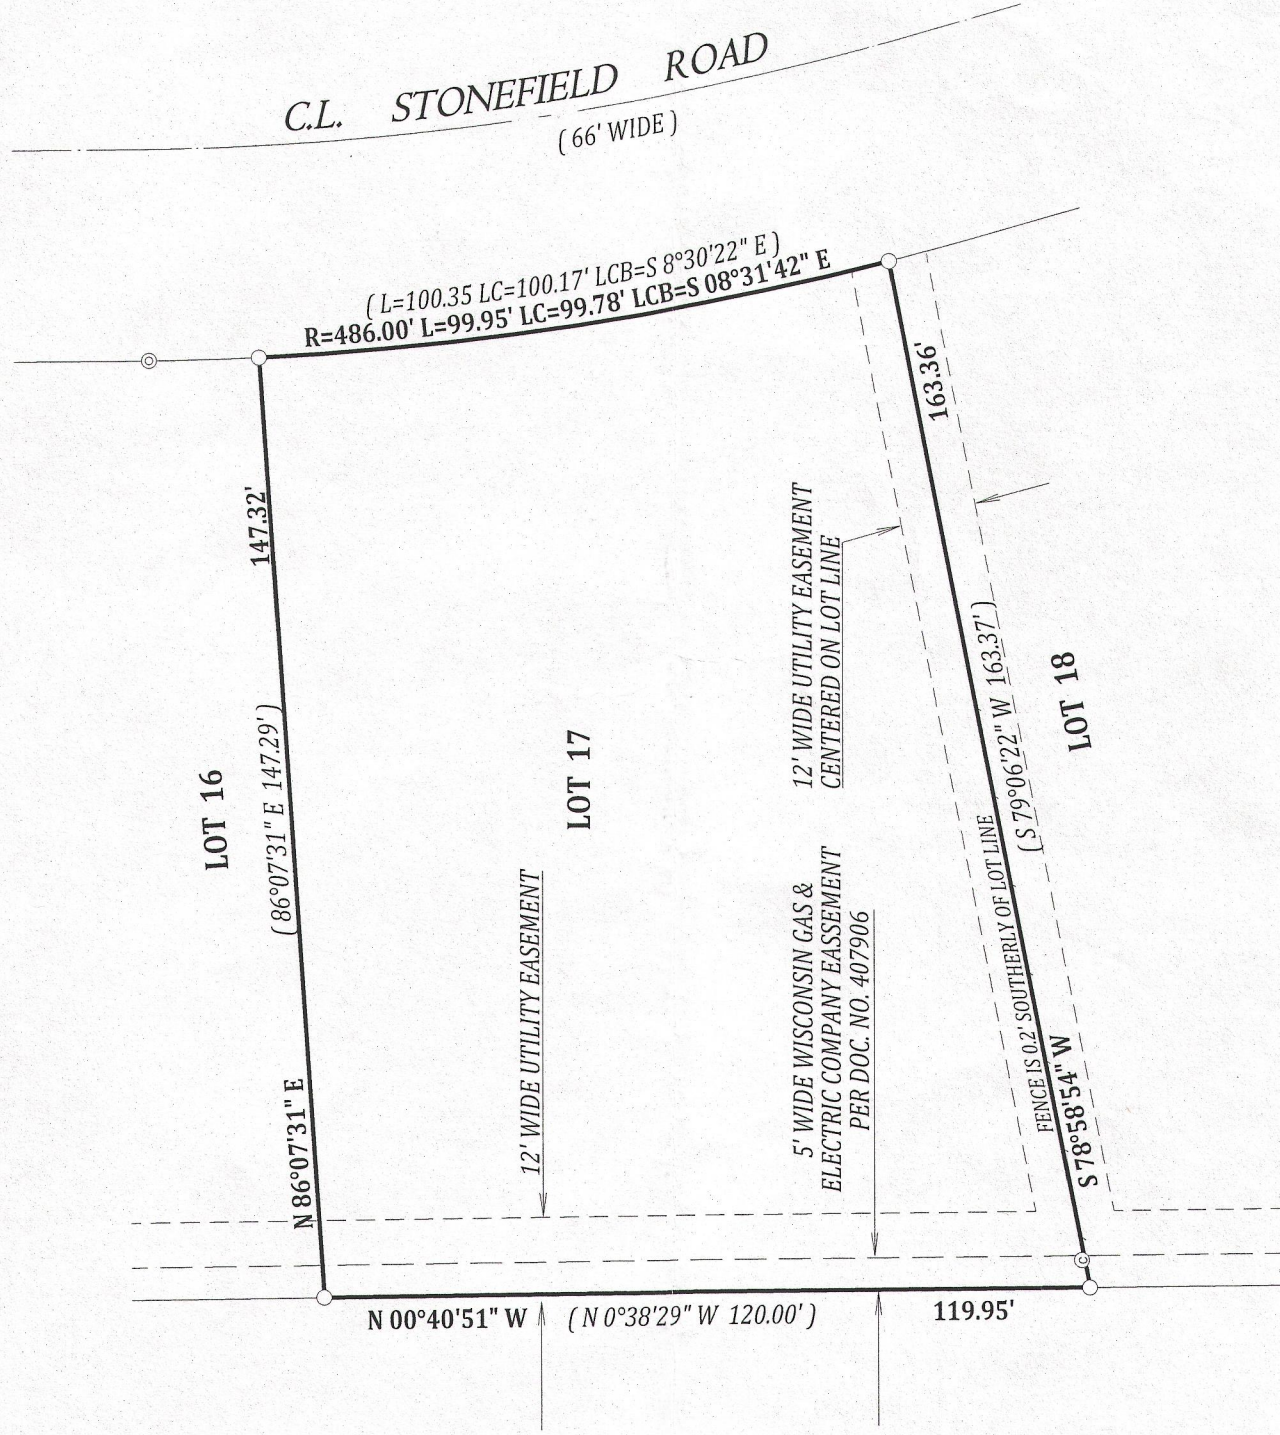



LEGEND

- FOUND 1" DIA IRON PIPE
- ⊙ FOUND 2" DIA. IRON PIPE
- ⊙ CABLE PEDESTAL

(XX) RECORDED AS
TAX ID # YSF00017
JOB # 13-094

I have surveyed the above-described property and the above map is a true representation thereof and shows the size and location of the property, its exterior boundaries, the location and dimensions of all structures thereon, fences apparent easements and roadways and visible encroachments, if any.

This survey is made for the exclusive use of the present owners of the property, and also those who purchase, mortgage, or insure the title thereto within one (1) year from date hereof; and as to them I warrant the accuracy of said survey map.

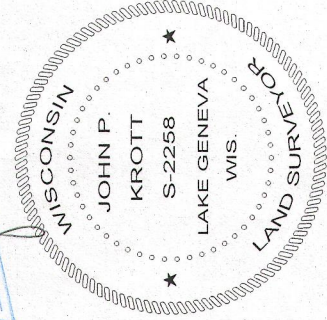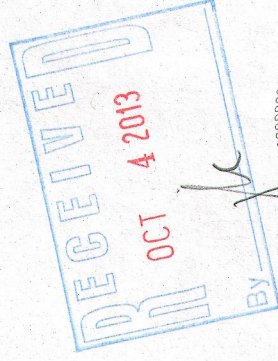

DATED THIS 27th DAY OF JUNE 2013

John P. Krott

JOHN KROTT S - 2258
Wisconsin Registered Land Surveyor
(original if signed in red)

004-2401