LAND-MARK SURVEYING Mark L. Miritz

Wisconsin Registered Land Surveyor S-2582

N9330 Knuteson Drive Whitewater, WI 53190 Phone: (262)495-3284 MARKMIRITZ@ LAND-MARKSURVEYING.COM


PLAT OF SURVEY

LOT 5, IN BLOCK 1, HODGES ADDITION, IN THE CITY OF ELKHORN, WALWORTH **COUNTY, WISCONSIN**

ORDERED BY: CONNIE POGGENSEE RAULAND AGENCY, INC. 118 KENOSHA STREET WALWORTH, WI 53184

SURVEYOR'S NOTE:

THIS SURVEY WAS BASED ON RESURVEY INFORMATION OF THE CITY OF ELKHORN BY H.H. TUBBS, CITY ENGINEER, DATED JULY 1930.

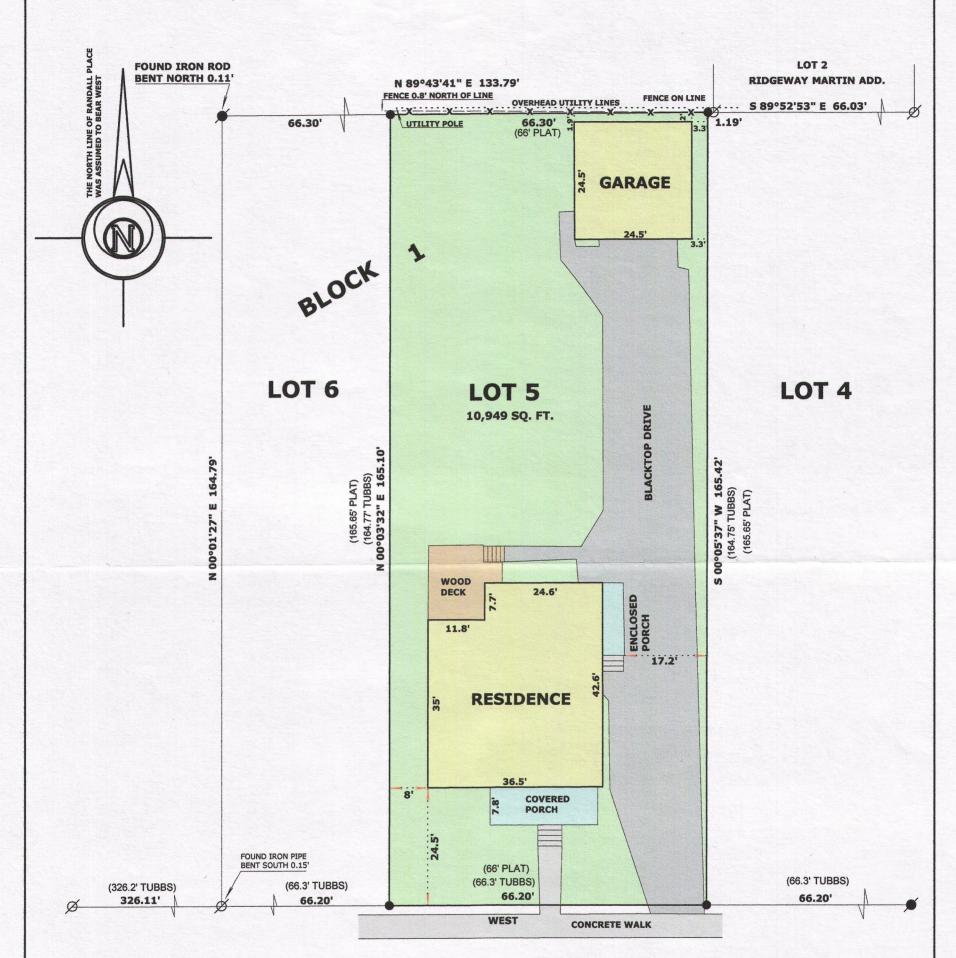

(66' WIDE)

RANDALL PLACE





LEGEND

Ø FOUND IRON PIPE FOUND IRON ROD

SET IRON ROD, 18" LONG, WEIGHING 1.5 LBS./LINEAL FT., 3/4" DIA.

RECORDED AS DIMENSION (xx) -x--x **EXISTING FENCE**

SCALE: 1 INCH = 20 FEET

"I hereby certify that the above described property has been surveyed by me or under my direction and that the above map is a true representation thereof and shows the size and location of the property, its exterior boundaries, the location of all visible structures and dimensions of all principal buildings thereon, boundary fences, apparent easements, roadways and visible encroachments, if any."

"This survey is made for the use of the present owners of the property, and also those who purchase, mortage, or

the property, and also those who purchase, mortgage, or guarantee the title thereto within one year from date hereof."

MARK L. MIRITZ **WISCONSIN REGISTERED**

LAND SURVEYOR S-2582

OCT. 15, 2014

JOB NO. 14.1006