


60-25

H-5416

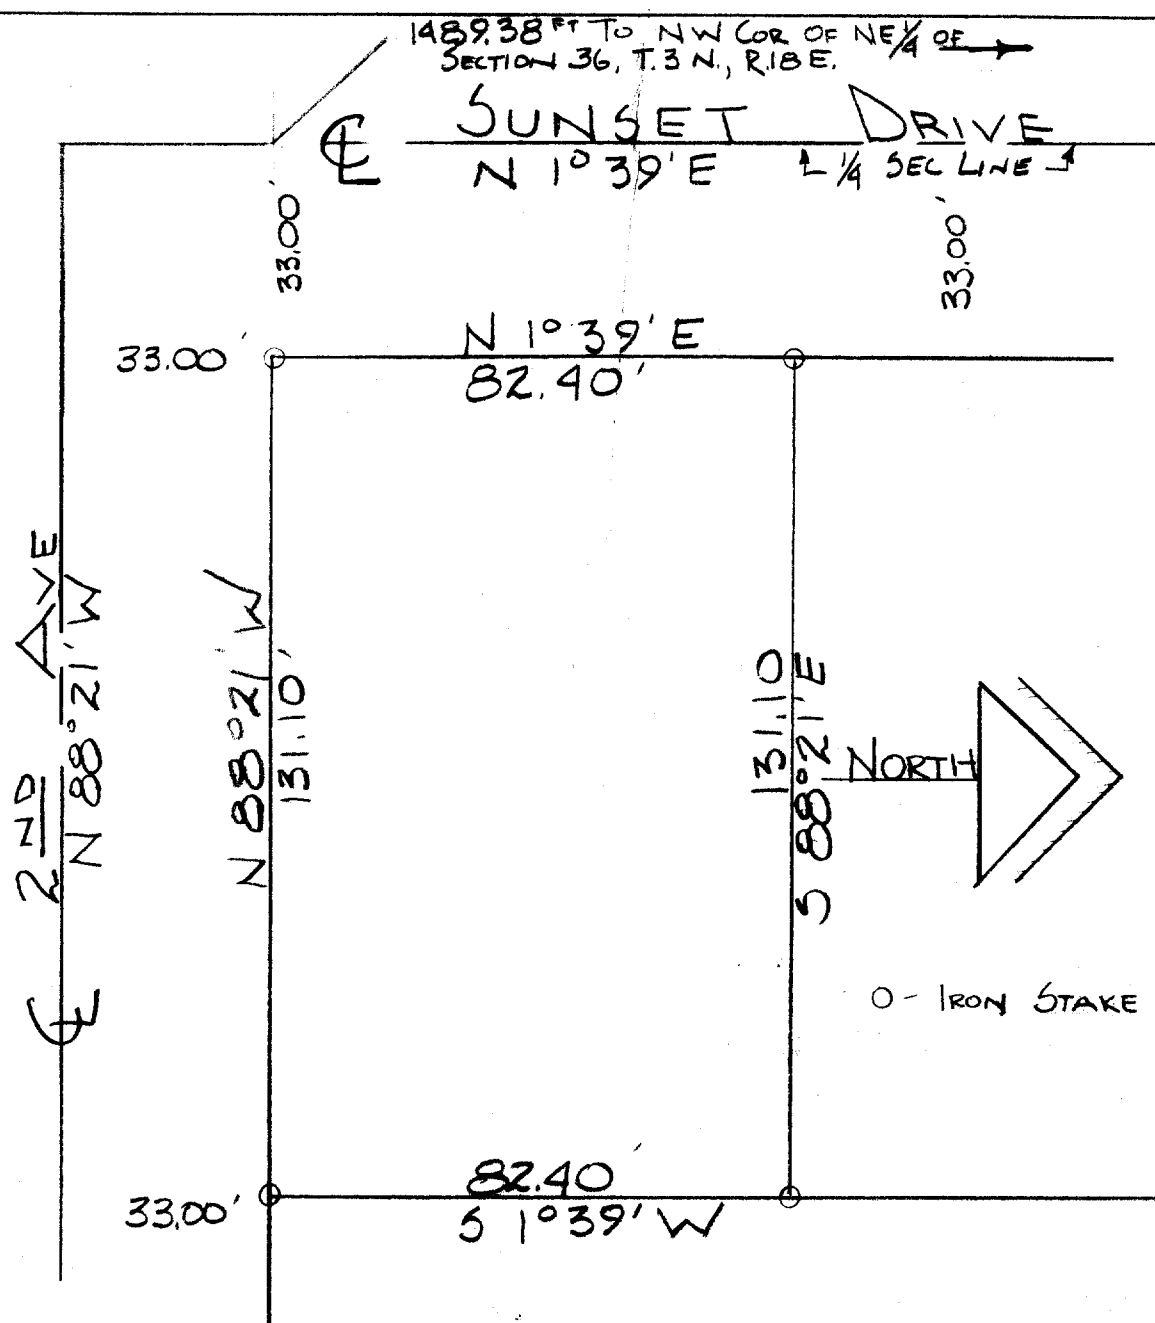


DESCRIPTION: Commencing at the intersection of the East line of Sunset Drive and the North line of 2nd. Ave. in the City of Elkhorn, Walworth County, Wisconsin, thence N 1° 39' E. 82.40 feet to an iron stake, thence S 88° 21' E 131.10 feet to an iron stake, thence S 1° 39' W. 82.40 feet to an iron stake, thence N. 88° 21' W. 131.10 feet to the place of beginning.

CERTIFICATE: I, James F. Biagi hereby certify that I have surveyed the property hereon described and that the measurements and bearings of the boundaries are as shown on the plat.

August 31, 1960

James F. Biagi
James F. Biagi RLS

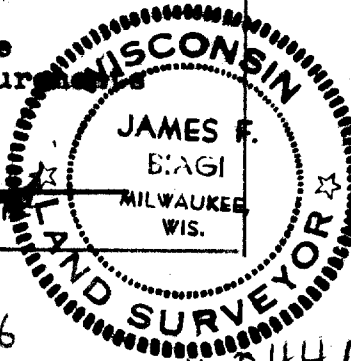

UNW-46

NE 1/4 - 36-3-16

344 R