


PREPARED FOR
TERRI ADLER
108 S. CHURCH ST
ELKHORN, WI. 53121

PLAT OF SURVEY

- OF -

PATHFINDER SURVEYING INC.
(formerly)
J.K. SURVEYING INC.
P.O BOX 322
LAKE GENEVA, WI. 53147
WWW.PATHFINDERSURVEYING.NET
262-248-8303

LOT 4, BLOCK 29, LOT 3 BLOCK 29 EXCEPT THE WEST 62.50 FEET, ALSO EXCEPTING THE EAST 62.5 FEET
OF THE WEST 125 FEET OF THE SOUTH 30 FEET, ROCKWELL'S ADDITION, LOCATED IN PART OF THE NE 1/4
OF SECTION 1, TOWN 2 NORTH, RANGE 16 EAST, CITY OF ELKHORN, COUNTY OF WALWORTH AND
STATE OF WISCONSIN.

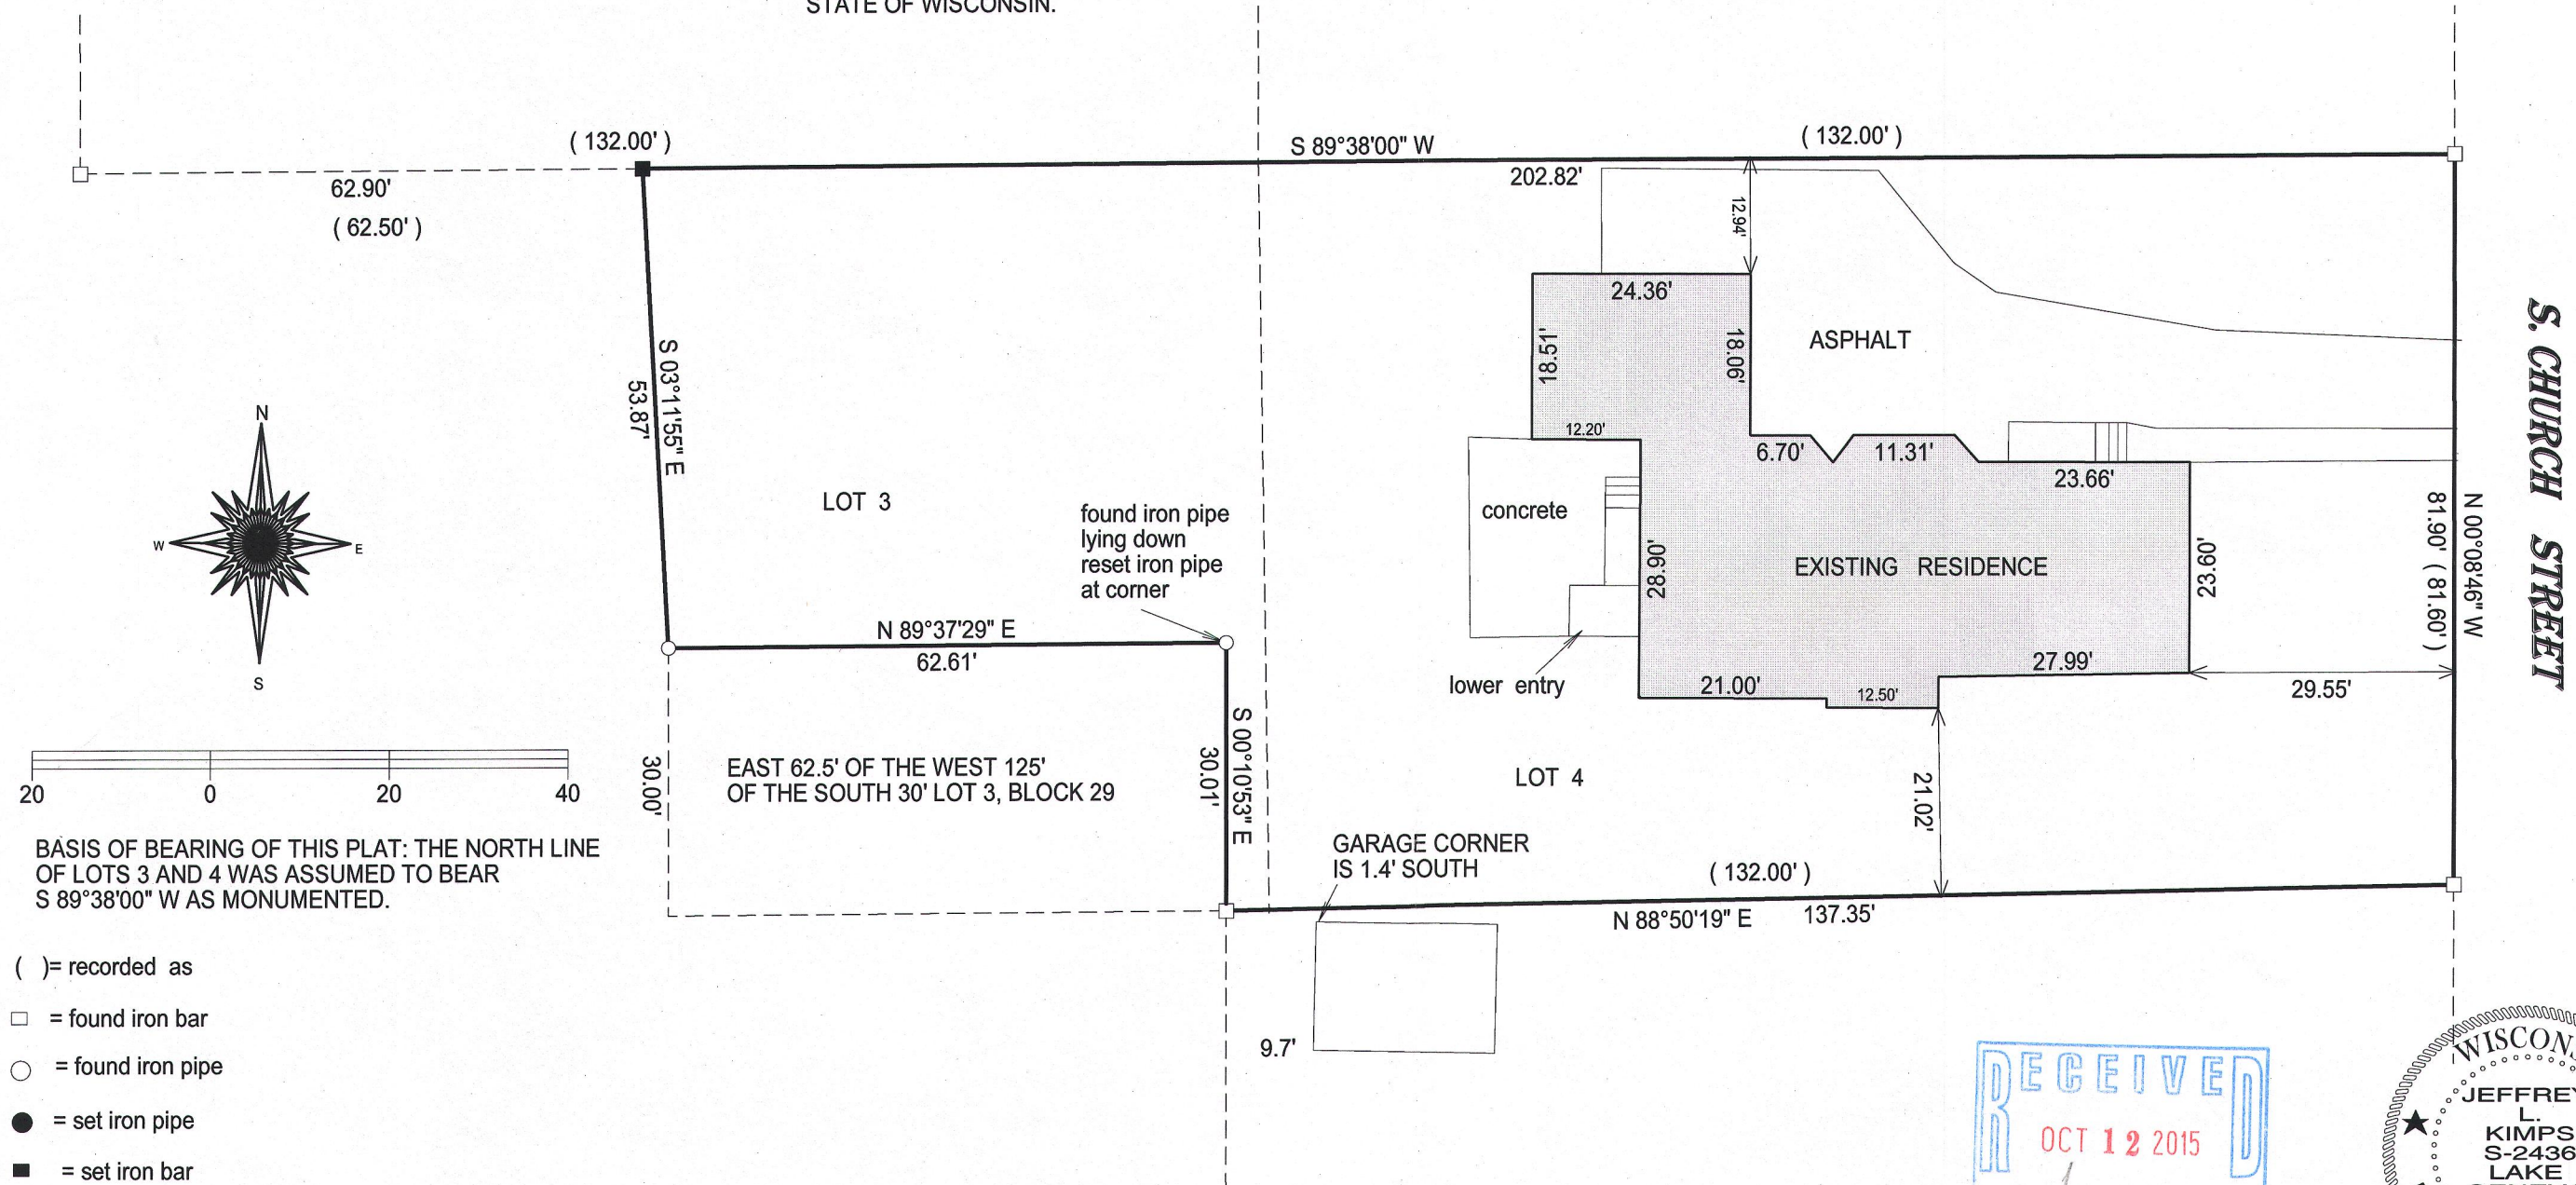

BASIS OF BEARING OF THIS PLAT: THE NORTH LINE
OF LOTS 3 AND 4 WAS ASSUMED TO BEAR
S 89°38'00" W AS MONUMENTED.

- () = recorded as
- = found iron bar
- = found iron pipe
- = set iron pipe
- = set iron bar

SCALE 1" = 20'



JOB # 15-178

TAX ID # YRW00031

"I hereby certify that I have surveyed the above described property and that the above
map is a true representation of its exterior boundary and shows the size and location of
all visible structures, apparent easements and encroachments if any."

This survey is made for the present owners of the property, and those who
purchase, mortgage, or guarantee the title thereto, within one year from
the date hereof.

DATED THIS 12TH DAY OF JUNE, 2015.

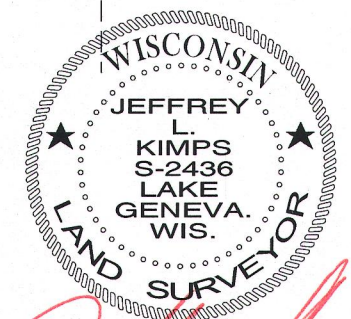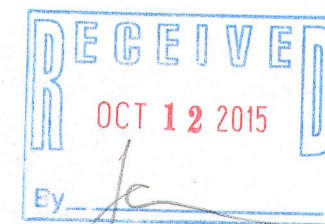

JEFFREY L. KIMPS S-2436
Wisconsin Professional Land Surveyor
(original if signed in red)

YRW-31

004-2477