


ENGINEERING — ARCHITECTURE — SURVEYING
7 RIDGWAY COURT — P.O. BOX 437 — ELKHORN, WISCONSIN 53121
PHONE: (262) 723-2098 FAX: (262) 723-5886

PLAT OF SURVEY

LOT 156 OF ELKHORN WEST ADDITION NO. 2

LOCATED IN PART OF THE NE 1/4 OF THE SE 1/4 OF SECTION 35
TOWN 3 NORTH, RANGE 16 EAST, CITY OF ELKHORN, WALWORTH COUNTY, WISCONSIN

**SUBDIVISION PLAT
BEARING BASIS**

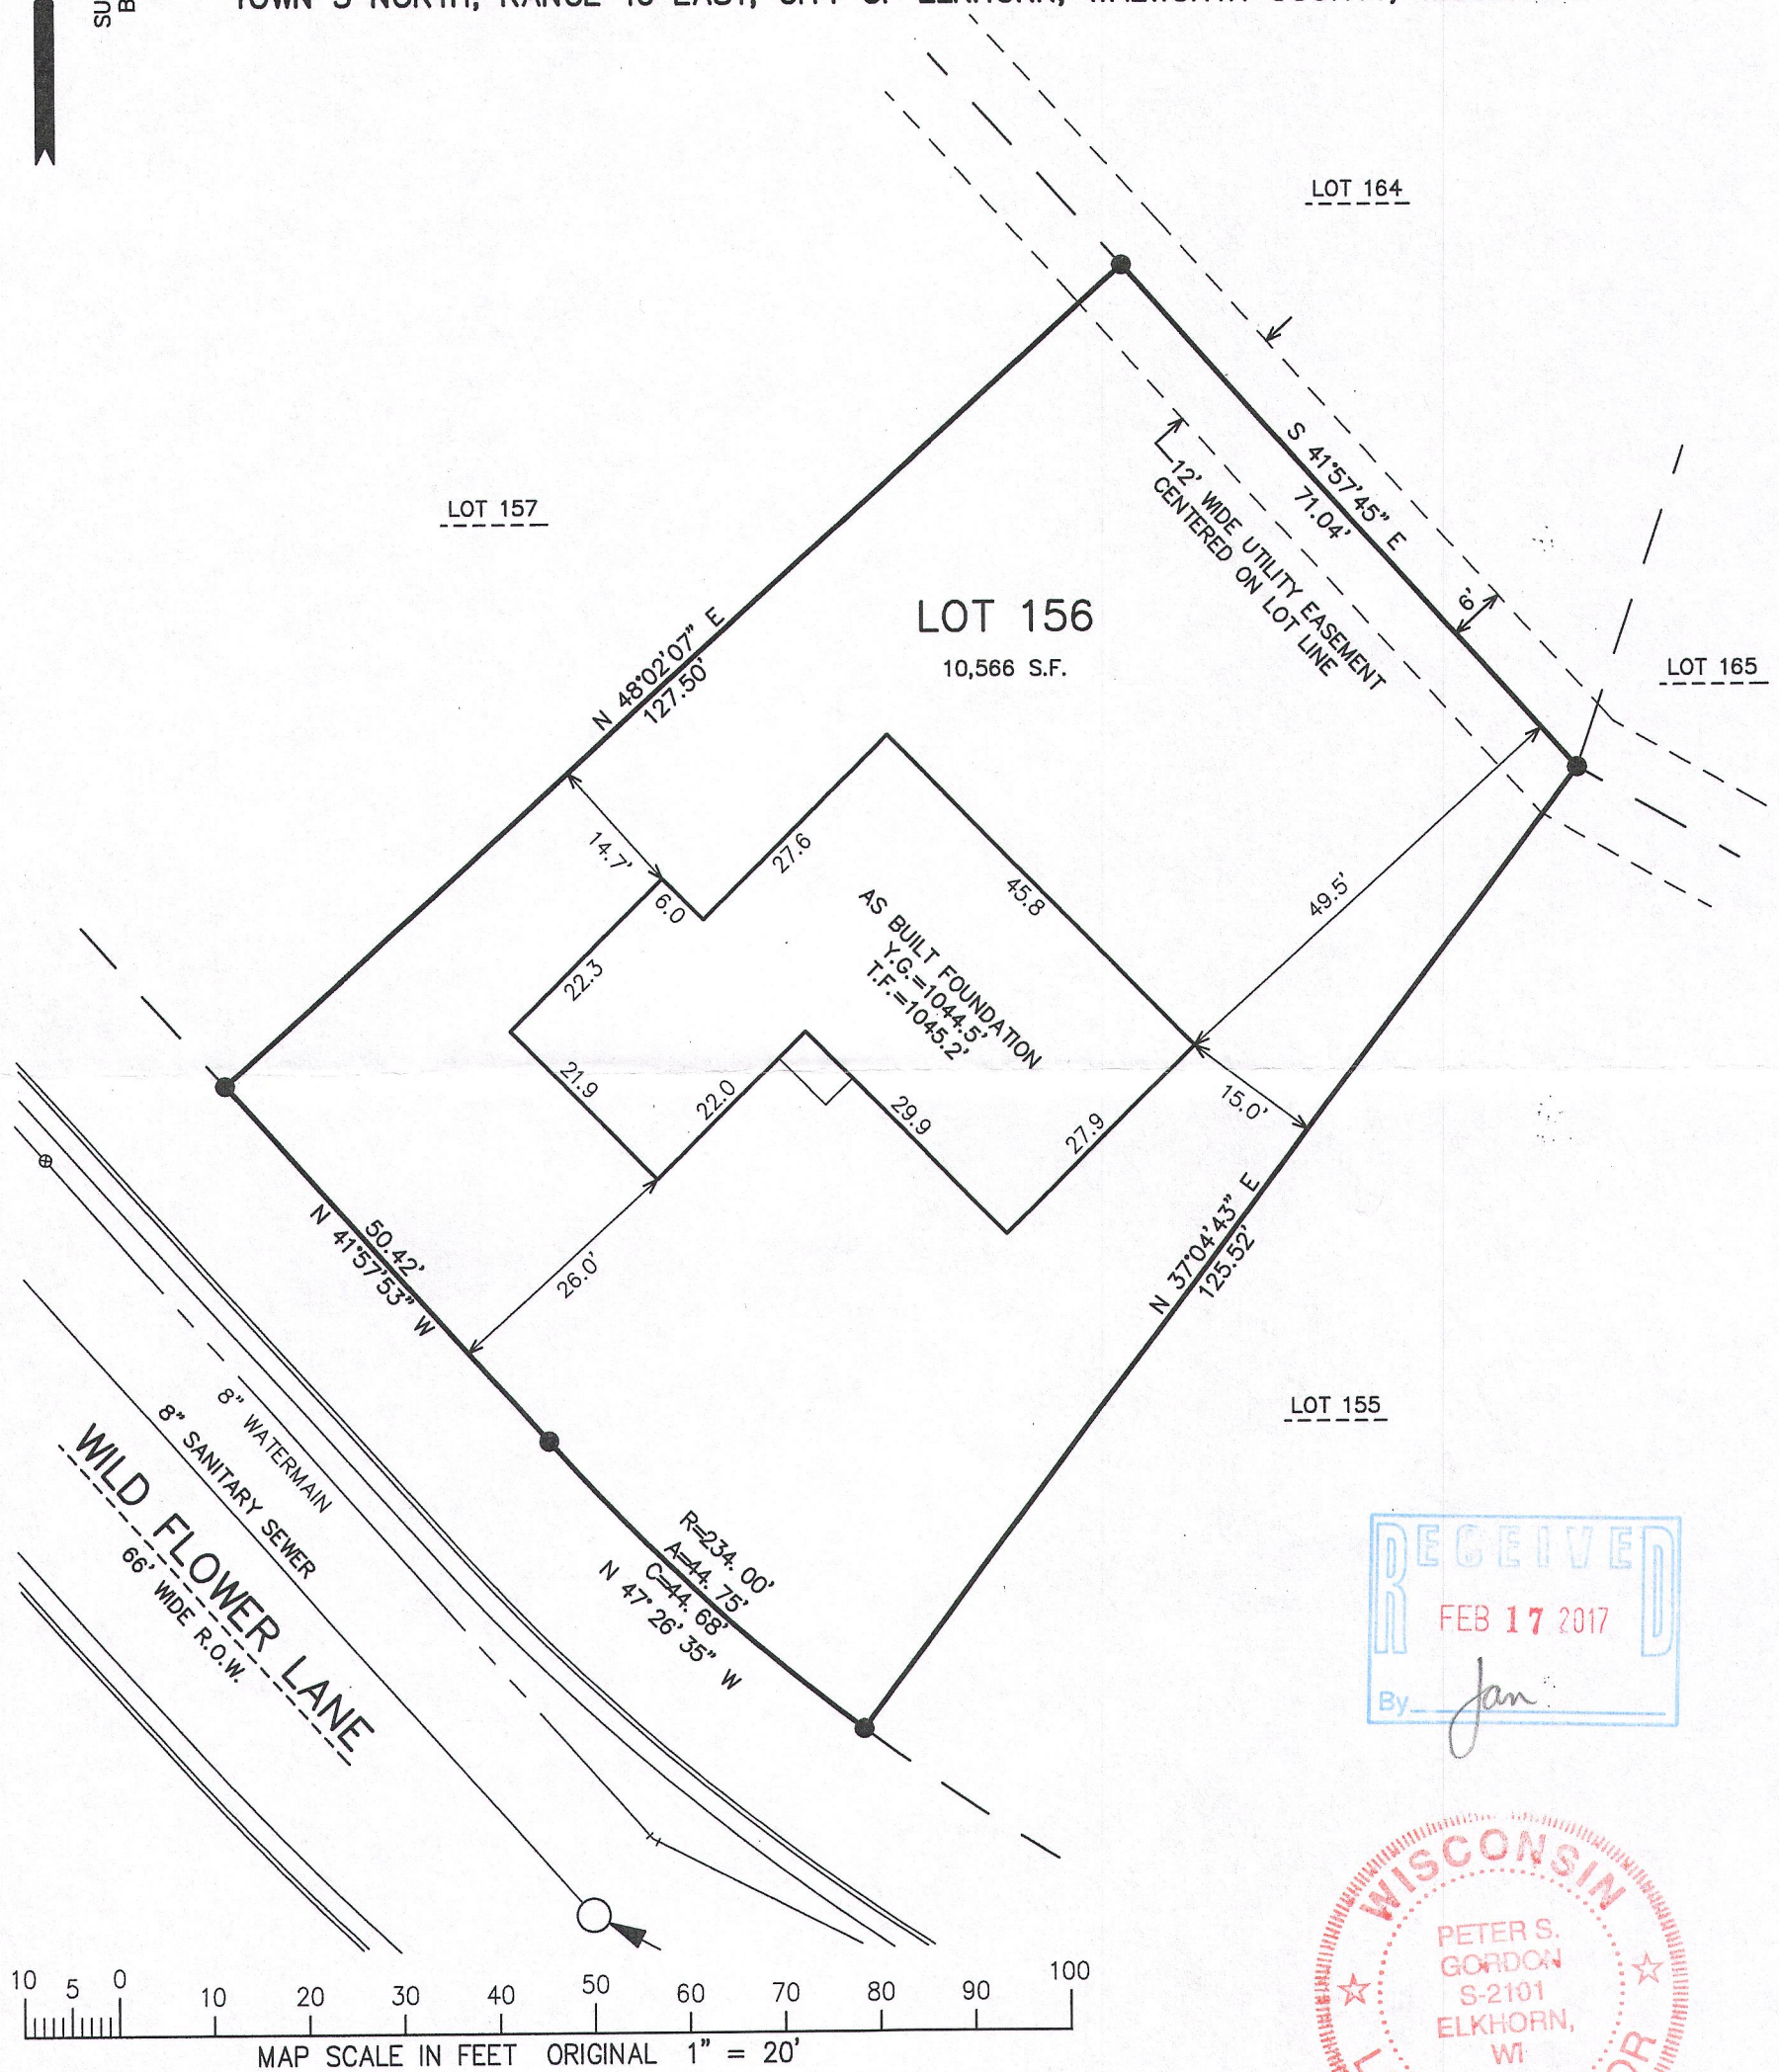

RECEIVED
FEB 17 2017
By *Jan*

NOTE: COPIES OF THIS MAP TO WHICH THE FOLLOWING CERTIFICATE WILL APPLY SHOW THE SURVEYOR'S ORIGINAL SEAL AND SIGNATURE IN RED INK. COPIES BY ANY OTHER MEANS MAY HAVE ALTERATIONS WHICH DO NOT REPRESENT THE SURVEYOR'S WORK PRODUCT.

I HEREBY CERTIFY THAT THE ABOVE DESCRIBED PROPERTY HAS BEEN SURVEYED UNDER MY DIRECTION AND THAT THE ABOVE MAP IS A TRUE REPRESENTATION THEREOF AND SHOWS THE SIZE AND LOCATION OF THE PROPERTY AND ITS EXTERIOR BOUNDARIES. THIS SURVEY IS MADE FOR THE USE OF THE PRESENT OWNERS OF THE PROPERTY, AND ALSO THOSE WHO PURCHASE, MORTGAGE, OR GUARANTEE THE TITLE THERETO WITHIN ONE YEAR FROM THE DATE HEREOF.

DATED: SEPTEMBER 16, 2005

REVISED 01-16-2017
TO SHOW SIZE & LOCATION OF
PROPOSED RESIDENCE

REVISED 02-07-2017
TO SHOW SIZE & LOCATION OF
AS BUILT FOUNDATION

● = SET IRON REBAR STAKE
 ○ = FOUND IRON PIPE STAKE

(XXX) = RECORDED AS

Y.G.=YARD GRADE
T.F.=TOP OF FOUNDATION GRADE
G.E.=GARAGE ENTRY GRADE

PROJECT: 6103.02.156
DATE: 09/16/2005
SHEET 1 OF 1

2/7/2017 X:\Projects\6103\ADD_2_INDV_LOTS\Lot_156\PERMIT156

2/7/2017

PETER S. GORDON R.L.S. 2101

FEB 07 2017

YEW 2-156

004-2582