


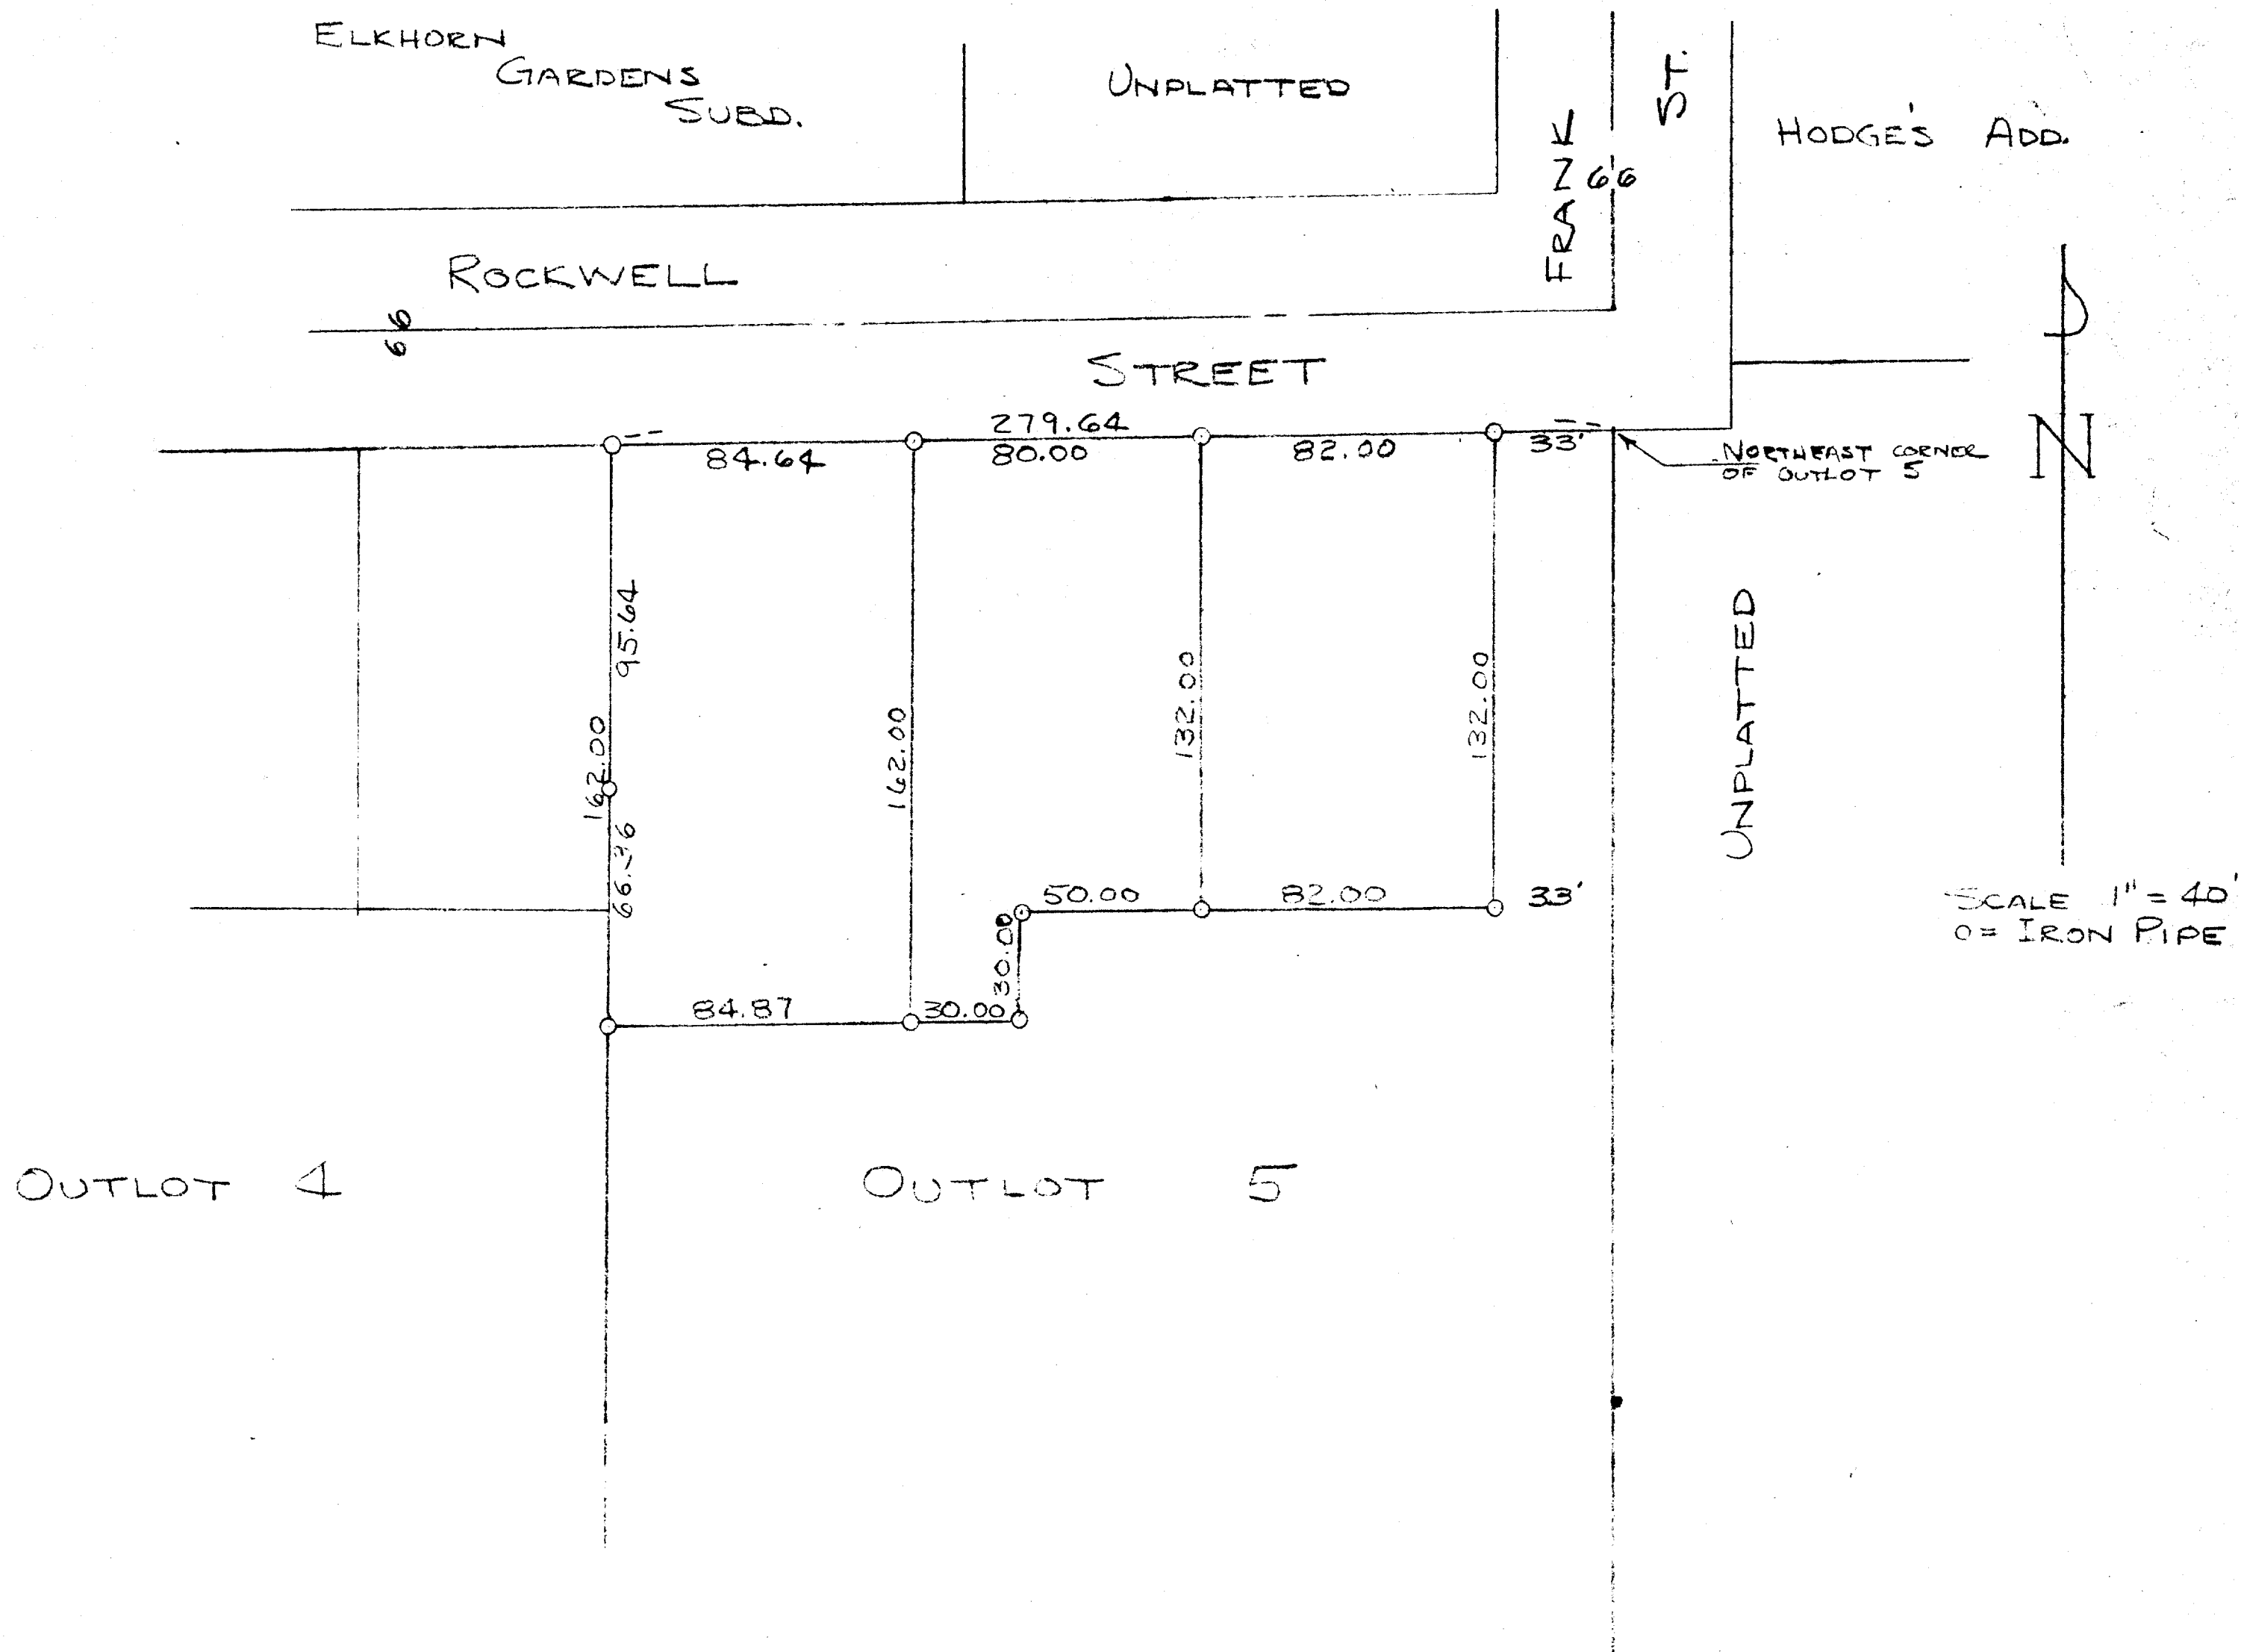

PLAT OF SURVEY OF PART OF OUTLOT 5 OF
DEVENDORF, MALLORY, AND SPENCER'S ADD-
ITION TO THE CITY OF ELKHORN, WALWORTH
COUNTY WISCONSIN.

OCTOBER 1950

Lloyd L. Jensen
COUNTY SURVEYOR