
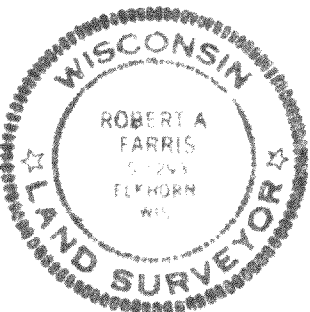


MORTGAGE INSPECTION SURVEY

NOTE: This is not a "Property Survey" as defined in Section AE-5.01 of the Wisconsin Administrative Code.

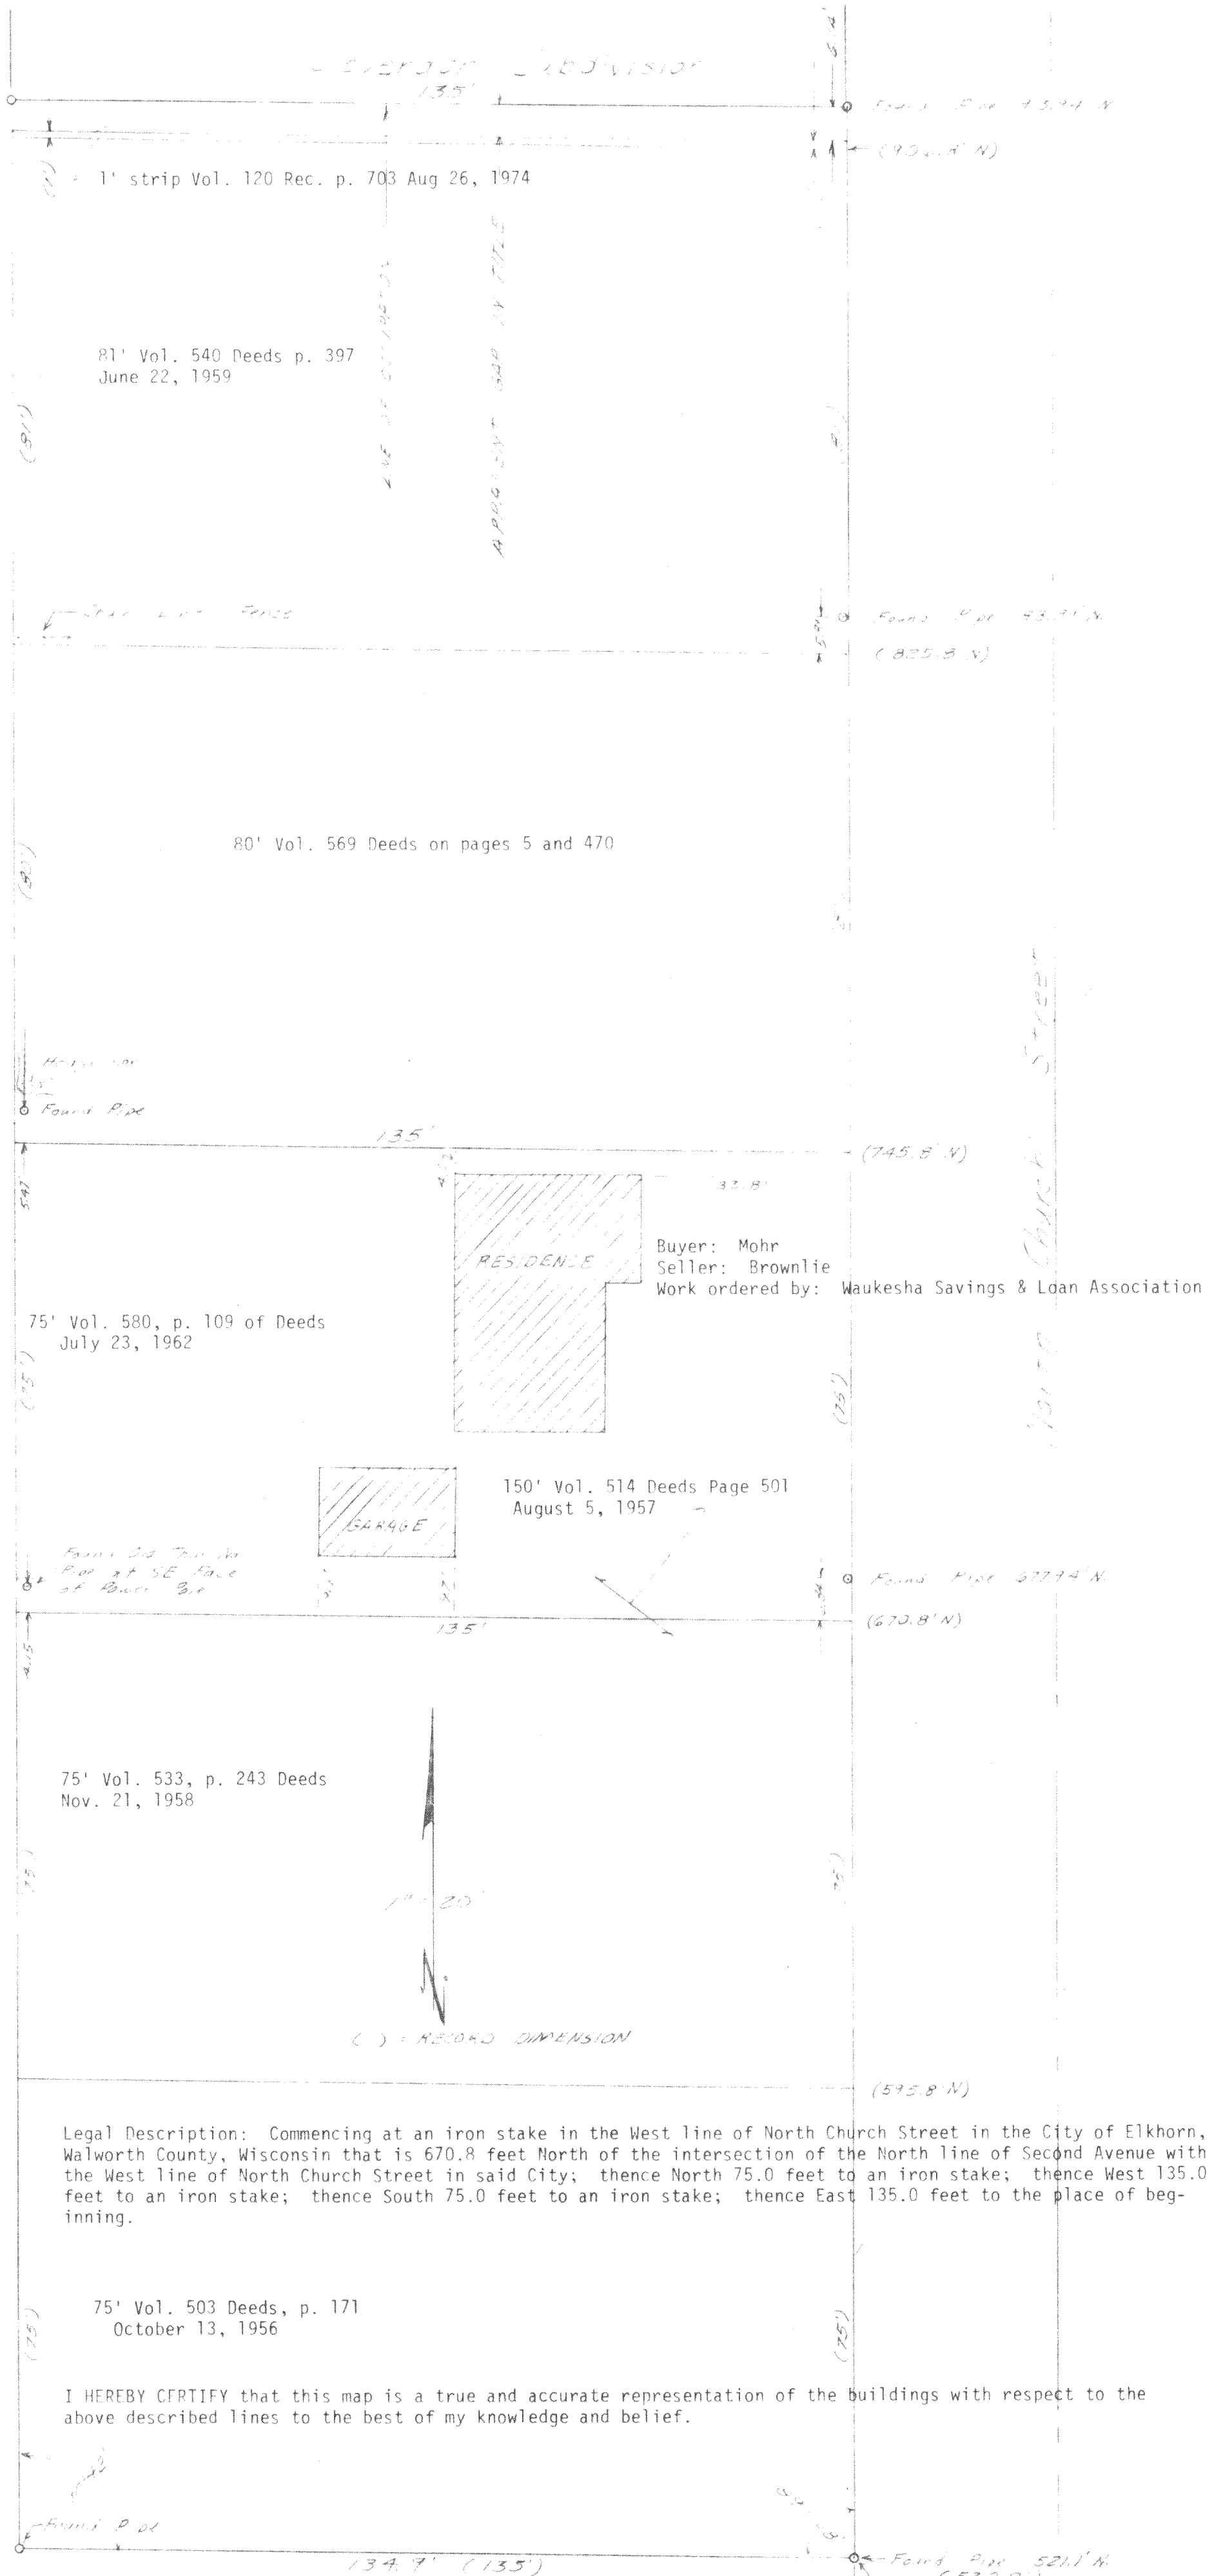

Estate Court
CSM 780

FARRIS, HANSEN & COOPER, INC.

715 W. WALWORTH AVE. P.O. BOX 487
ELKHORN, WISCONSIN 53121
TELEPHONE 434-7242/2180

DRAWING NO. 1403

Robert A. Farris
ROBERT A. FARRIS RLS
DATED THIS 12 DAY OF SEP 1970