


DUNHAM SURVEYING, S.C.
SURVEYING & SUBDIVIDING
DELAVER, WISCONSIN 53115

N

Scale - 1" = 20'
▲ = Iron Pipe Found
○ = Iron Pipe Set
X = Cross in Concrete Drive
--- = Fence line

CHURCH

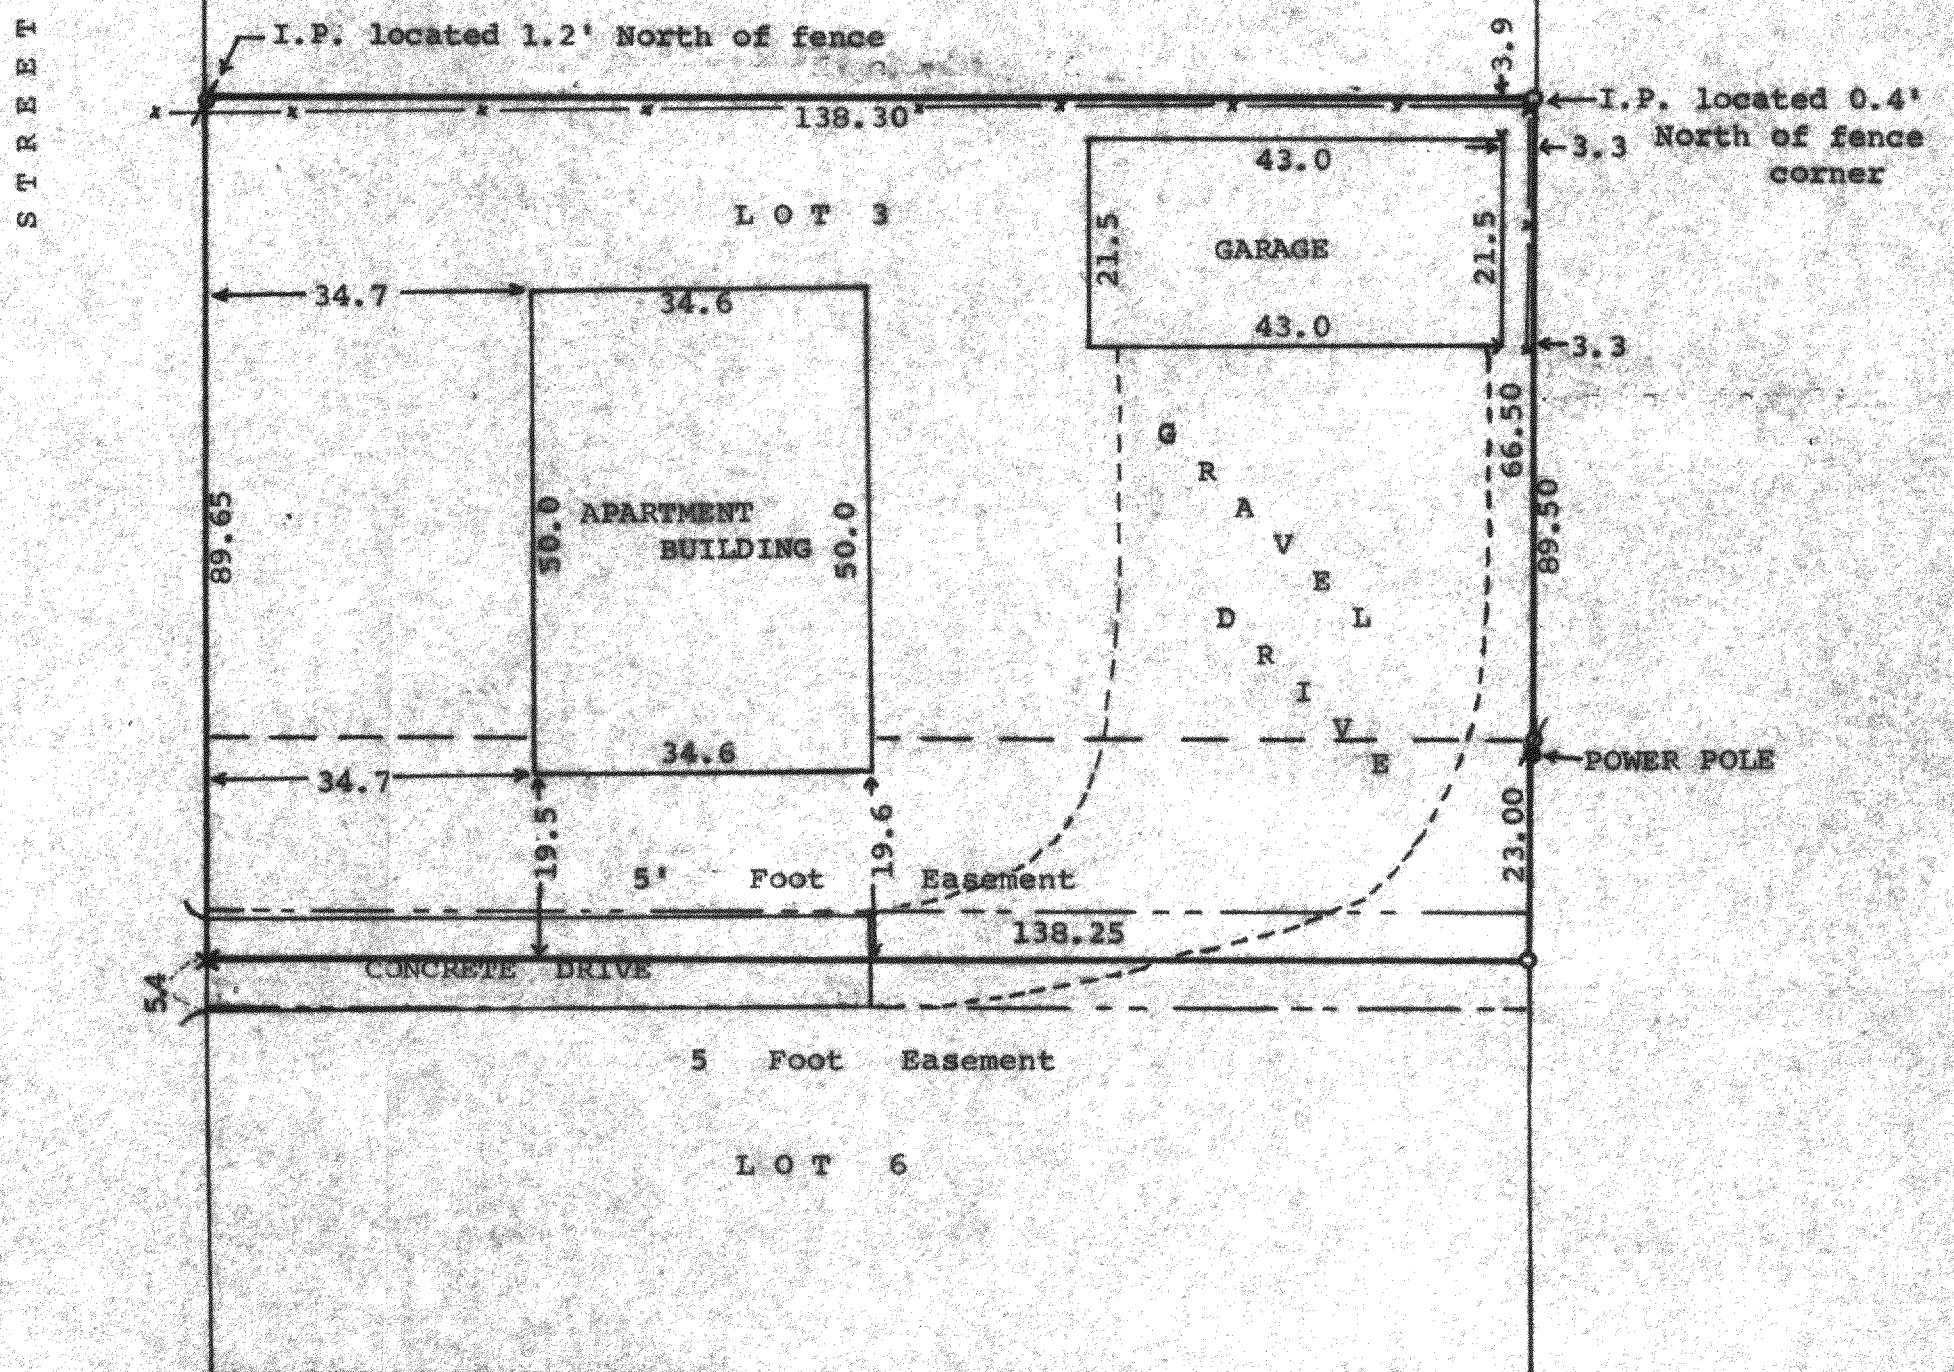

STATE OF WISCONSIN)
COUNTY OF WALWORTH)

I, James M. Dunham, Surveyor, certify that I have surveyed the property described as follows,

Lot 3, Block 1, Rockwell Brother's Addition to the City of Elkhorn, according to the recorded plat thereof and Lot 6 in said Block 1 except the South 43 feet of said Lot 6, all in the City of Elkhorn, Walworth County, Wisconsin, subject to an easement over and across the South 5.00 feet of the above described parcel of land. ALSO an easement is granted over and across the North 5.00 feet of the South 43.00 feet of Lot 6, Block 1 of Rockwell Brother's Addition to the City of Elkhorn, Walworth County, Wisconsin.

and the above map is a true representation thereof and shows the size and location of the property, its exterior boundaries, the location and dimensions of all structures thereon, fences, apparent easements and roadways and visible encroachments, if any.

This survey is made for the exclusive use of the present owners of the property, and also those who purchase, mortgage, or guarantee the title thereto within one (1) year from date hereof; and as to them I warrant the accuracy of said survey and map.

June 26, 1978

James M. Dunham
James M. Dunham, Surveyor

